
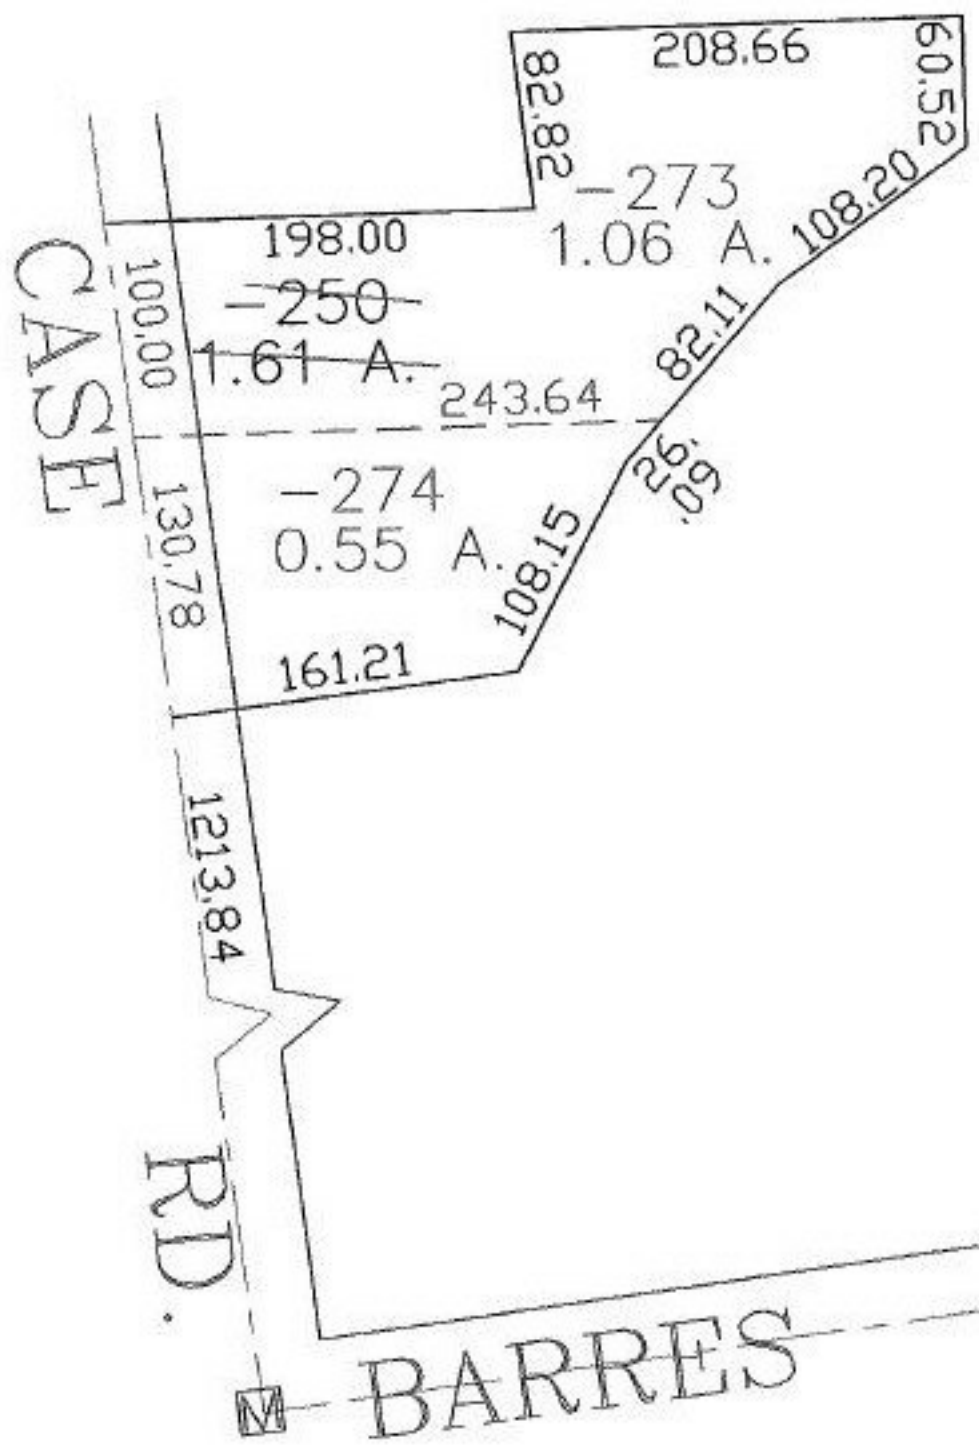


PARENT PARCEL: 07-00-043-000-250

CHILD PARCEL: 07-00-043-000-273, -274

STARTING POINT: CENTERLINE OF CASE RD. & BARRES RD.

NO. 00878

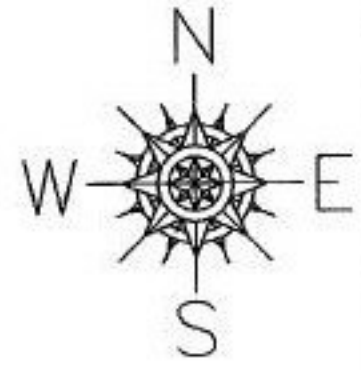

**SPLITS/DEEDS PROCESSED**  
 LORAIN COUNTY TAX MAP DEPARTMENT  
 226 MIDDLE AVE. ELYRIA, OHIO

SURVEYED BY: MARK A. YEAGER  
 CLOSURE: 0.00 : 10.000  
 MAP PAGE(S): 7-00-043-C  
 APPROVED BY: JAH DATE: 9-26-01  
 SCALE: 1" = 100' PRIOR INSTRUMENT: PLAT VOL. 68/35