


RASTER


PARENT PARCEL: 06-24-048-000-011, 06-24-043-101-008
CHILD PARCEL: 06-24-048-000-033, -034 06-24-043-101-018, -019
STARTING POINT: CENTERLINE OF MURRAY RIDGE RD. & O.L. 43

NO. 00880

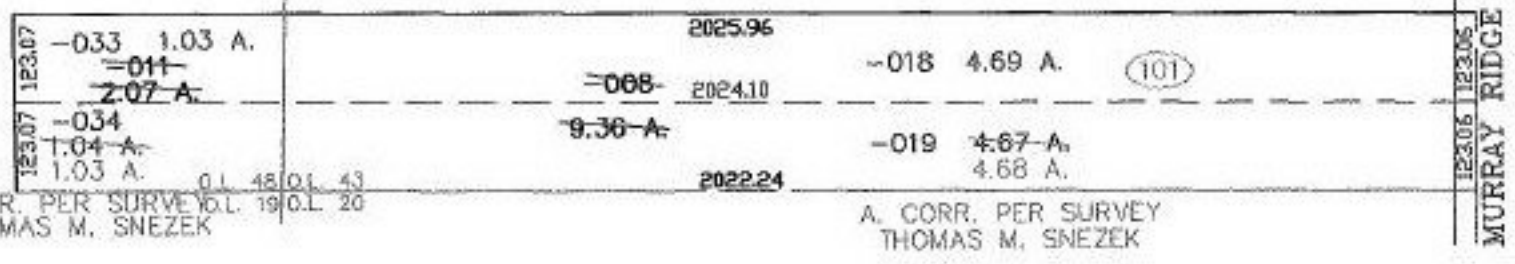

A. CORR. PER SURVEY O.L. 19 O.L. 20
THOMAS M. SNEZEK

A. CORR. PER SURVEY
THOMAS M. SNEZEK

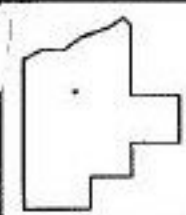

SPLITS/DEEDS PROCESSED
LORAIN COUNTY TAX MAP DEPARTMENT
226 MIDDLE AVE. ELYRIA, OHIO

SURVEYED BY: THOMAS M. SNEZEK
CLOSURE: 0.00 : 10,000
MAP PAGE(S): 6-56, 6-57
APPROVED BY: JAH DATE: 9-26-01
SCALE: 1" = 300' PRIOR INSTRUMENT: OR 389/669