



MASTER

PARENT PARCEL: 10-00-018-101-007

CHILD PARCEL: 10-00-018-101-039, -040

STARTING POINT: CENTERLINE OF LATTASBURG & SLIFE RD.

NO. 00891

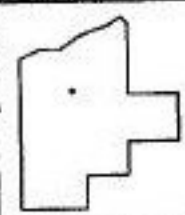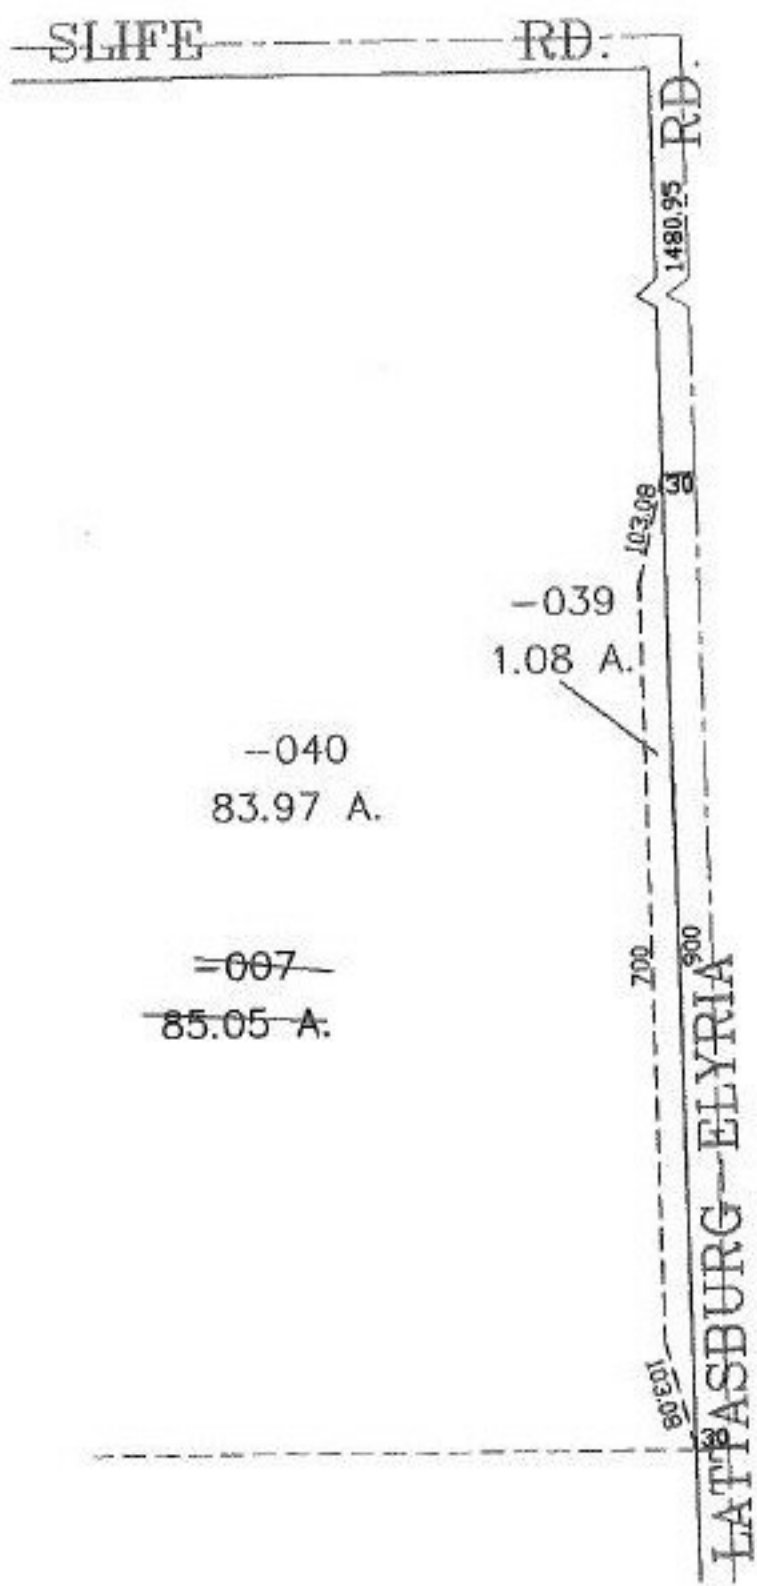

SPLITS/DEEDS PROCESSED
 LORAIN COUNTY TAX MAP DEPARTMENT
 226 MIDDLE AVE. ELYRIA, OHIO

SURVEYED BY: THOMAS L. SEITZ
 CLOSURE: 0.00 : 10.000
 MAP PAGE(S): 10-F
 APPROVED BY: JAH DATE: 10-8-01
 SCALE: 1" = 200 PRIOR INSTRUMENT: 990641818