



MASTER

PARENT PARCEL: 13-11-018-000-013, 13-11-023-000-018

CHILD PARCEL: 13-11-018-000-014, -015

STARTING POINT: CENTERLINE OF BAIRD RD. & O.L. 18

NO. 00892

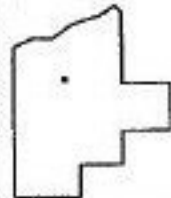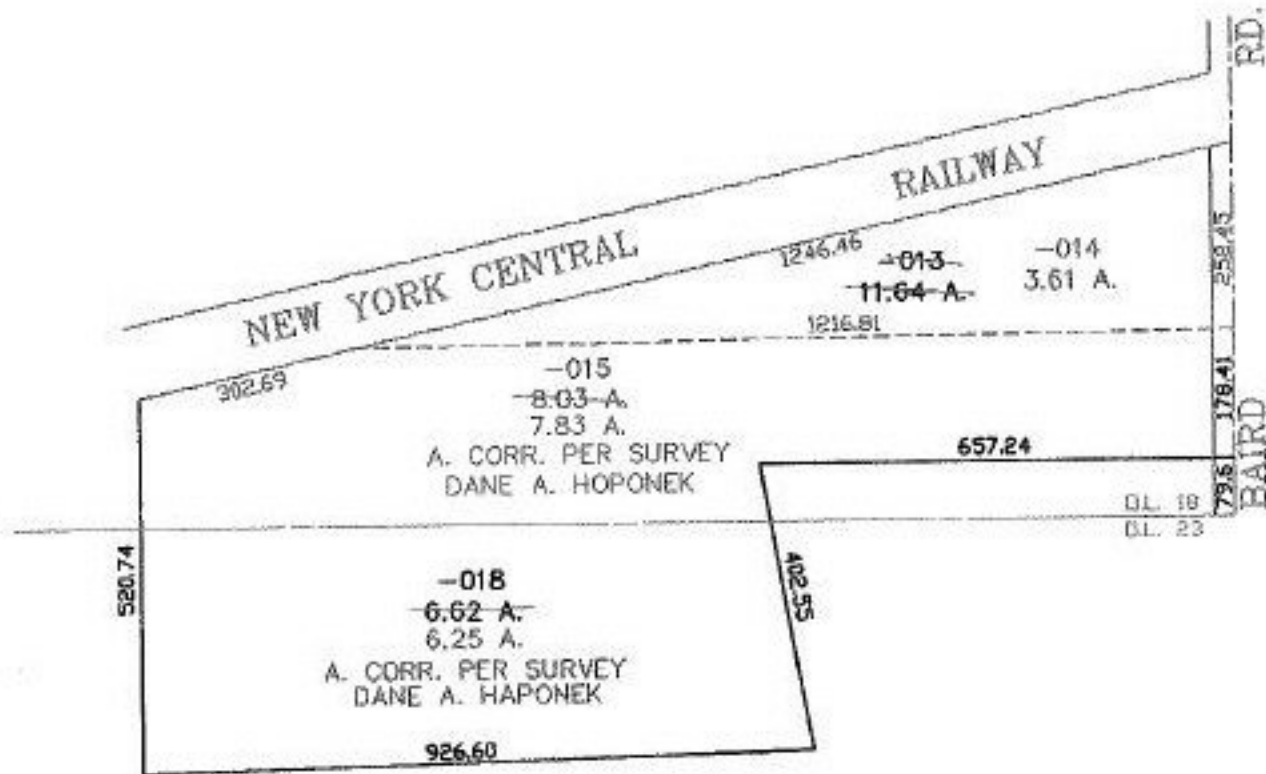

SPLITS/DEEDS PROCESSED
 LORAIN COUNTY TAX MAP DEPARTMENT
 226 MIDDLE AVE. ELYRIA, OHIO

SURVEYED BY: DANE A. HAPONEK
 CLOSURE: 0.00 : 10.000
 MAP PAGE(S): 13-B
 APPROVED BY: JAH DATE: 10-10-01
 SCALE: 1" = 300' PRIOR INSTRUMENT: OR 950/417