


MASTER

PARENT PARCEL: 04-00-028-102-040

CHILD PARCEL: 04-00-028-102-090 THRU -093

STARTING POINT: NORTHEAST CORNER OFS/L 1 OF AVON OAKS SUBD.

NO. 00893

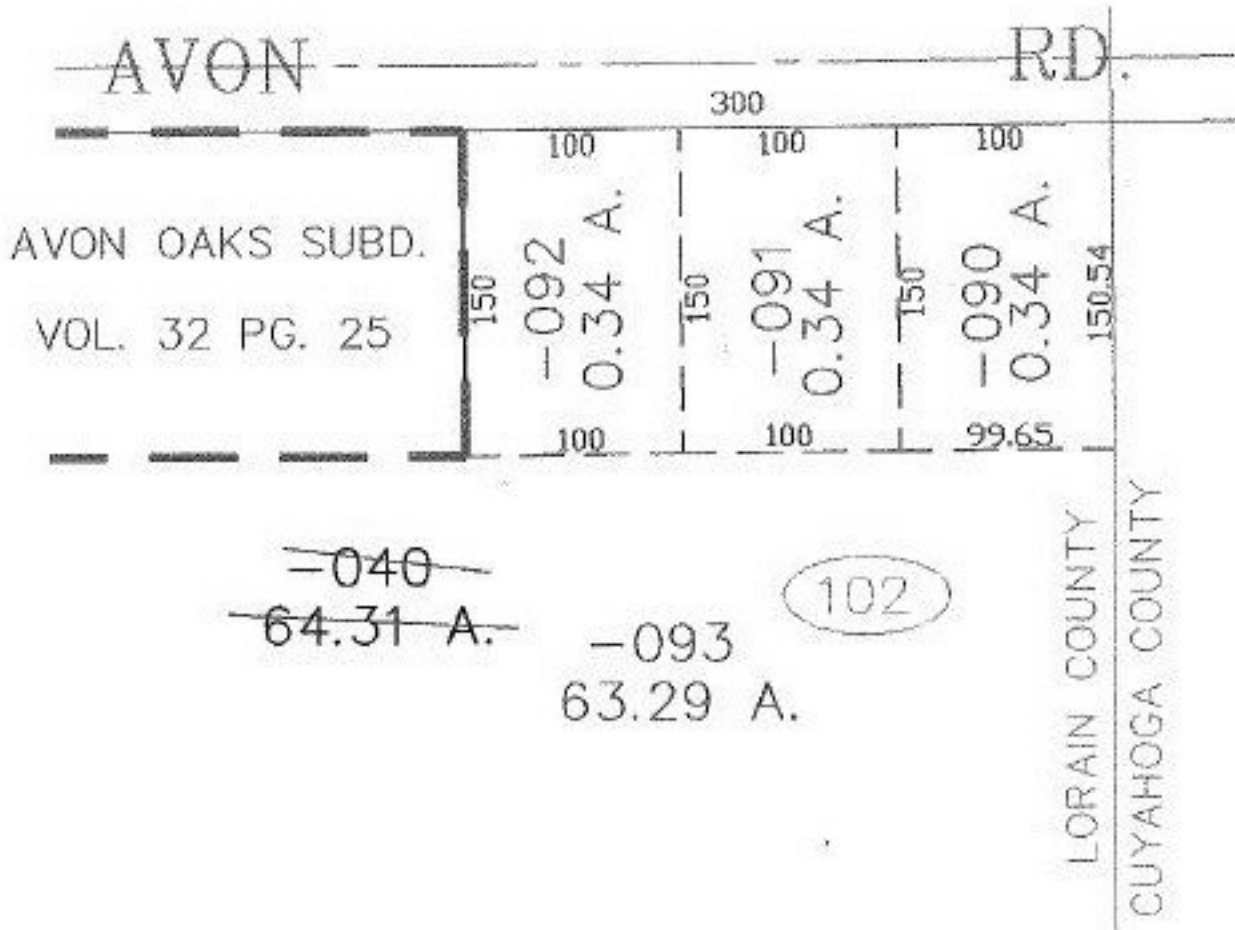

SPLITS/DEEDS PROCESSED

LORAIN COUNTY TAX MAP DEPARTMENT
226 MIDDLE AVE. ELYRIA, OHIO

SURVEYED BY: DONALD E. HIMES

CLOSURE: 0.00 : 10.000

MAP PAGE(S): 04-00-028-G, H

APPROVED BY: JAH DATE: 10-11-01

SCALE: 1" = 100' PRIOR INSTRUMENT: DV 849/686