


FASTER

PARENT PARCEL: 07-00-017-130-005

CHILD PARCEL: 07-00-017-130-006, -007

STARTING POINT: CENTERLINE OF CENTER RIDGE RD. & O.L. 17

NO. 00899

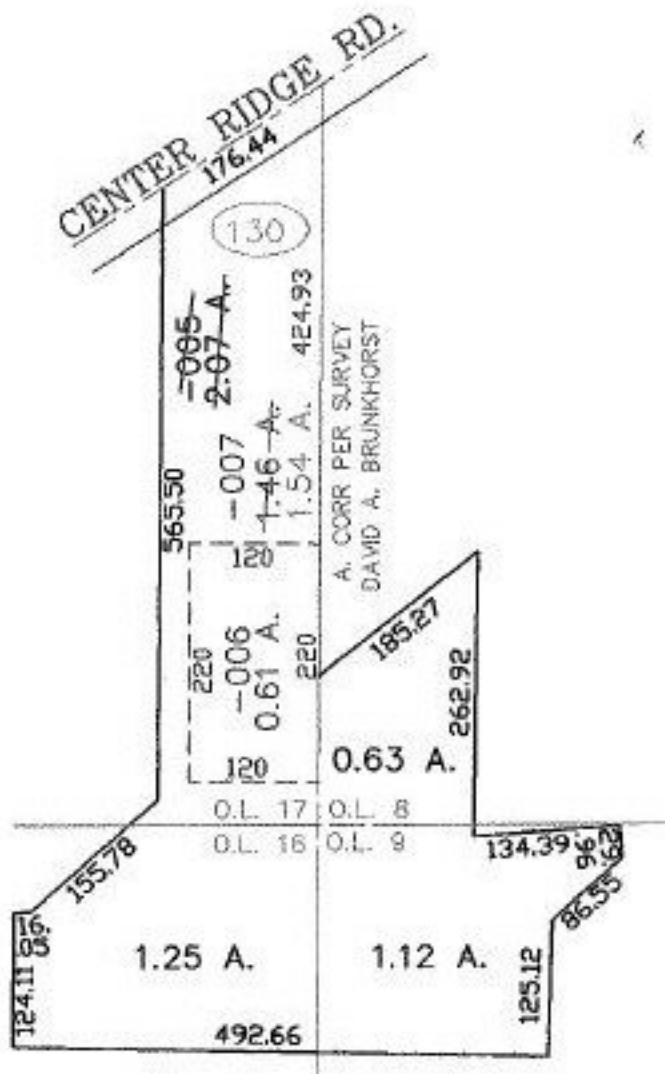

**SPLITS/DEEDS PROCESSED**  
**LORAIN COUNTY TAX MAP DEPARTMENT**  
 226 MIDDLE AVE. ELYRIA, OHIO

SURVEYED BY: DAVID BRUNKHORST  
 CLOSURE: 0.01 : 10.000  
 MAP PAGE(S): 7-00-017-D  
 APPROVED BY: JAH DATE: 12-1-01  
 SCALE: 1" = 200' PRIOR INSTRUMENT: OR 1245/553