


PARENT PARCEL: 07-00-044-101-005, -006
CHILD PARCEL: 07-00-044-101-009 THRU -013
STARTING POINT: CENTERLINE OF BURNS & CASE RD.

NO. 00900

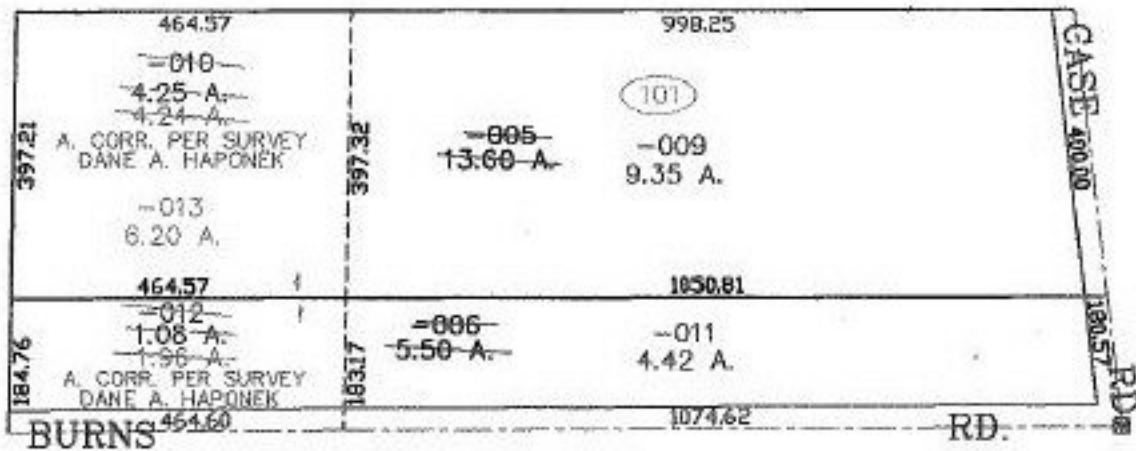

SPLITS/DEEDS PROCESSED
LORAIN COUNTY TAX MAP DEPARTMENT
226 MIDDLE AVE. ELYRIA, OHIO

SURVEYED BY: DANE A HAPONEK
CLOSURE: 0.00 : 10.000
MAP PAGE(S): 7-00-044-A
APPROVED BY: JAH DATE: 10-25-01
SCALE: 1" = 300 PRIOR INSTRUMENT: OR 635/553