
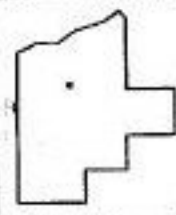


EASTER

PARENT PARCEL: 11-00-020-000-017  
CHILD PARCEL: 11-00-020-000-025, -026, -027  
STARTING POINT: CENTERLINE OF COWLEY RD. & O.L. 20

NO. 00904

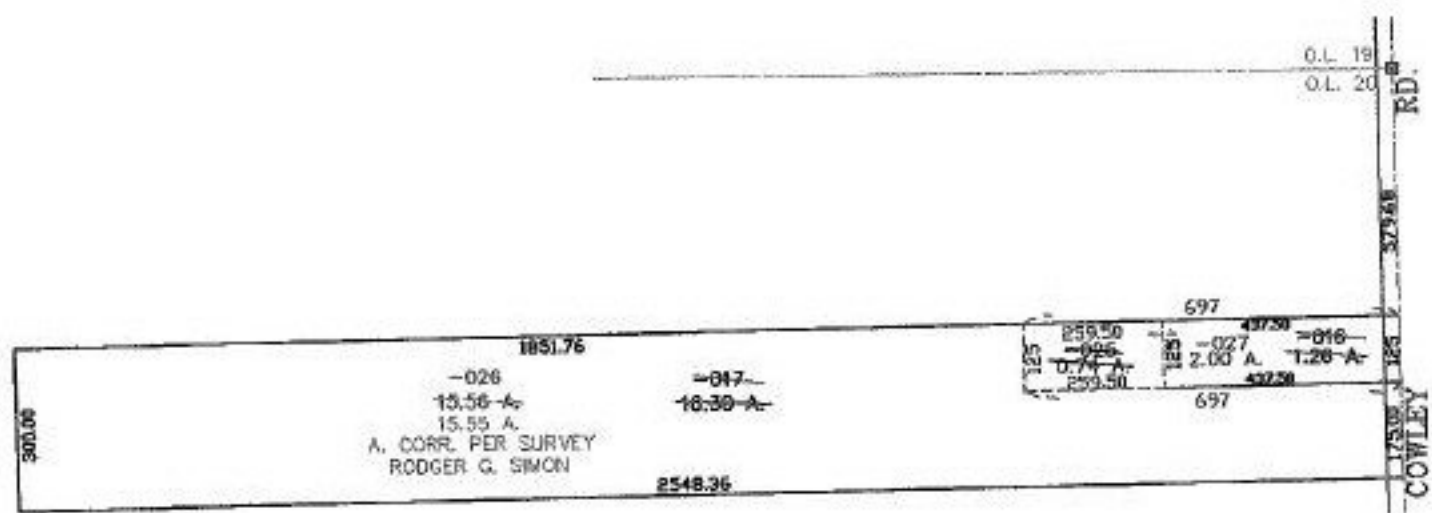

**SPLITS/DEEDS PROCESSED**  
LORAIN COUNTY TAX MAP DEPARTMENT  
226 MIDDLE AVE. ELYRIA, OHIO

SURVEYED BY: RODGER G. SIMON  
CLOSURE: 0.00 : 10.000  
MAP PAGE(S): 11-00-020-B  
APPROVED BY: JAH DATE: 10-29-01  
SCALE: 1" = 400' PRIOR INSTRUMENT: 2000689205