


MASTER

PARENT PARCEL: 10-00-006-101-024, 10-00-007-103-014


CHILD PARCEL: 10-00-006-101-025, -026

STARTING POINT: CENTERLINE OF GRAFTON RD. & MARDUN CT.

NO. 00912

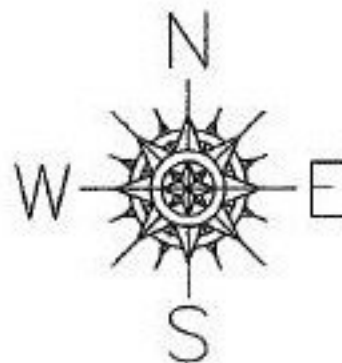

R. MARDUN CT.
GRAFTON

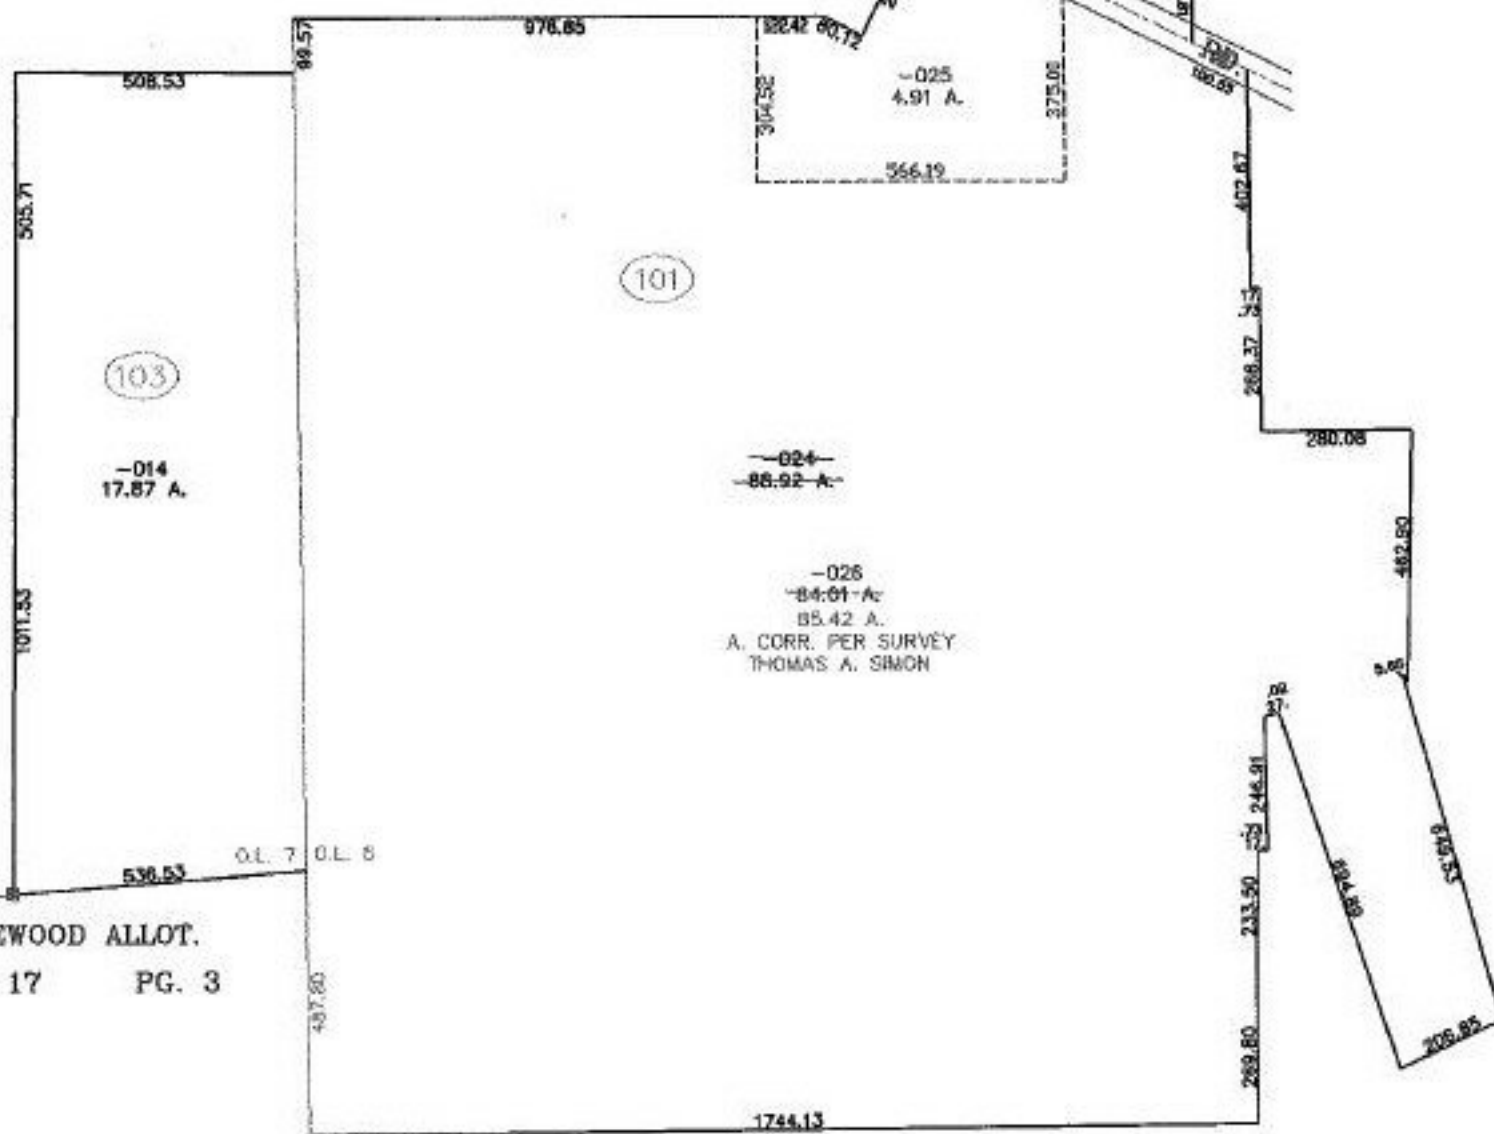

RIDGEWOOD ALLOT.
VOL. 17 PG. 3

A. CORR. PER SURVEY
THOMAS A. SIMON



SPLITS/DEEDS PROCESSED
LORAIN COUNTY TAX MAP DEPARTMENT
226 MIDDLE AVE. ELYRIA, OHIO

SURVEYED BY: THOMAS A. SIMON
CLOSURE: 0.00 : 10.000
MAP PAGE(S): 10-006-A, 8 10-00-007-D
APPROVED BY: JAH DATE: 11-15-01
SCALE: 1" = 400' PRIOR INSTRUMENT: DV 546/189