


PARENT PARCEL: 04-00-019-144-269


CHILD PARCEL: 04-00-019-144-355, -356

STARTING POINT: CENTERLINE OF WOODFIELD DR. & JAYCOX RD.

NO. 00917

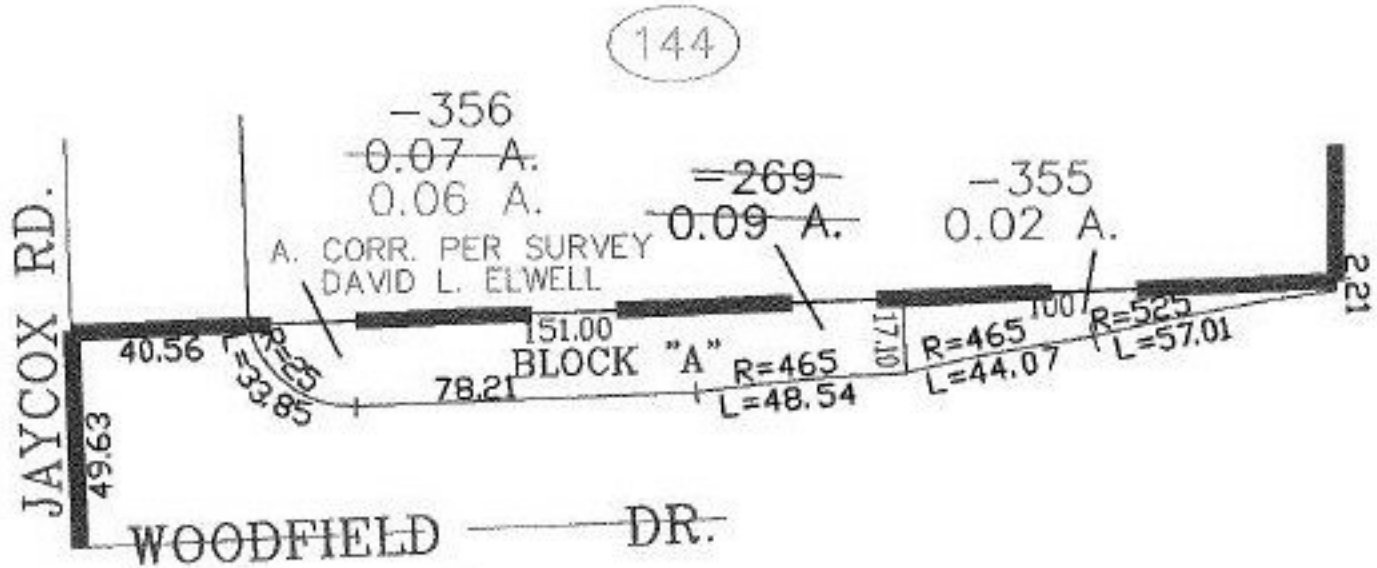

WOODFIELD ESTATES SUBD. NO. 1
VOL 56 PGS. 64-65

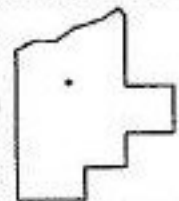

SPLITS/DEEDS PROCESSED
LORAIN COUNTY TAX MAP DEPARTMENT
226 MIDDLE AVE. ELYRIA, OHIO

SURVEYED BY: DAVID L. ELWELL
CLOSURE: 0.00 : 10.000
MAP PAGE(S): 04-00-019-G
APPROVED BY: JAH DATE: 11-16-01
SCALE: 1" = 50' PRIOR INSTRUMENT: PLAT VOL 56/64-65