


SEE 3-00-110-B

254

ST.

(3-7-77)

17.55
27.08

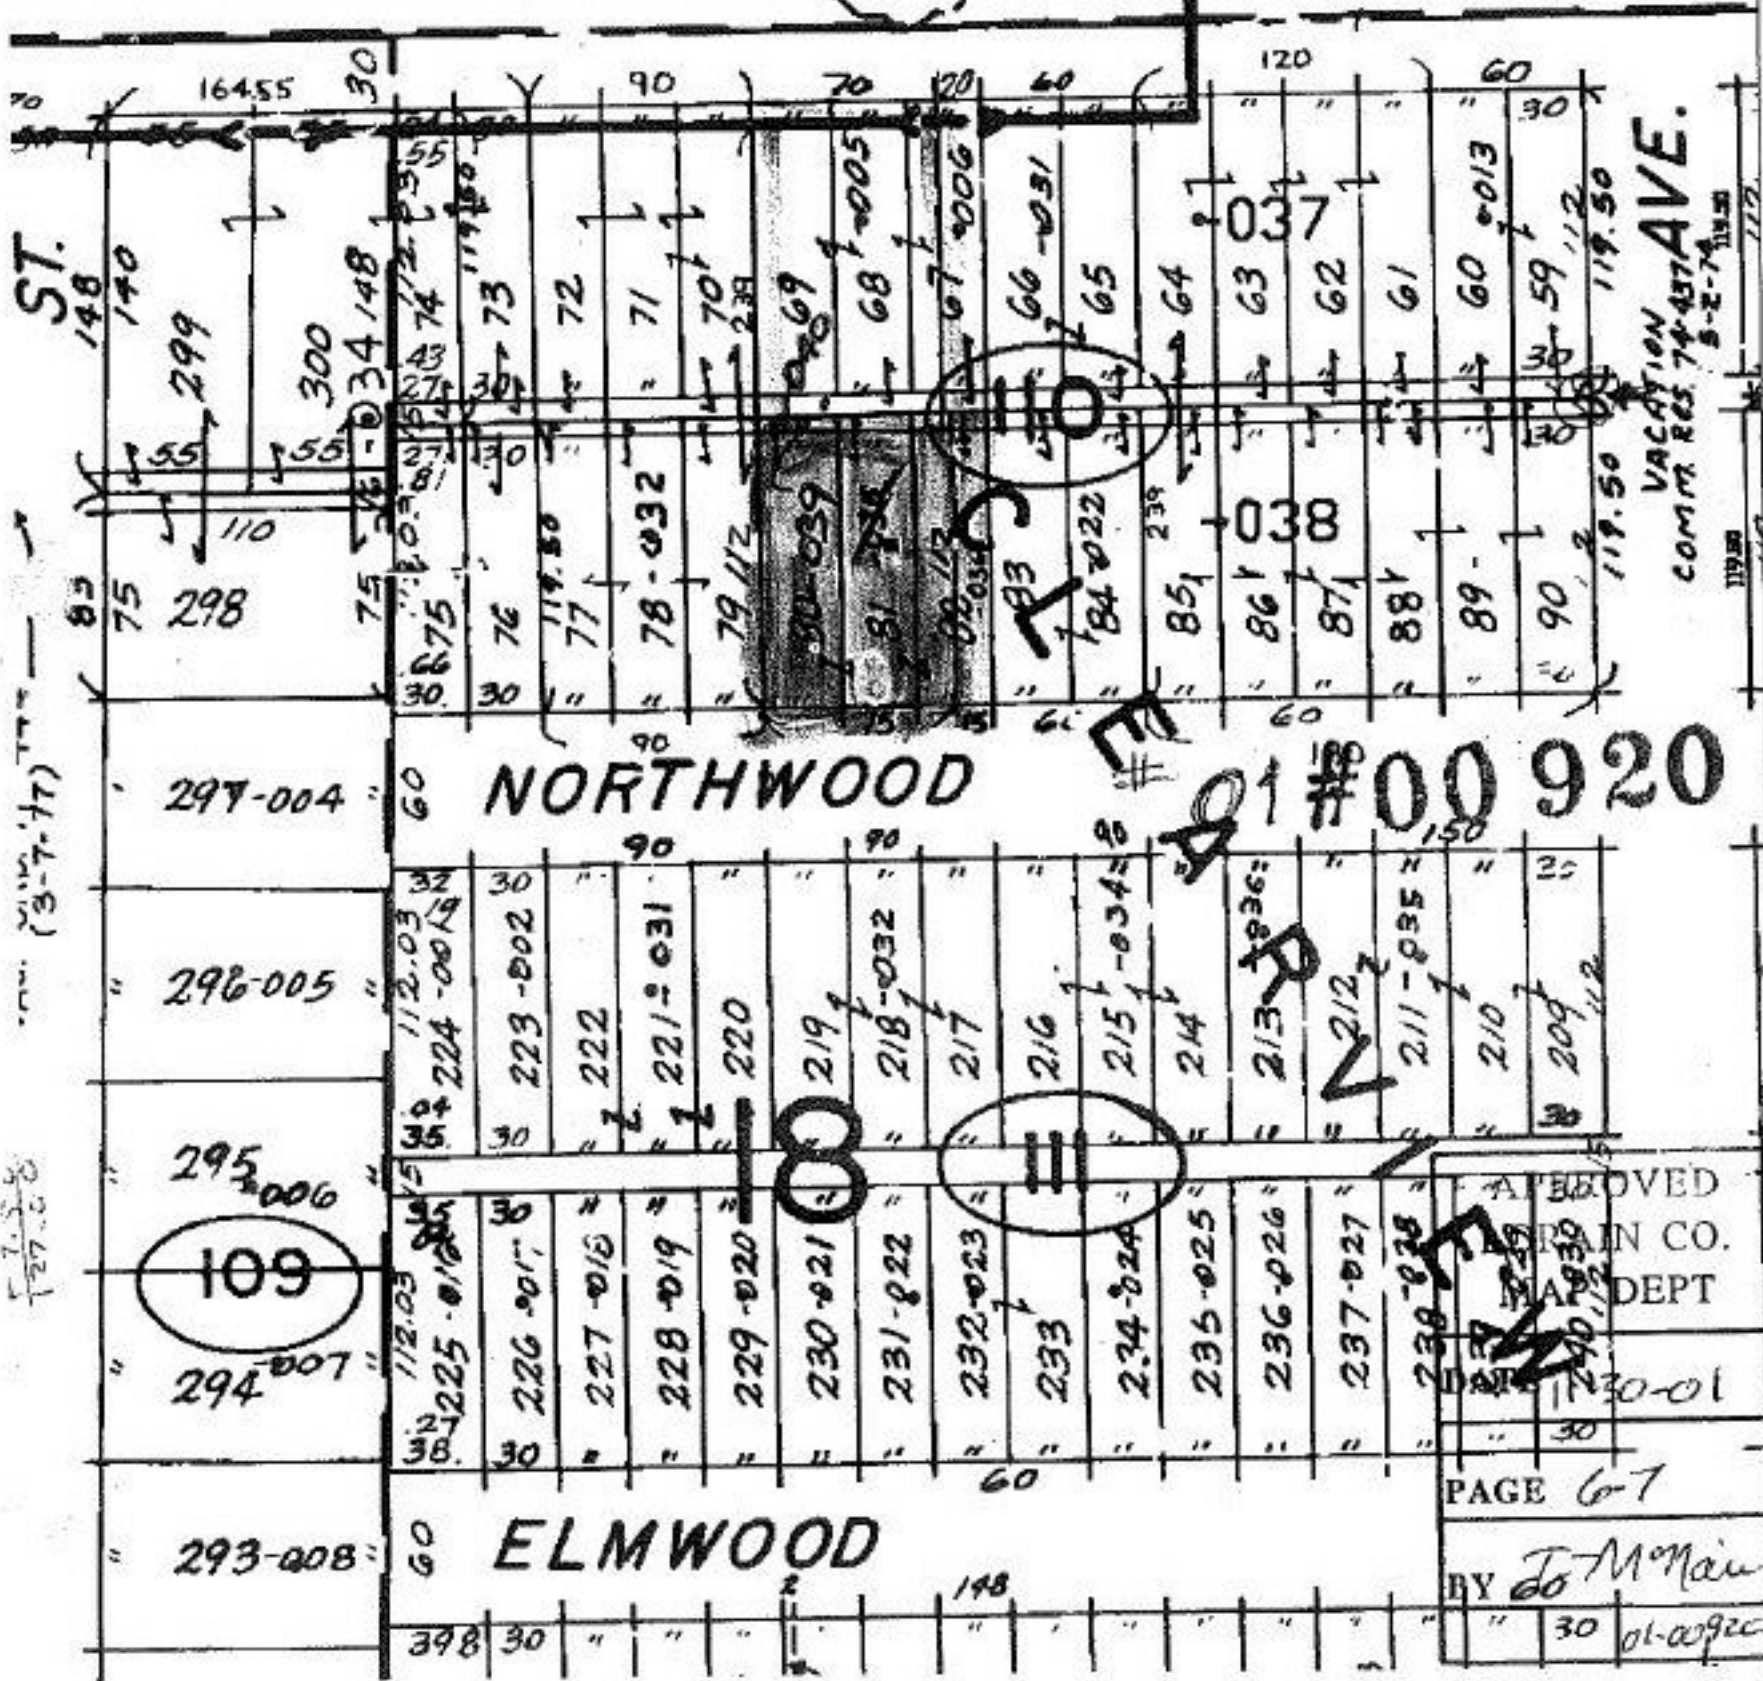

297-004

NORTHWOOD

296-005

295-006

109

294-007

293-008

ELMWOOD

APR #00920

APPROVED
IN CO.
DEPT

PAGE 6-7

BY J. McMan

30 01-00920

VACATION
COM. RES. 74-437 AVE.
8-2-74