


RASTER

PARENT PARCEL: 02-02-012-010-002, 02-02-011-000-016  
CHILD PARCEL: 02-02-012-101-003 THRU -005, 02-02-011-000-017 THRU -021  
STARTING POINT: CENTERLINE OF MEISTER RD. & O.L. 11 & 12

NO. 00942

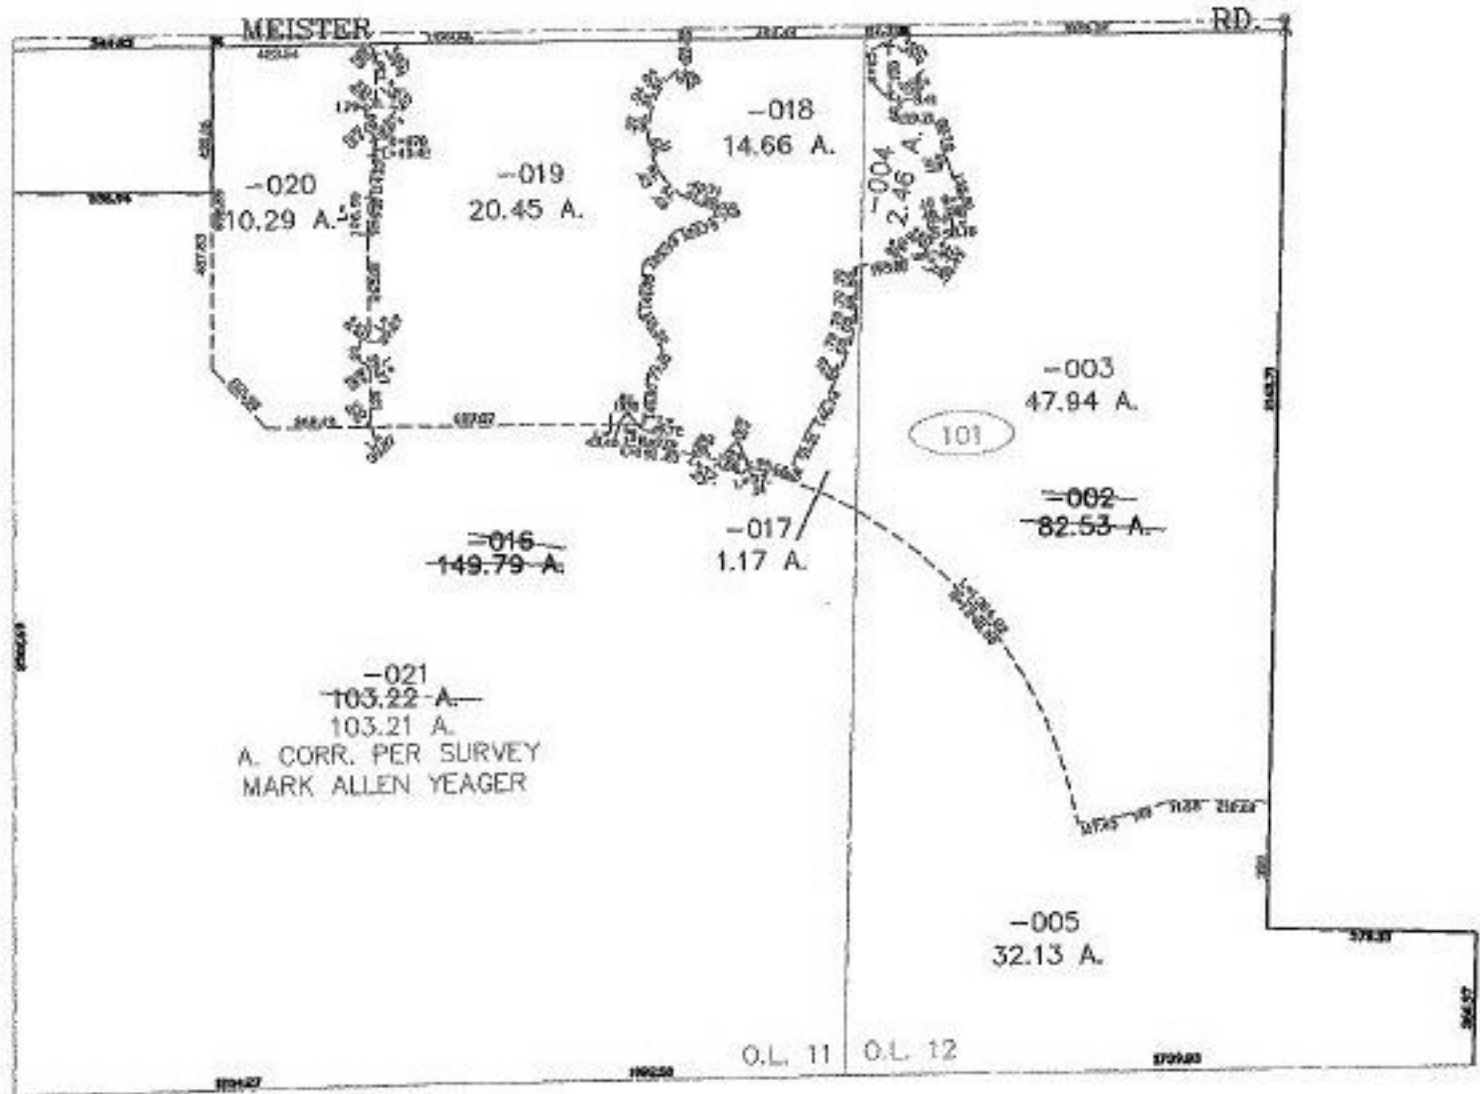

**SPLITS/DEEDS PROCESSED**  
LORAIN COUNTY TAX MAP DEPARTMENT  
226 MIDDLE AVE. ELYRIA, OHIO

SURVEYED BY: MARK ALLEN YEAGER  
CLOSURE: 0.01 : 10,000  
MAP PAGE(S): 2-F  
APPROVED BY: JAH DATE: 12-19-01  
SCALE: 1" = 100' PRIOR INSTRUMENT: 20010729273