


PARENT PARCEL: 09-00-097-000-051  
CHILD PARCEL: 09-00-097-000-087 THRU -089  
STARTING POINT: CENTERLINE OF PARSONS RD. & OBERLIN RD.

NO. 00944

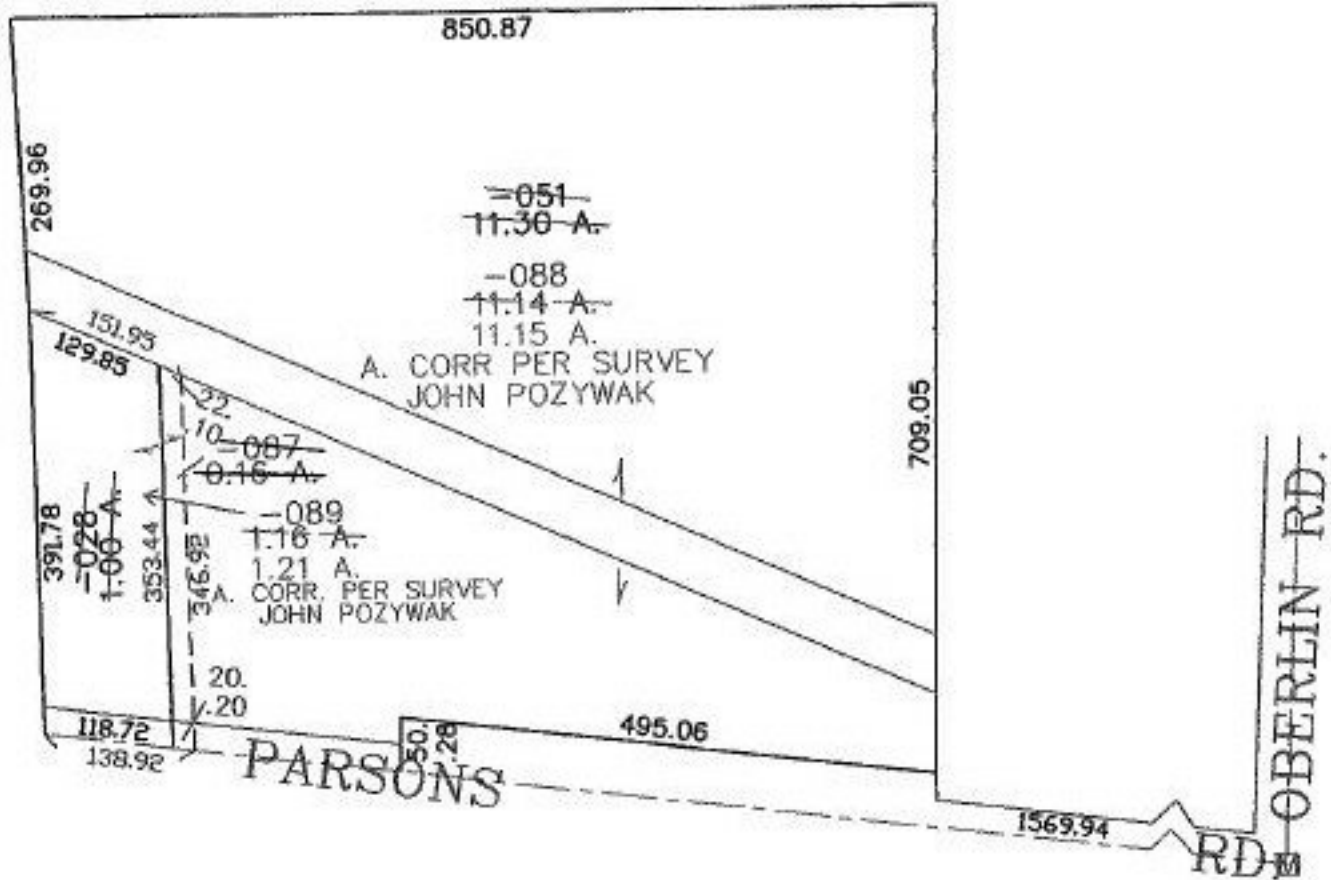

**SPLITS/DEEDS PROCESSED**  
LORAIN COUNTY TAX MAP DEPARTMENT  
226 MIDDLE AVE. ELYRIA, OHIO

SURVEYED BY: JOHN POZYWAK  
CLOSURE: 0.00 : 10.000  
MAP PAGE(S): 9-00-097-B  
APPROVED BY: JAH DATE: 1-24-02  
SCALE: 1" = 200' PRIOR INSTRUMENT: DV 1214/910