
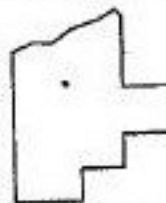


PARENT PARCEL: 07-00-006-102-177

CHILD PARCEL: 07-00-006-102-178, -179

STARTING POINT: CENTERLINE OF CENTER RIDGE RD. & EASTERLY LINE OF LORAIN COUNTY

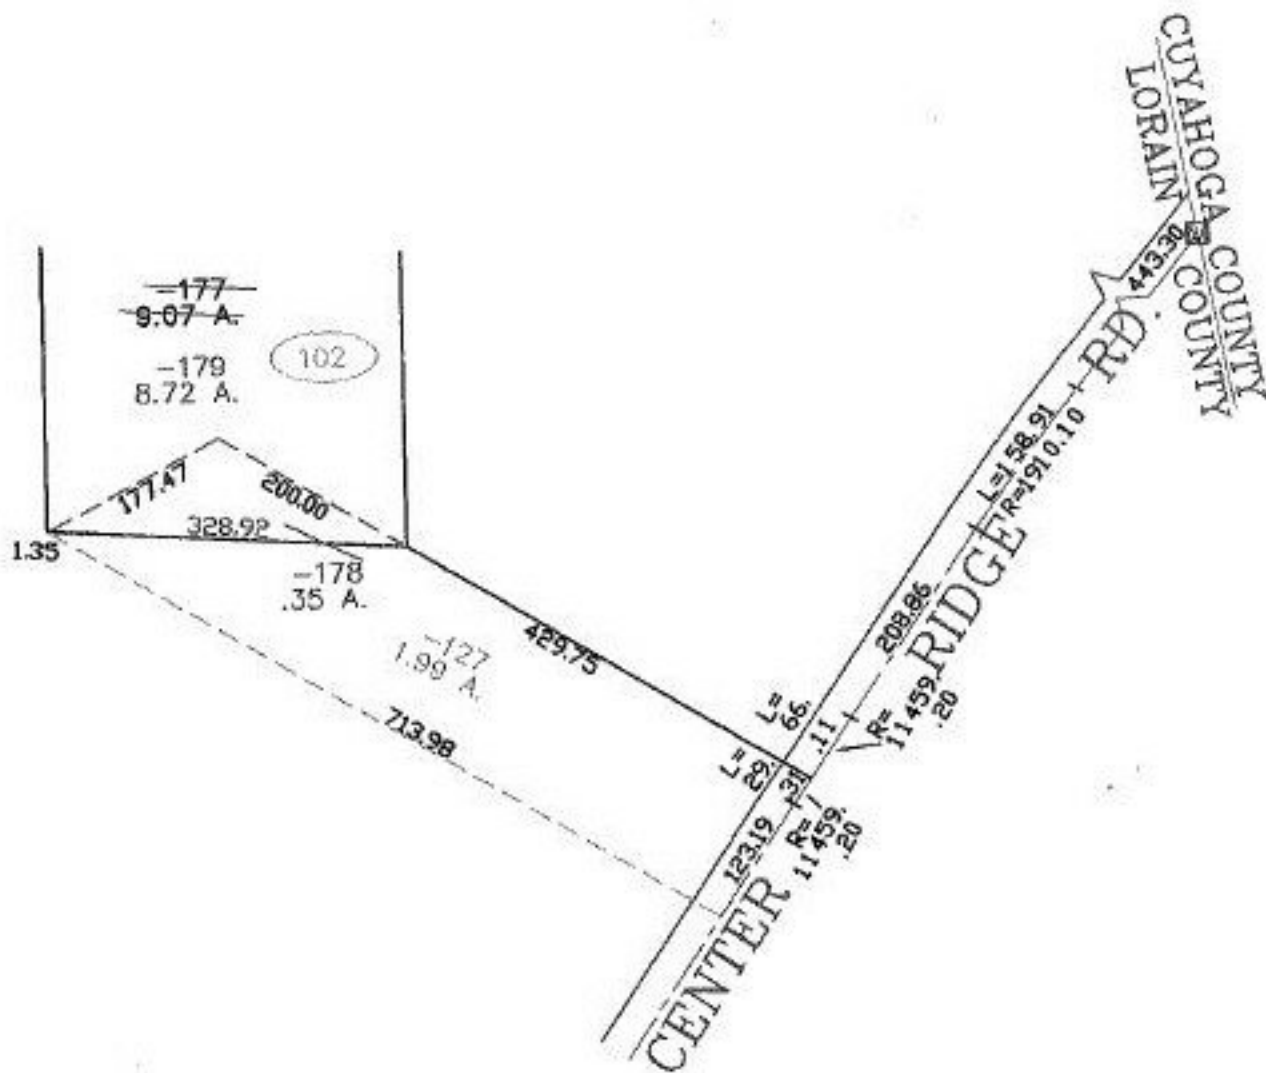

SPLITS/DEEDS PROCESSED
 LORAIN COUNTY TAX MAP DEPARTMENT
 226 MIDDLE AVE. ELYRIA, OHIO

SURVEYED BY: RICHARD F. HANTEI
 CLOSURE: 0.00 : 10.000
 MAP PAGE(S): 7-00-006-8
 APPROVED BY: JAH DATE: 12-28-01
 SCALE: 1" = 200' PRIOR INSTRUMENT: 20010746700