


RASTER

PARENT PARCEL: 05-00-098-000-082



NO. 01006-A

CHILD PARCEL: --SAME--

STARTING POINT: MON BOX AT INT WEST MARTIN AVE AND RED DELICIOUS LANE

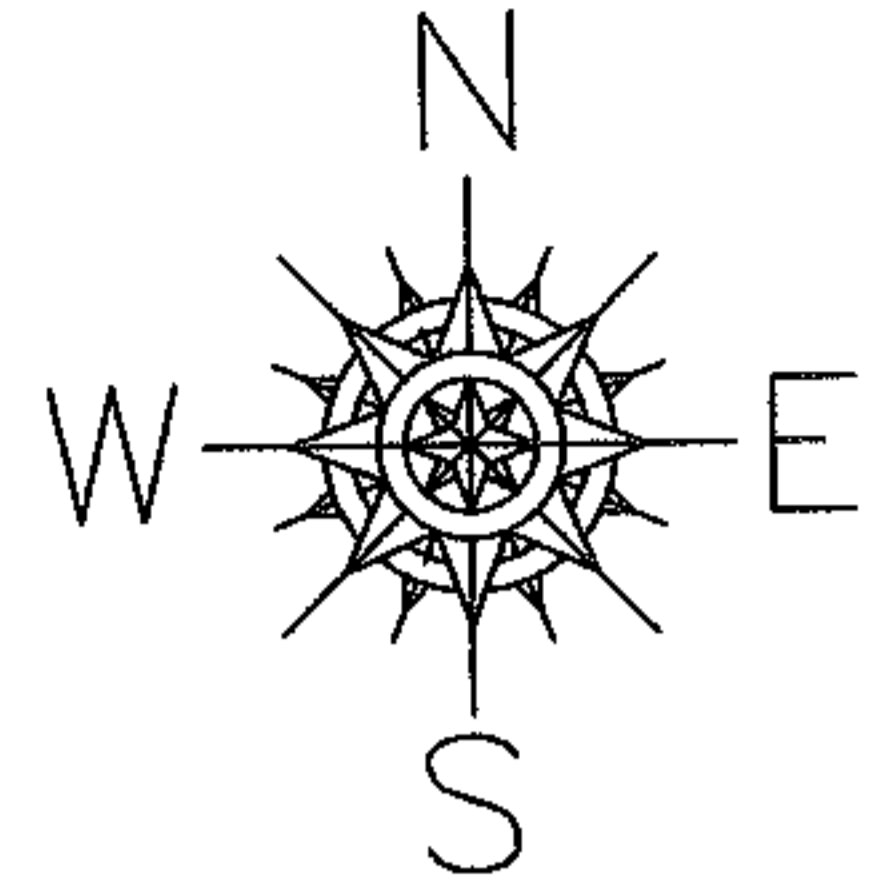

AC. CORR.
PER SURVEY
DAVID ELWELL

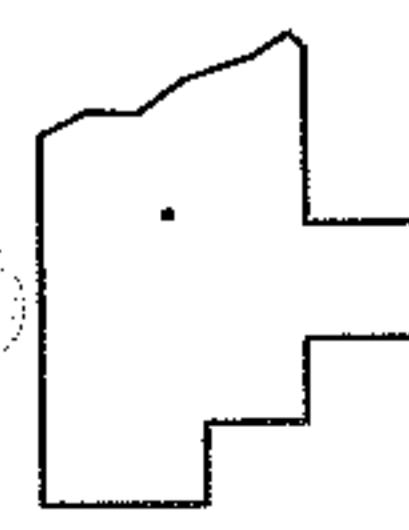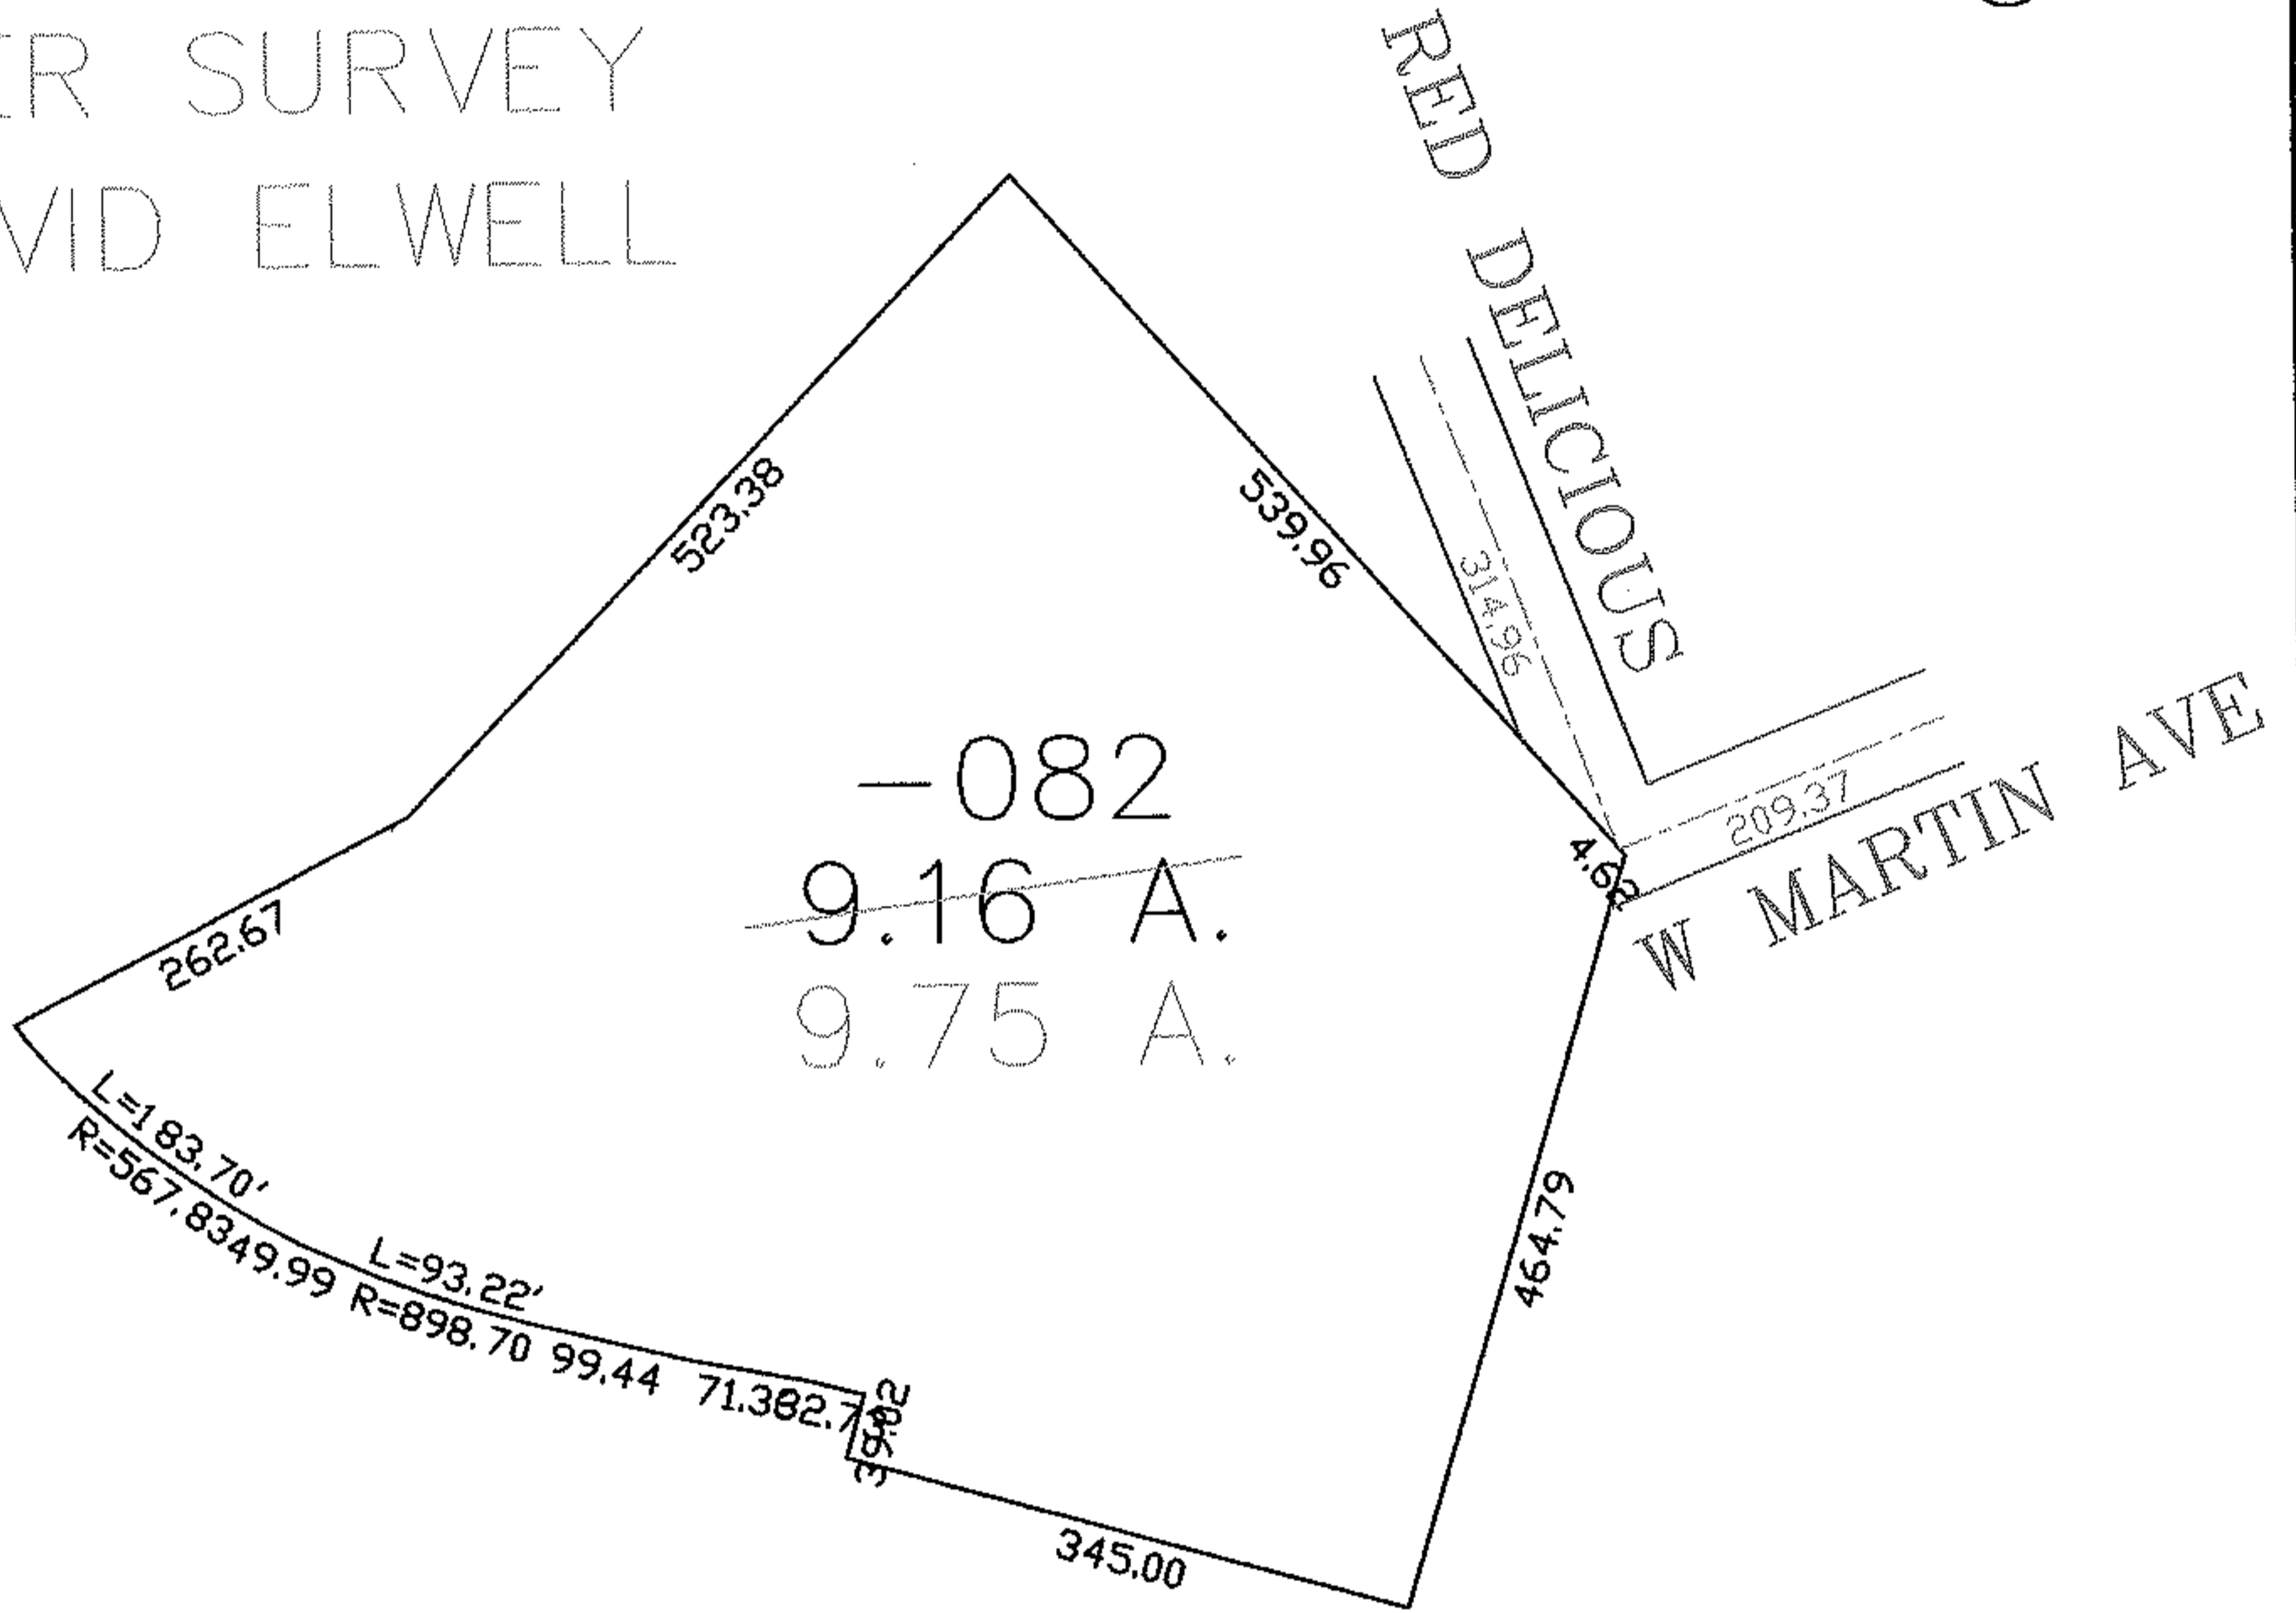

SPLITS/DEEDS PROCESSED
LORAIN COUNTY TAX MAP DEPARTMENT
226 MIDDLE AVE. ELYRIA, OHIO

SURVEYED BY: DAVID L. ELWELL
 CLOSURE: 1:10,000
 MAP PAGE(S): 05-00-098
 APPROVED BY: DRH DATE: 5/17/2004
 SCALE: 1" = 200 PRIOR INSTRUMENT: _____