


PARENT PARCEL: 04-00-008-104-100

CHILD PARCEL: --SAME--

STARTING POINT: MON BOX INT CL PIN OAK PARKWAY AND CL AVON BELDEN RD


NO. 01021-C

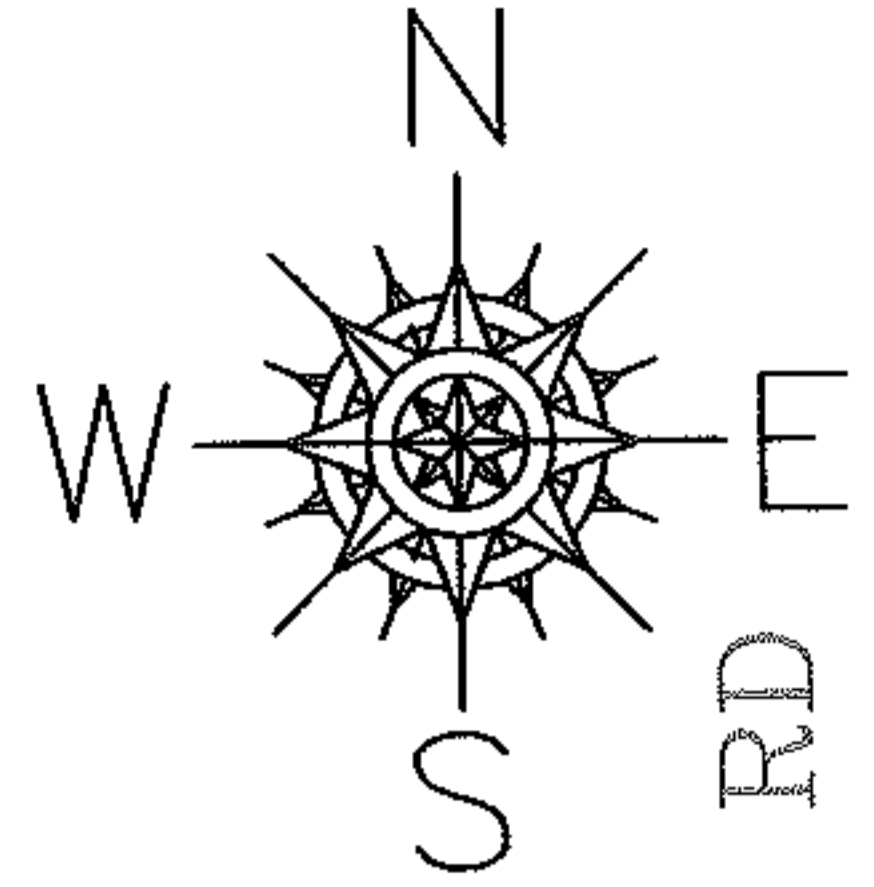

AVON BELDEN RD


AC. CORR.
PER SURVEY
DAVID L. ELWELL

2346.37

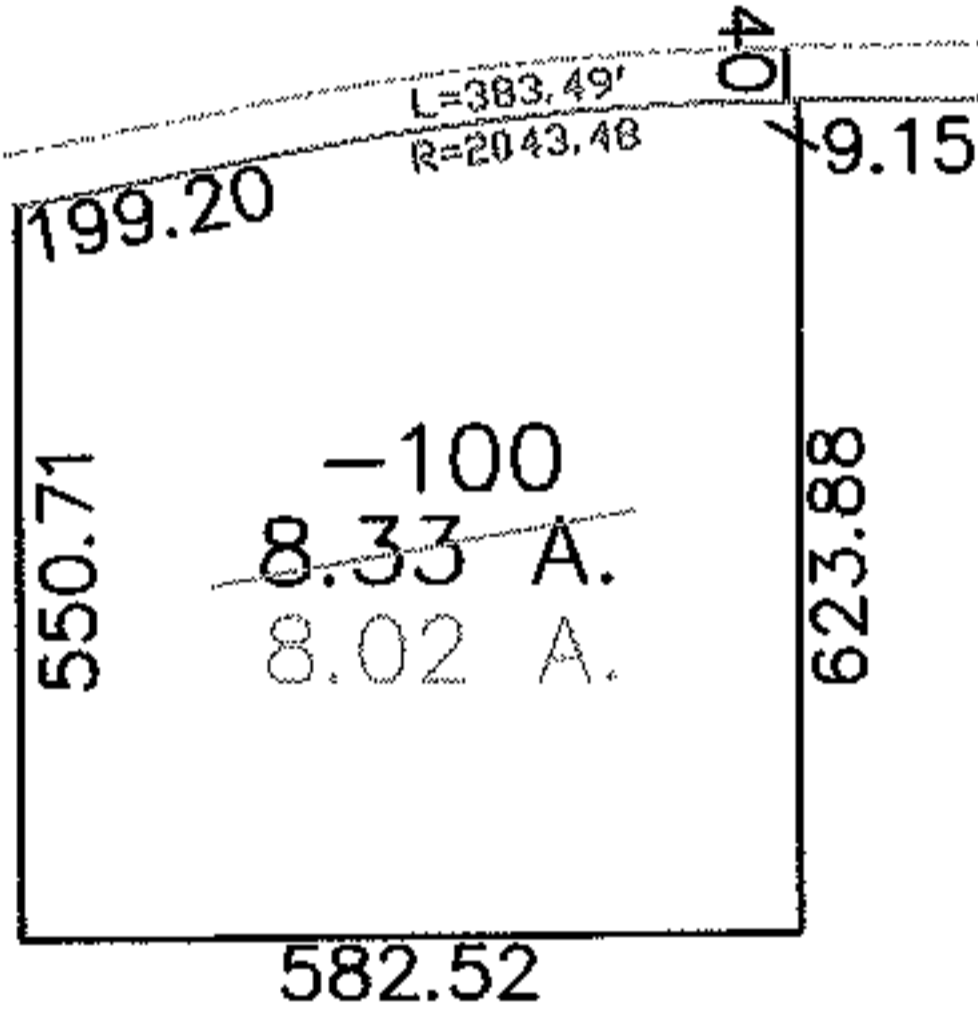

PIN OAK PARKWAY

PAGE 1 OF 2

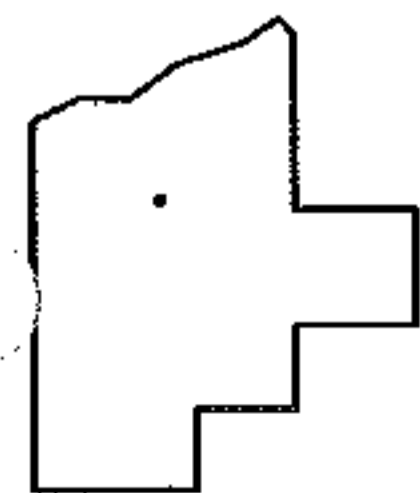

SPLITS/DEEDS PROCESSED
LORAIN COUNTY TAX MAP DEPARTMENT
226 MIDDLE AVE. ELYRIA, OHIO

SURVEYED BY: DAVID L. ELWELL
CLOSURE: 1:10,000
MAP PAGE(S): 04-00-008
APPROVED BY: DRH DATE: 6/24/2004
SCALE: 1" = 400 PRIOR INSTRUMENT: 2000666439