

RASTER

PARENT PARCEL: 21-05-031-000-004

NO. 001029-C

CHILD PARCEL: --SAME--


STARTING POINT: CL GRIGGS RD

CAN'T

DRAW

AC. CORR.


PER DEED.

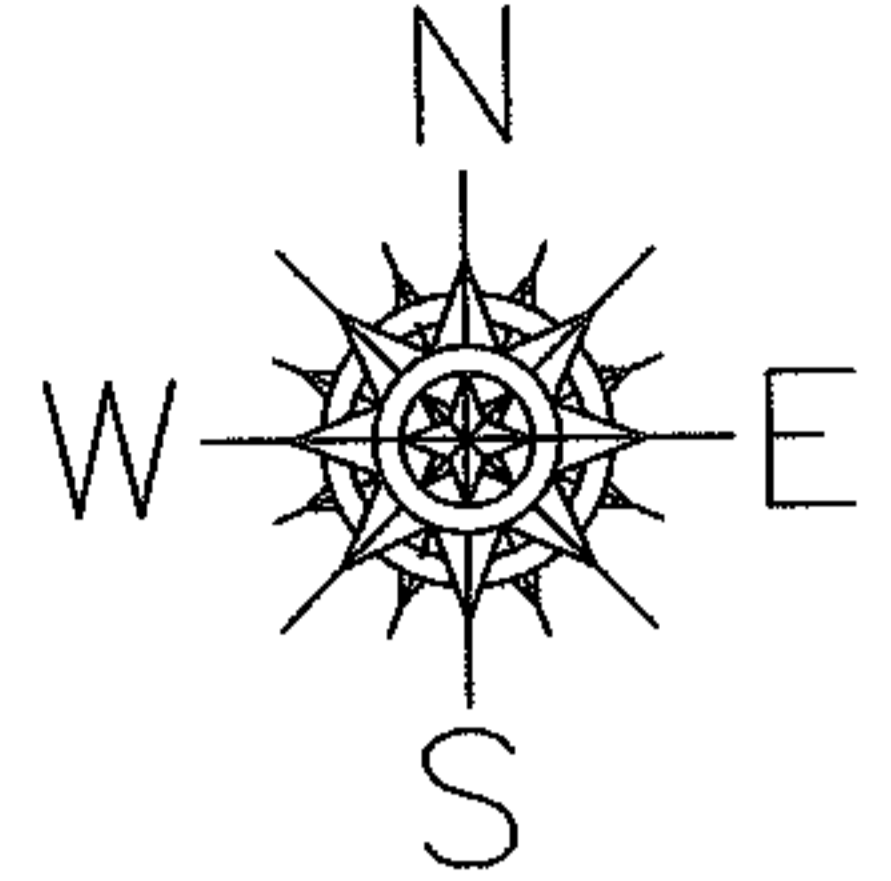

-004

~~37.87 A.~~

37.84 A.

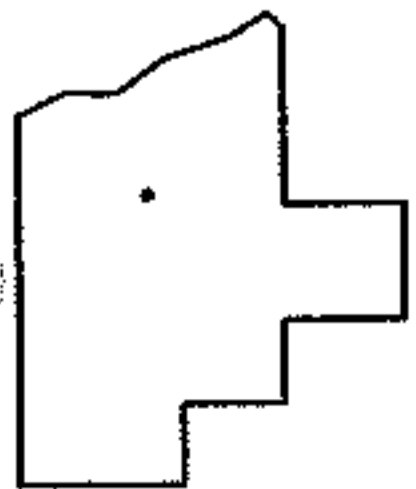

SPLITS/DEEDS PROCESSED

LORAIN COUNTY TAX MAP DEPARTMENT  
226 MIDDLE AVE. ELYRIA, OHIO

SURVEYED BY: N/A

CLOSURE: N/A

MAP PAGE(S): 21-A

APPROVED BY: DRH DATE: 7/19/2004

SCALE: 1" = 100' PRIOR INSTRUMENT: 19990622819