



EASTER

PARENT PARCEL: 08-00-104-000-012

CHILD PARCEL: --SAME--


STARTING POINT: MON BOX INT CL BAUMHART RD AND CL RUSSIA RD

NO. 01032-A

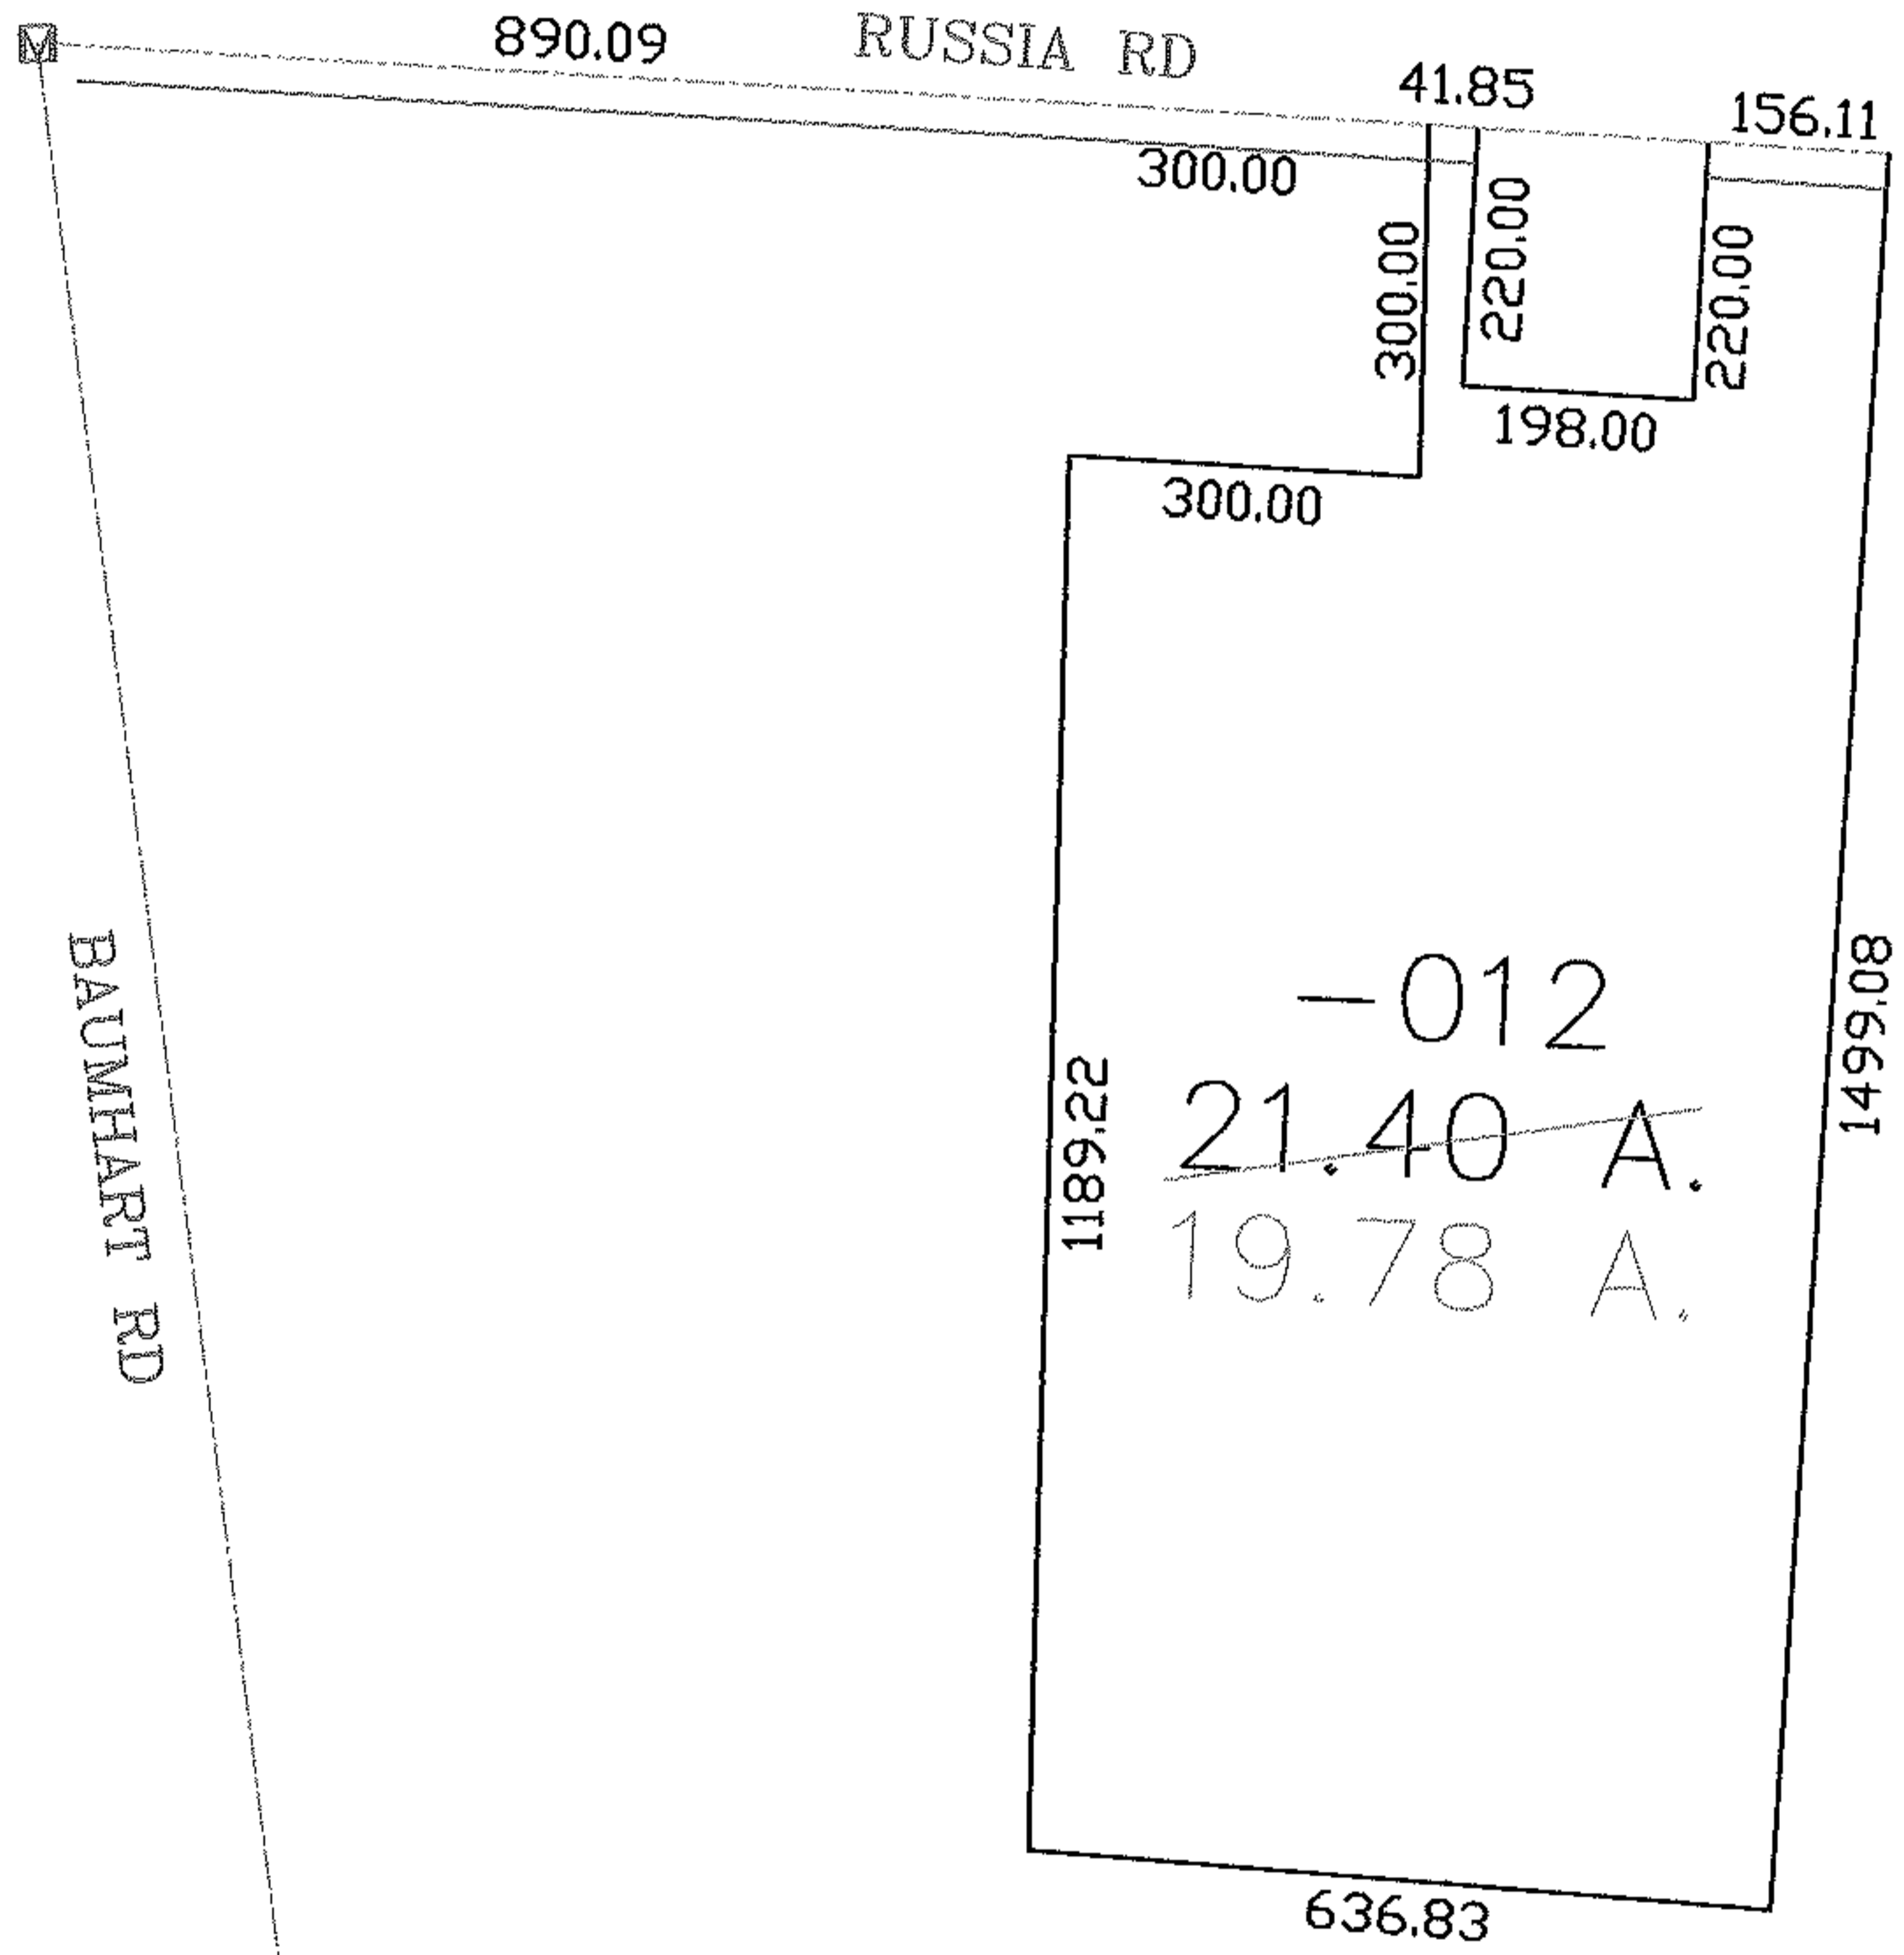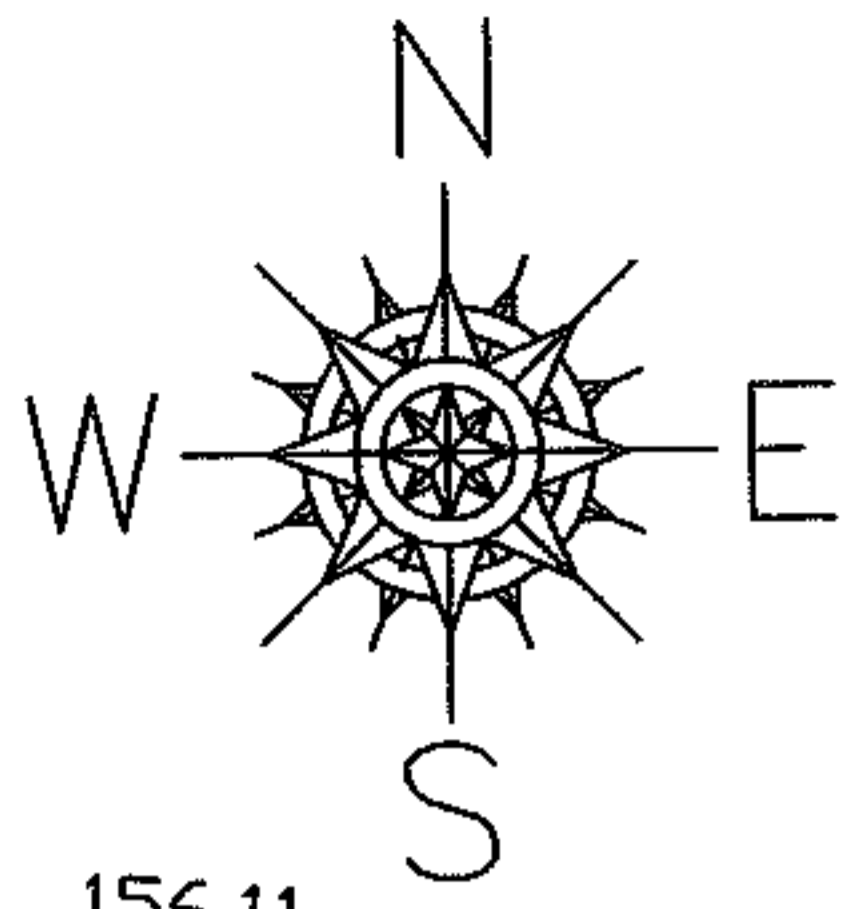

-012
~~21.40 A.~~
 19.78 A.

AC. CORR.
 PER SURVEY
 CHRIS HIRZEL

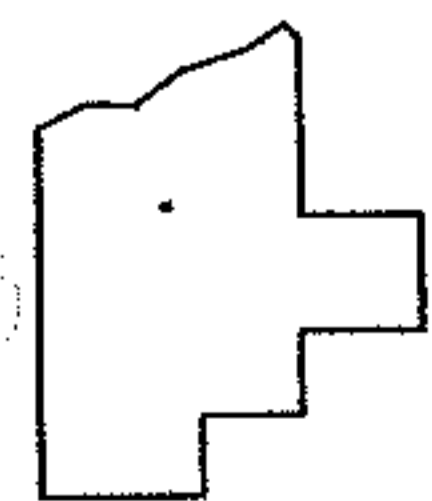

SPLITS/DEEDS PROCESSED
 LORAIN COUNTY TAX MAP DEPARTMENT
 226 MIDDLE AVE. ELYRIA, OHIO

SURVEYED BY: CHRISTOPHER HIRZEL
 CLOSURE: 1:10,000
 MAP PAGE(S): 08-00-104-A
 APPROVED BY: DRH DATE: 8/9/2004
 SCALE: 1" = 300' PRIOR INSTRUMENT: DV 420/172