



RASTER

PARENT PARCEL: 20-05-023-101-040


CHILD PARCEL: --SAME--

STARTING POINT: INT CL STATE ST AND WEST GRIGGS RD

NO. 01034-D

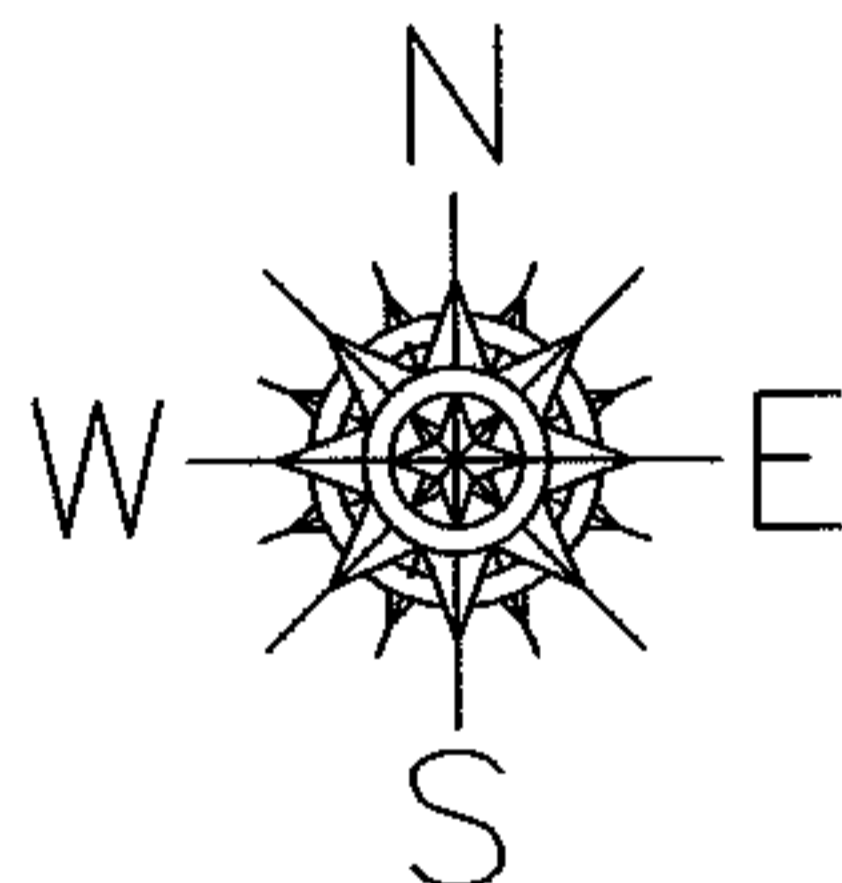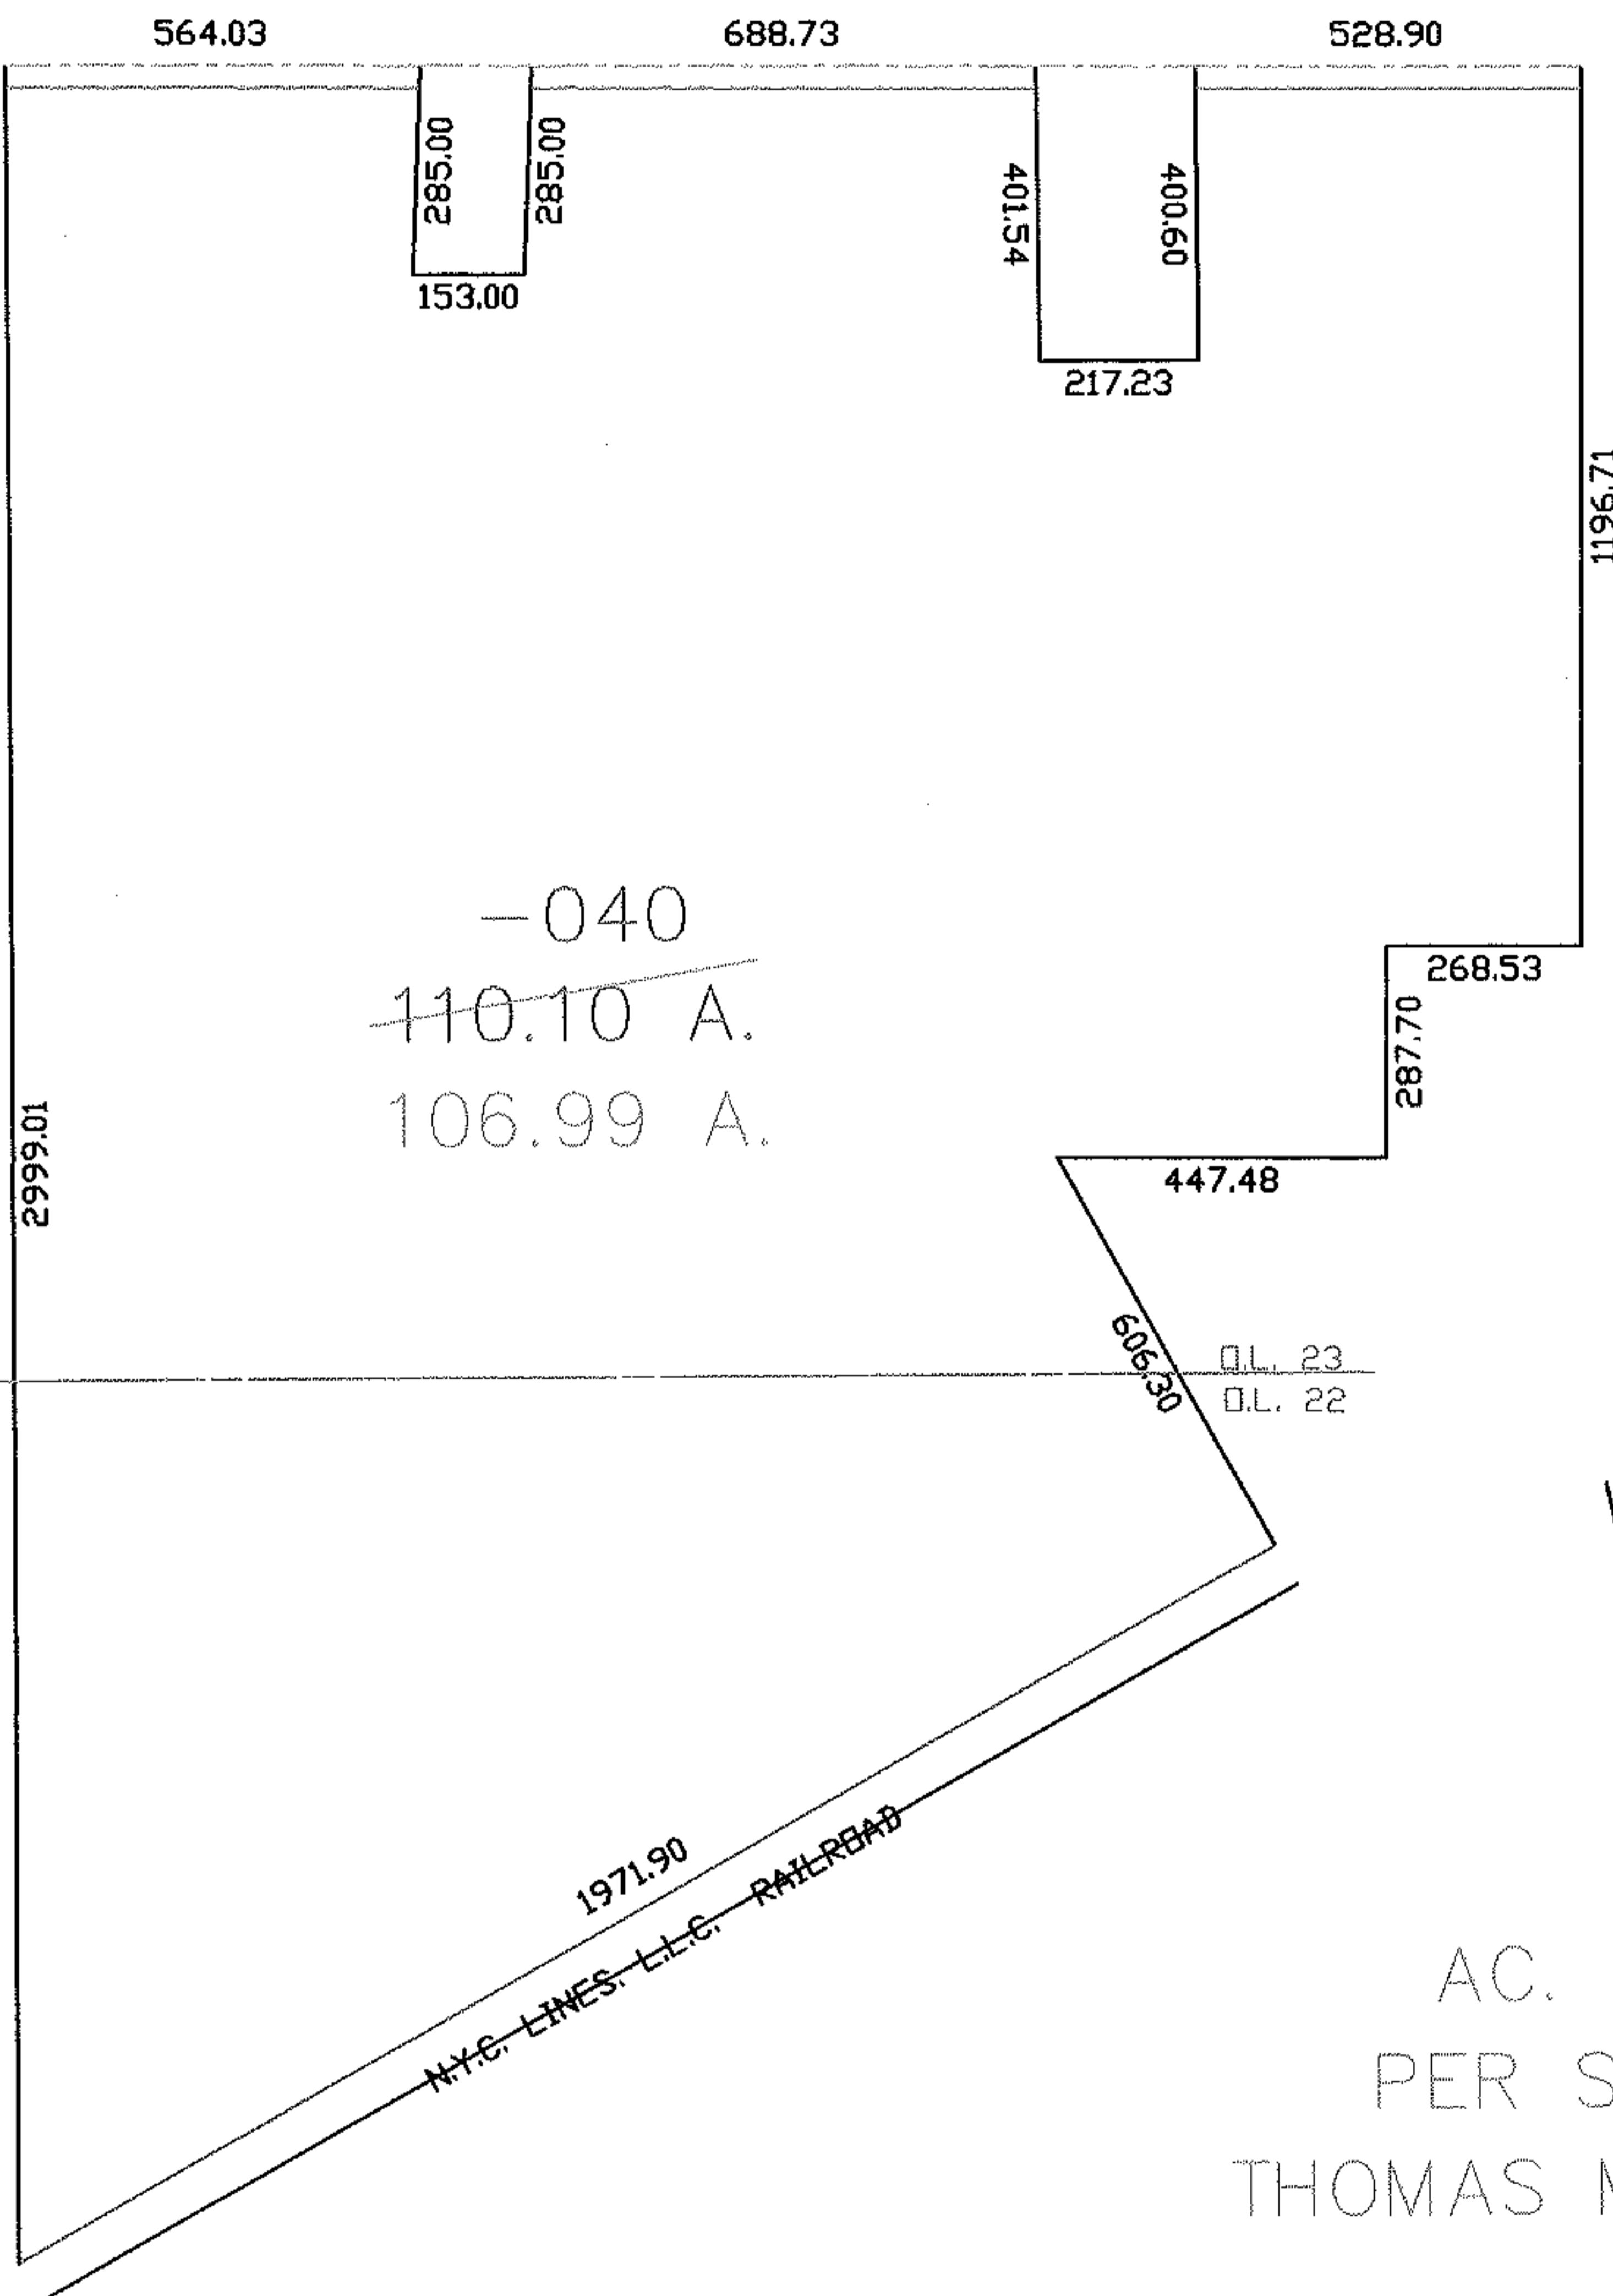

AC. CORR
 PER SURVEY
 THOMAS M. SNEZEK

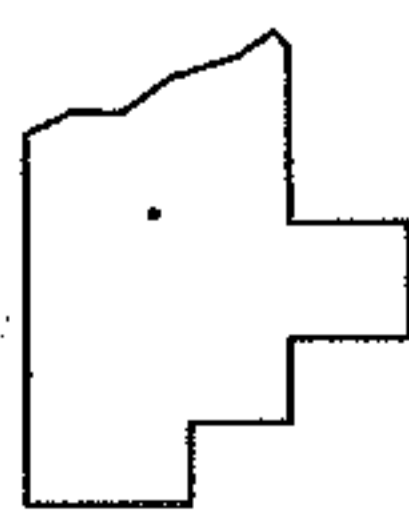

SPLITS/DEEDS PROCESSED
 LORAIN COUNTY TAX MAP DEPARTMENT
 226 MIDDLE AVE. ELYRIA, OHIO

SURVEYED BY: THOMAS M. SNEZEK
 CLOSURE: 1:10,000
 MAP PAGE(S): 20-05-023-A
 APPROVED BY: DRH DATE: 8/6/2004
 SCALE: 1" = 400 PRIOR INSTRUMENT: OR 728/145