



RASTER

PARENT PARCEL: 02-03-001-103-042


NO. 01048-D

CHILD PARCEL: --SAME--

STARTING POINT: INT CL KOLBE RD AND N LINE OF KOLBE ACRES SUB

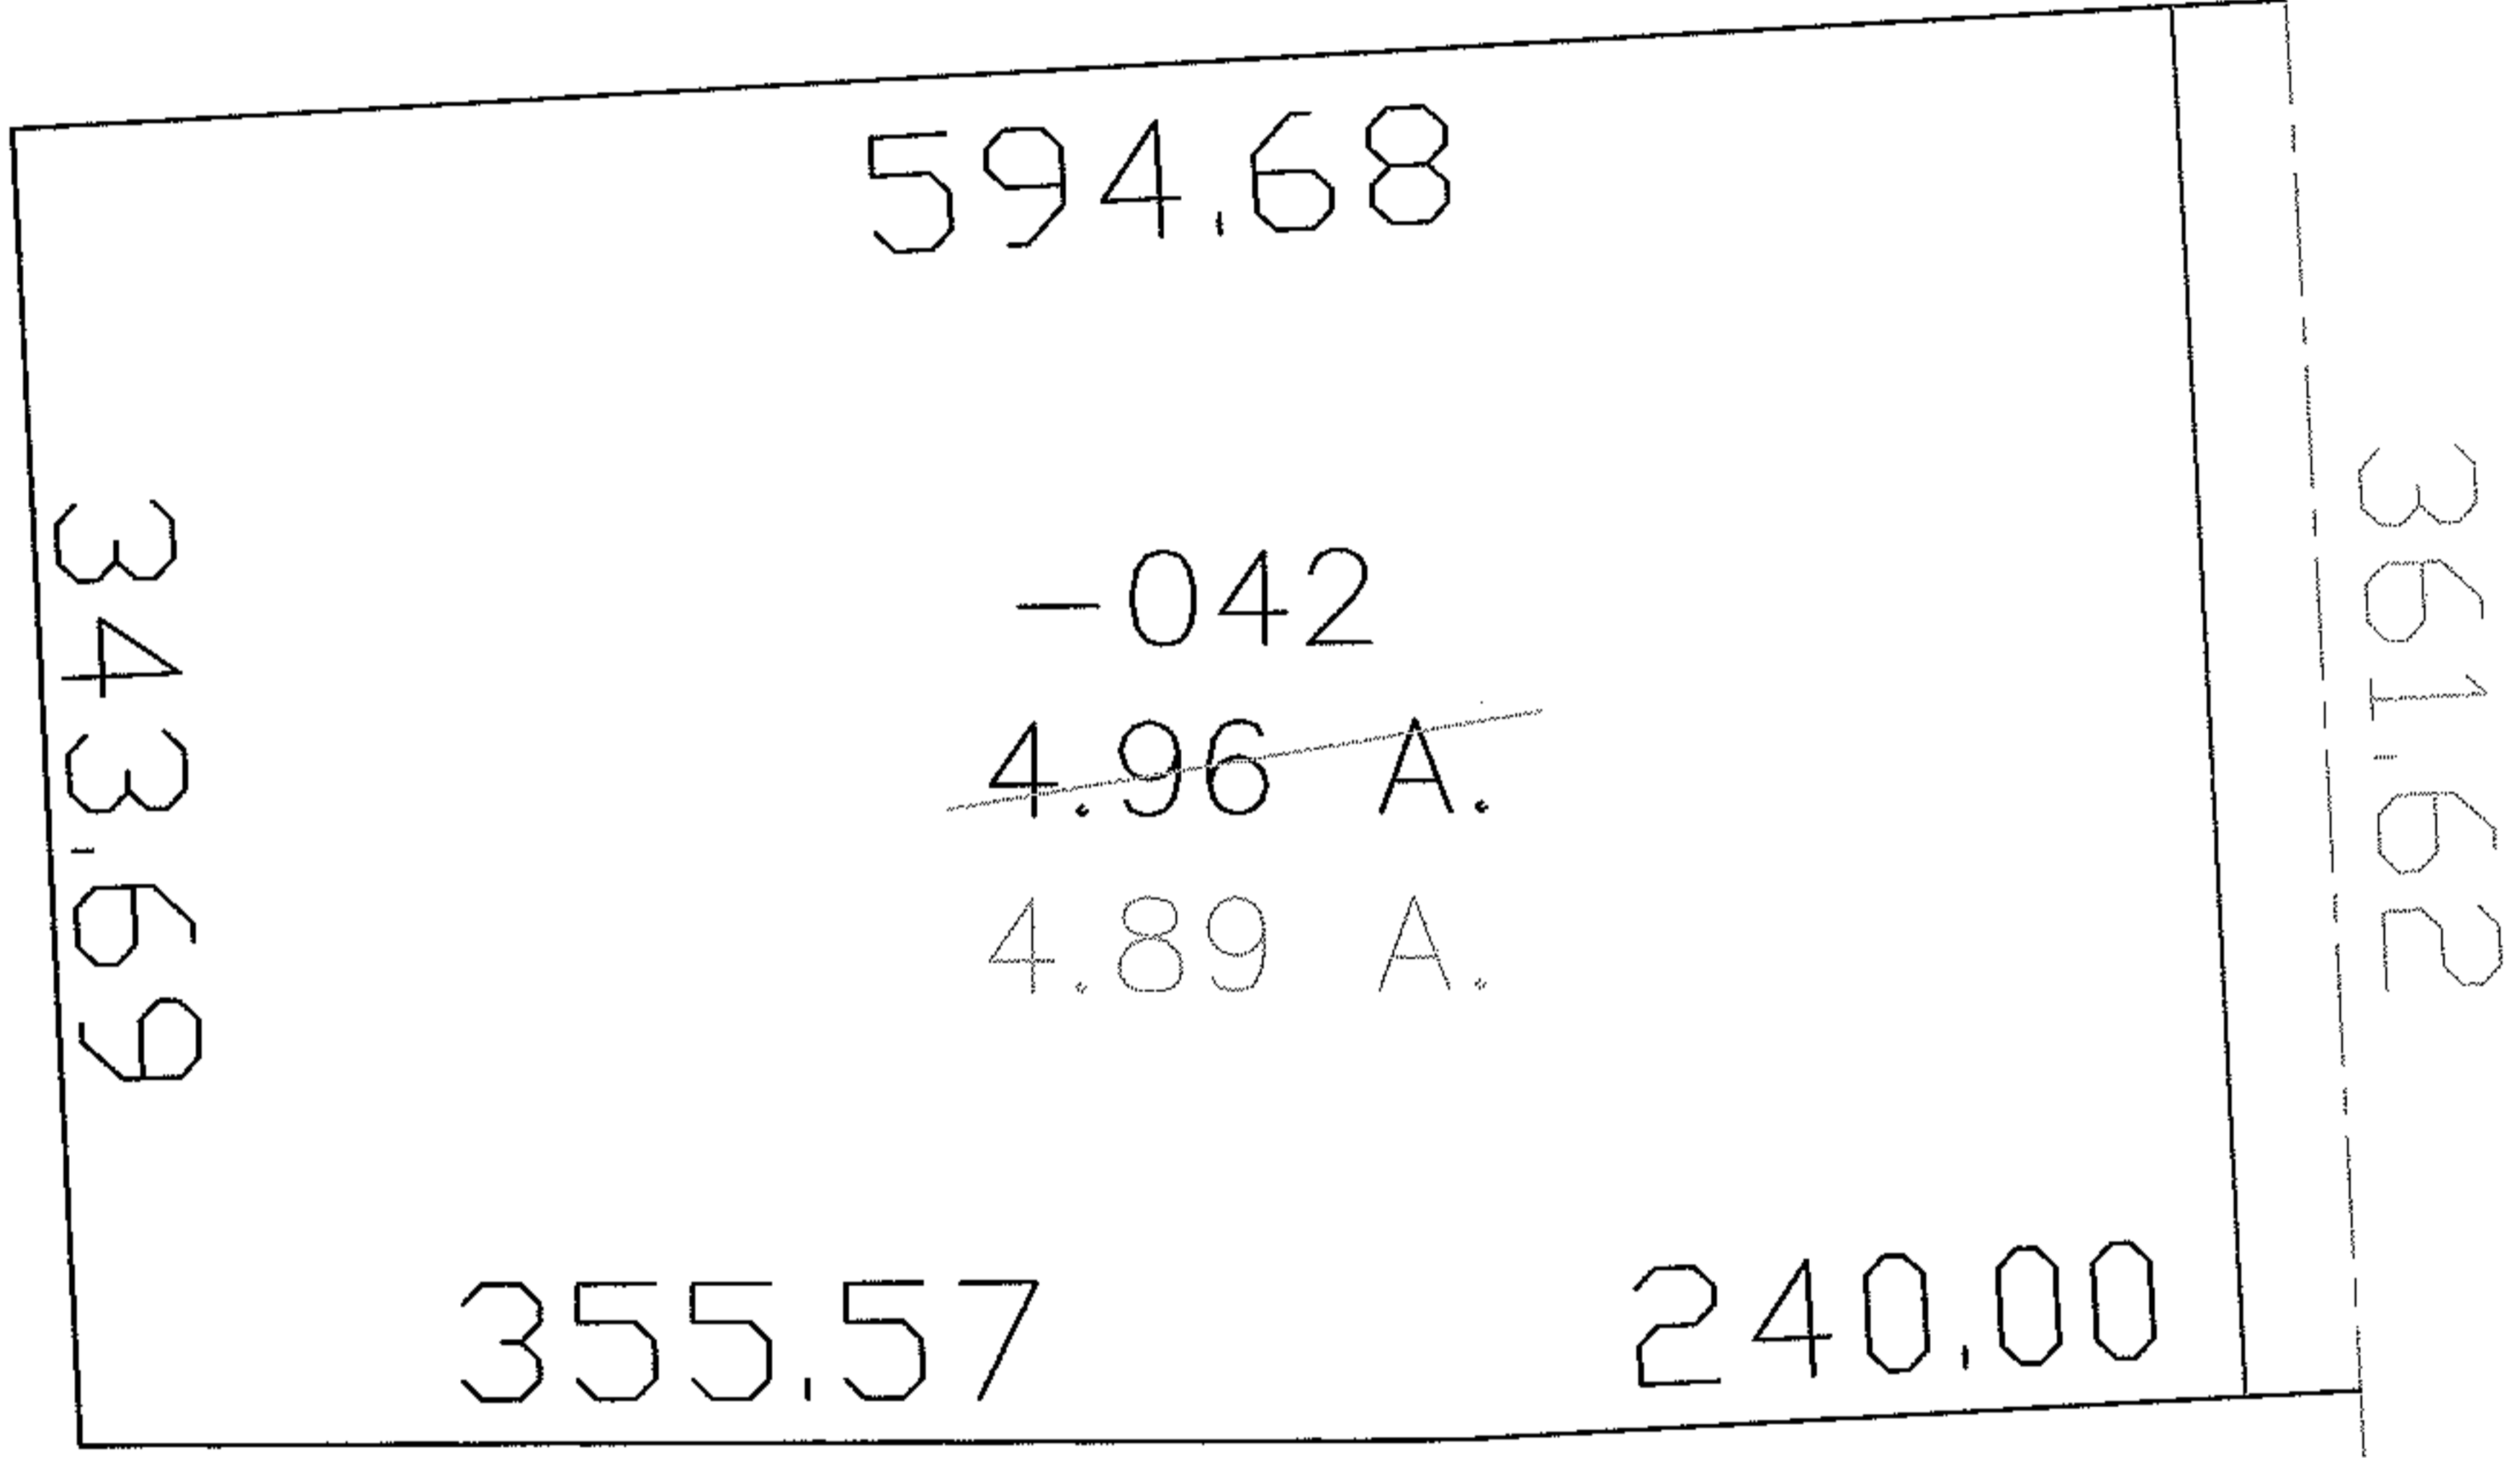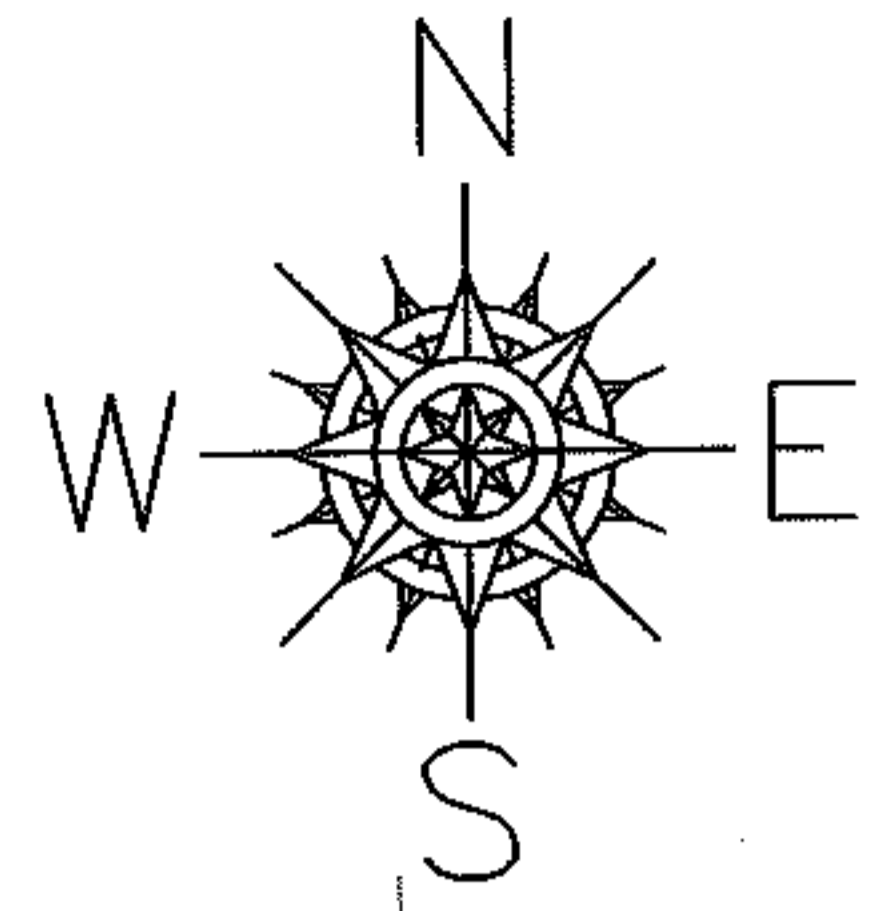

AC. CORR.
 PER SURVEY
 CHRISTOPHER M. HIRZEL

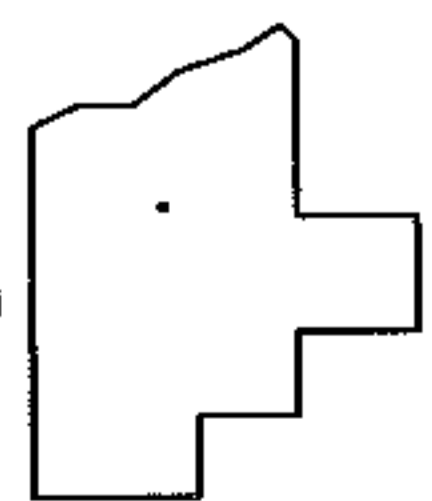

SPLITS/DEEDS PROCESSED

LORAIN COUNTY TAX MAP DEPARTMENT
 226 MIDDLE AVE. ELYRIA, OHIO

SURVEYED BY: CHRISTOPHER HIRZEL
 CLOSURE: 1:10.000
 MAP PAGE(S): 02-03-001-C
 APPROVED BY: DRH DATE: 8/31/2004
 SCALE: 1" = 100' PRIOR INSTRUMENT: 790/525