


EASTER

PARENT PARCEL: 02-01-006-141-006



NO. 01049-C

CHILD PARCEL: --SAME--

STARTING POINT:

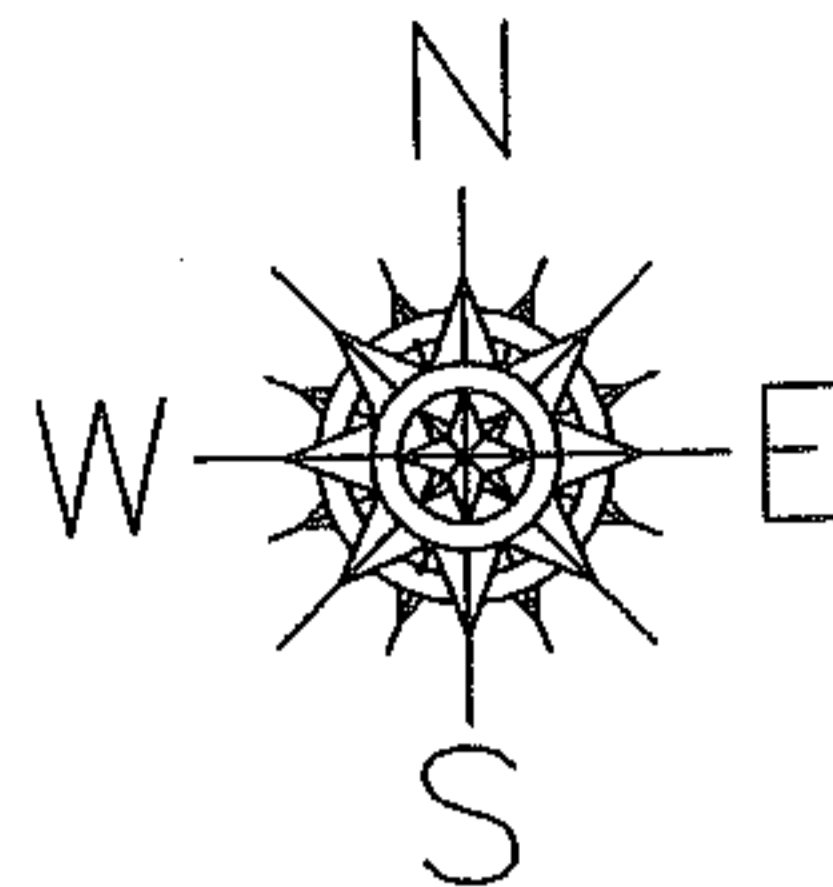

MAP CORR. PER SURVEY PATRICK MCGANNON

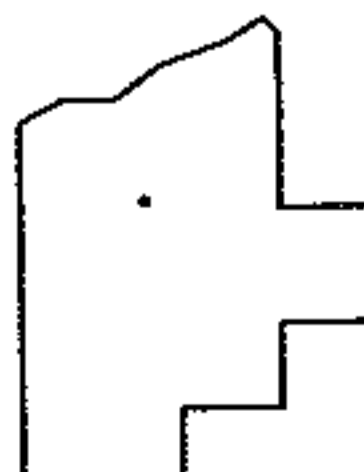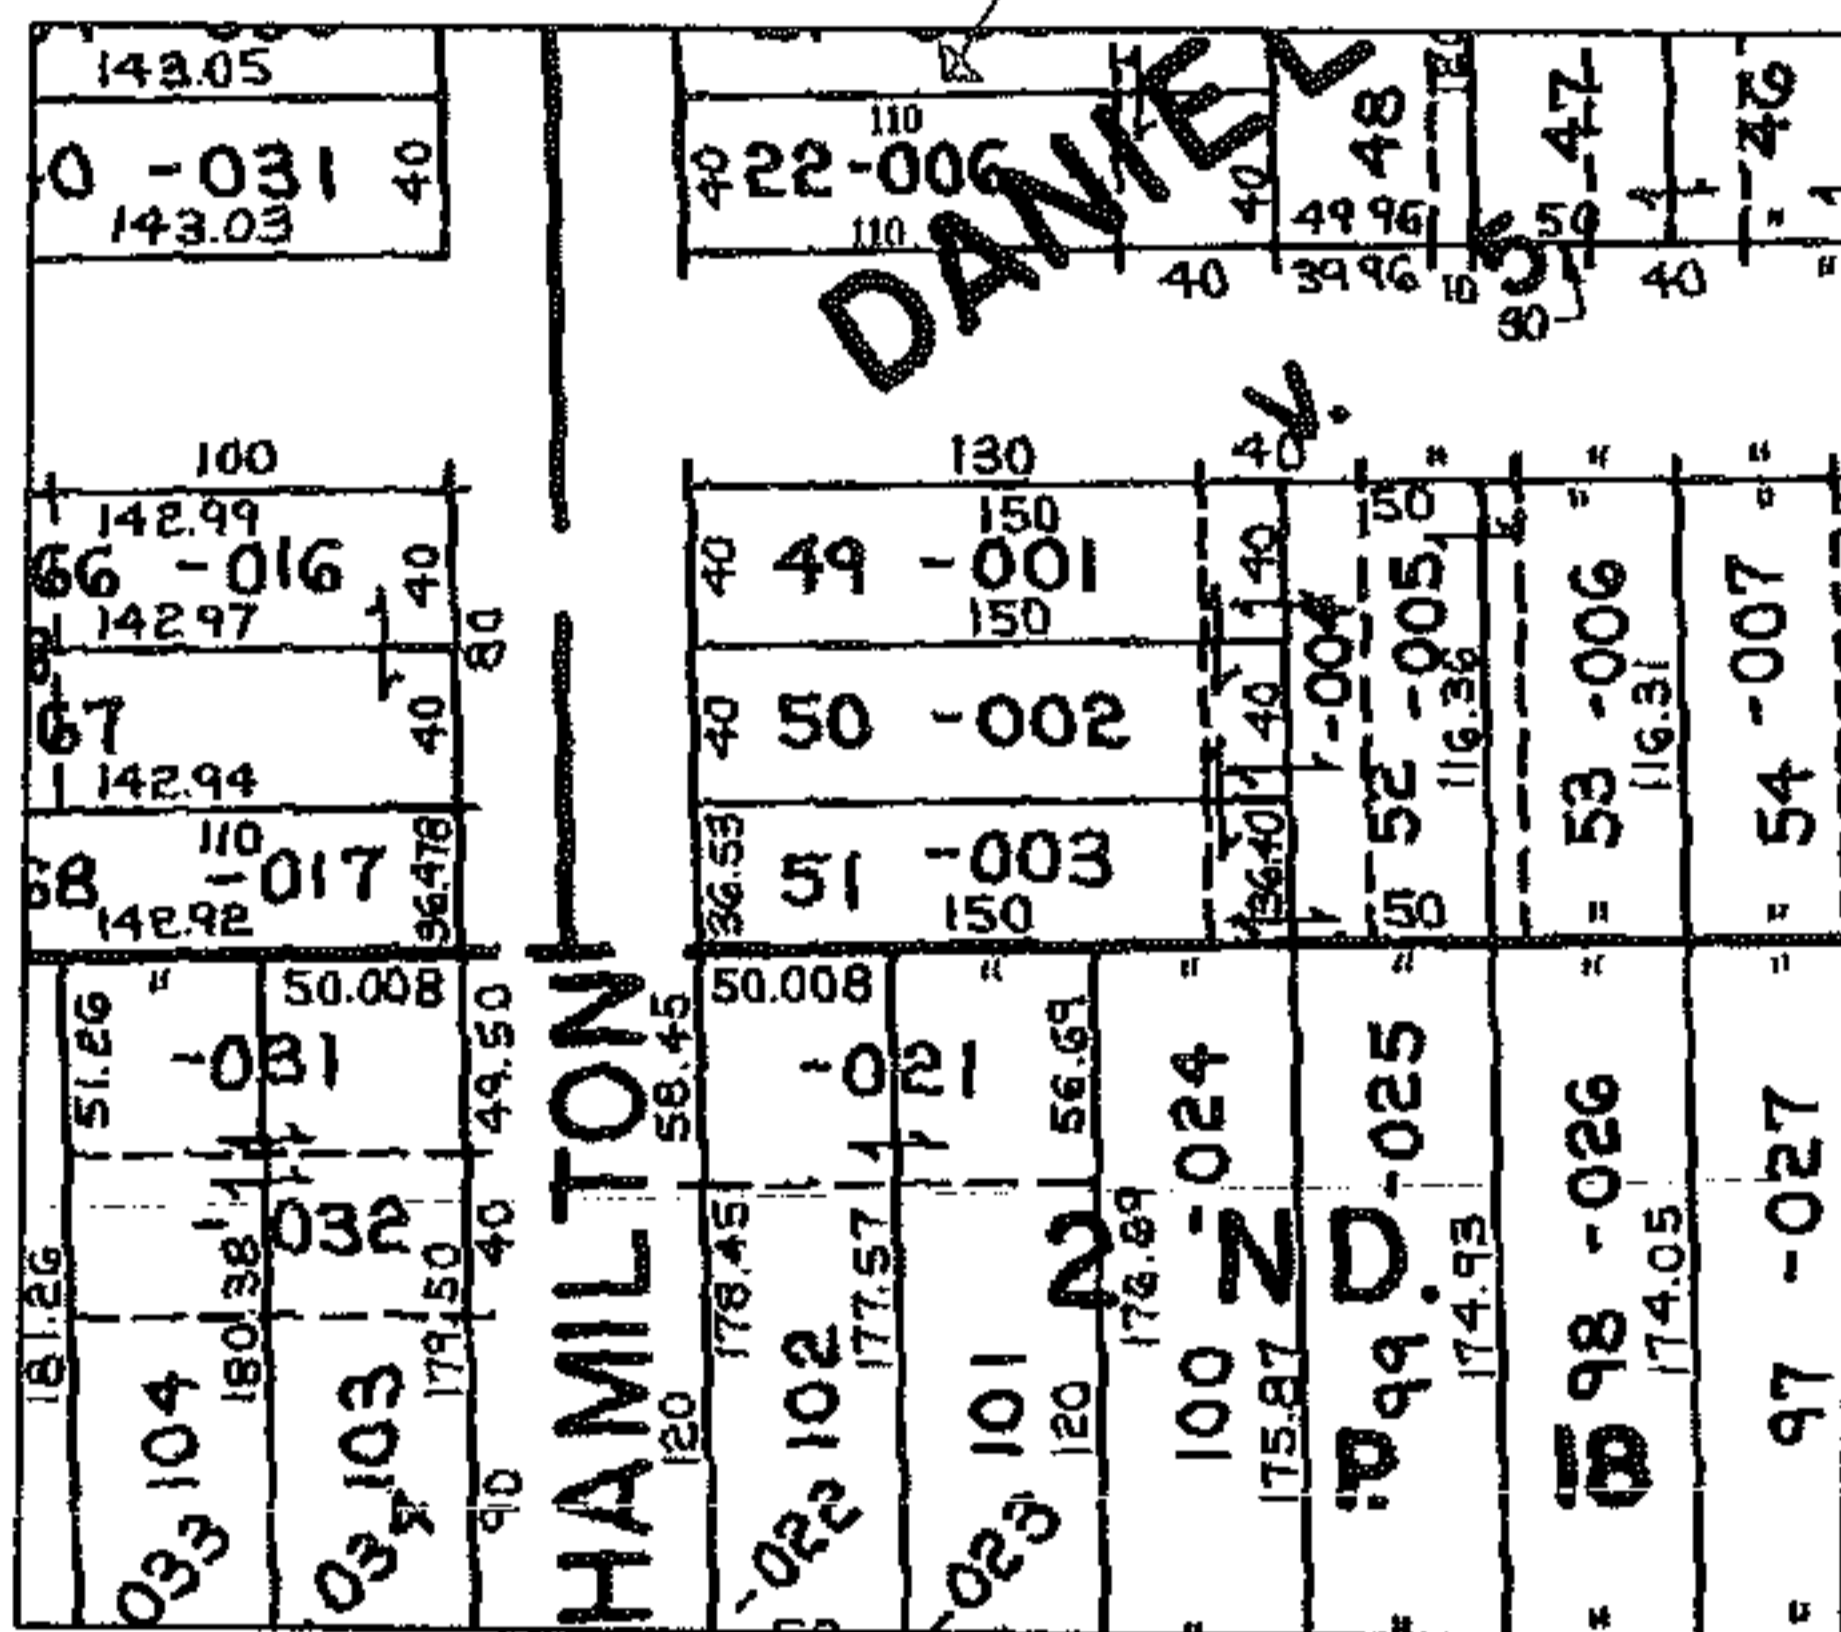

SPLITS/DEEDS PROCESSED
 LORAIN COUNTY TAX MAP DEPARTMENT
 226 MIDDLE AVE. ELYRIA, OHIO

SURVEYED BY: PATRICK A. MCGANNON
 CLOSURE: 1:10,000
 MAP PAGE(S): 02-01-006-C
 APPROVED BY: DRH DATE: 9/7/2004
 SCALE: 1" = 200' PRIOR INSTRUMENT: