

RASTER


PARENT PARCEL: 05-00-037-110-038, 05-00-037-110-035, 05-00-037-110-002

NO. 01064-A

CHILD PARCEL: --SAME--



STARTING POINT: INT CL PARK AVE AND BROADWAY AVE

AC. CORR.
PER SURVEY
DAVID L. ELWELL

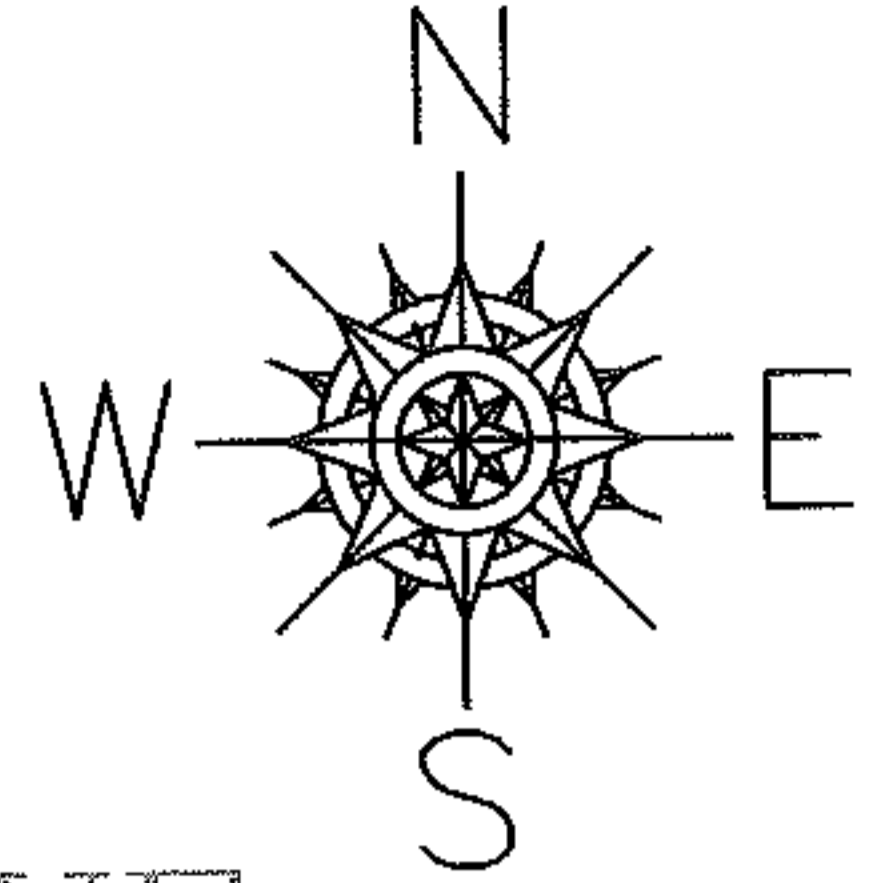

PARK AVE

BROADWAY AVE

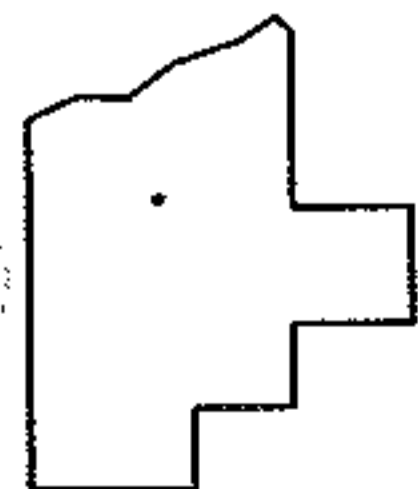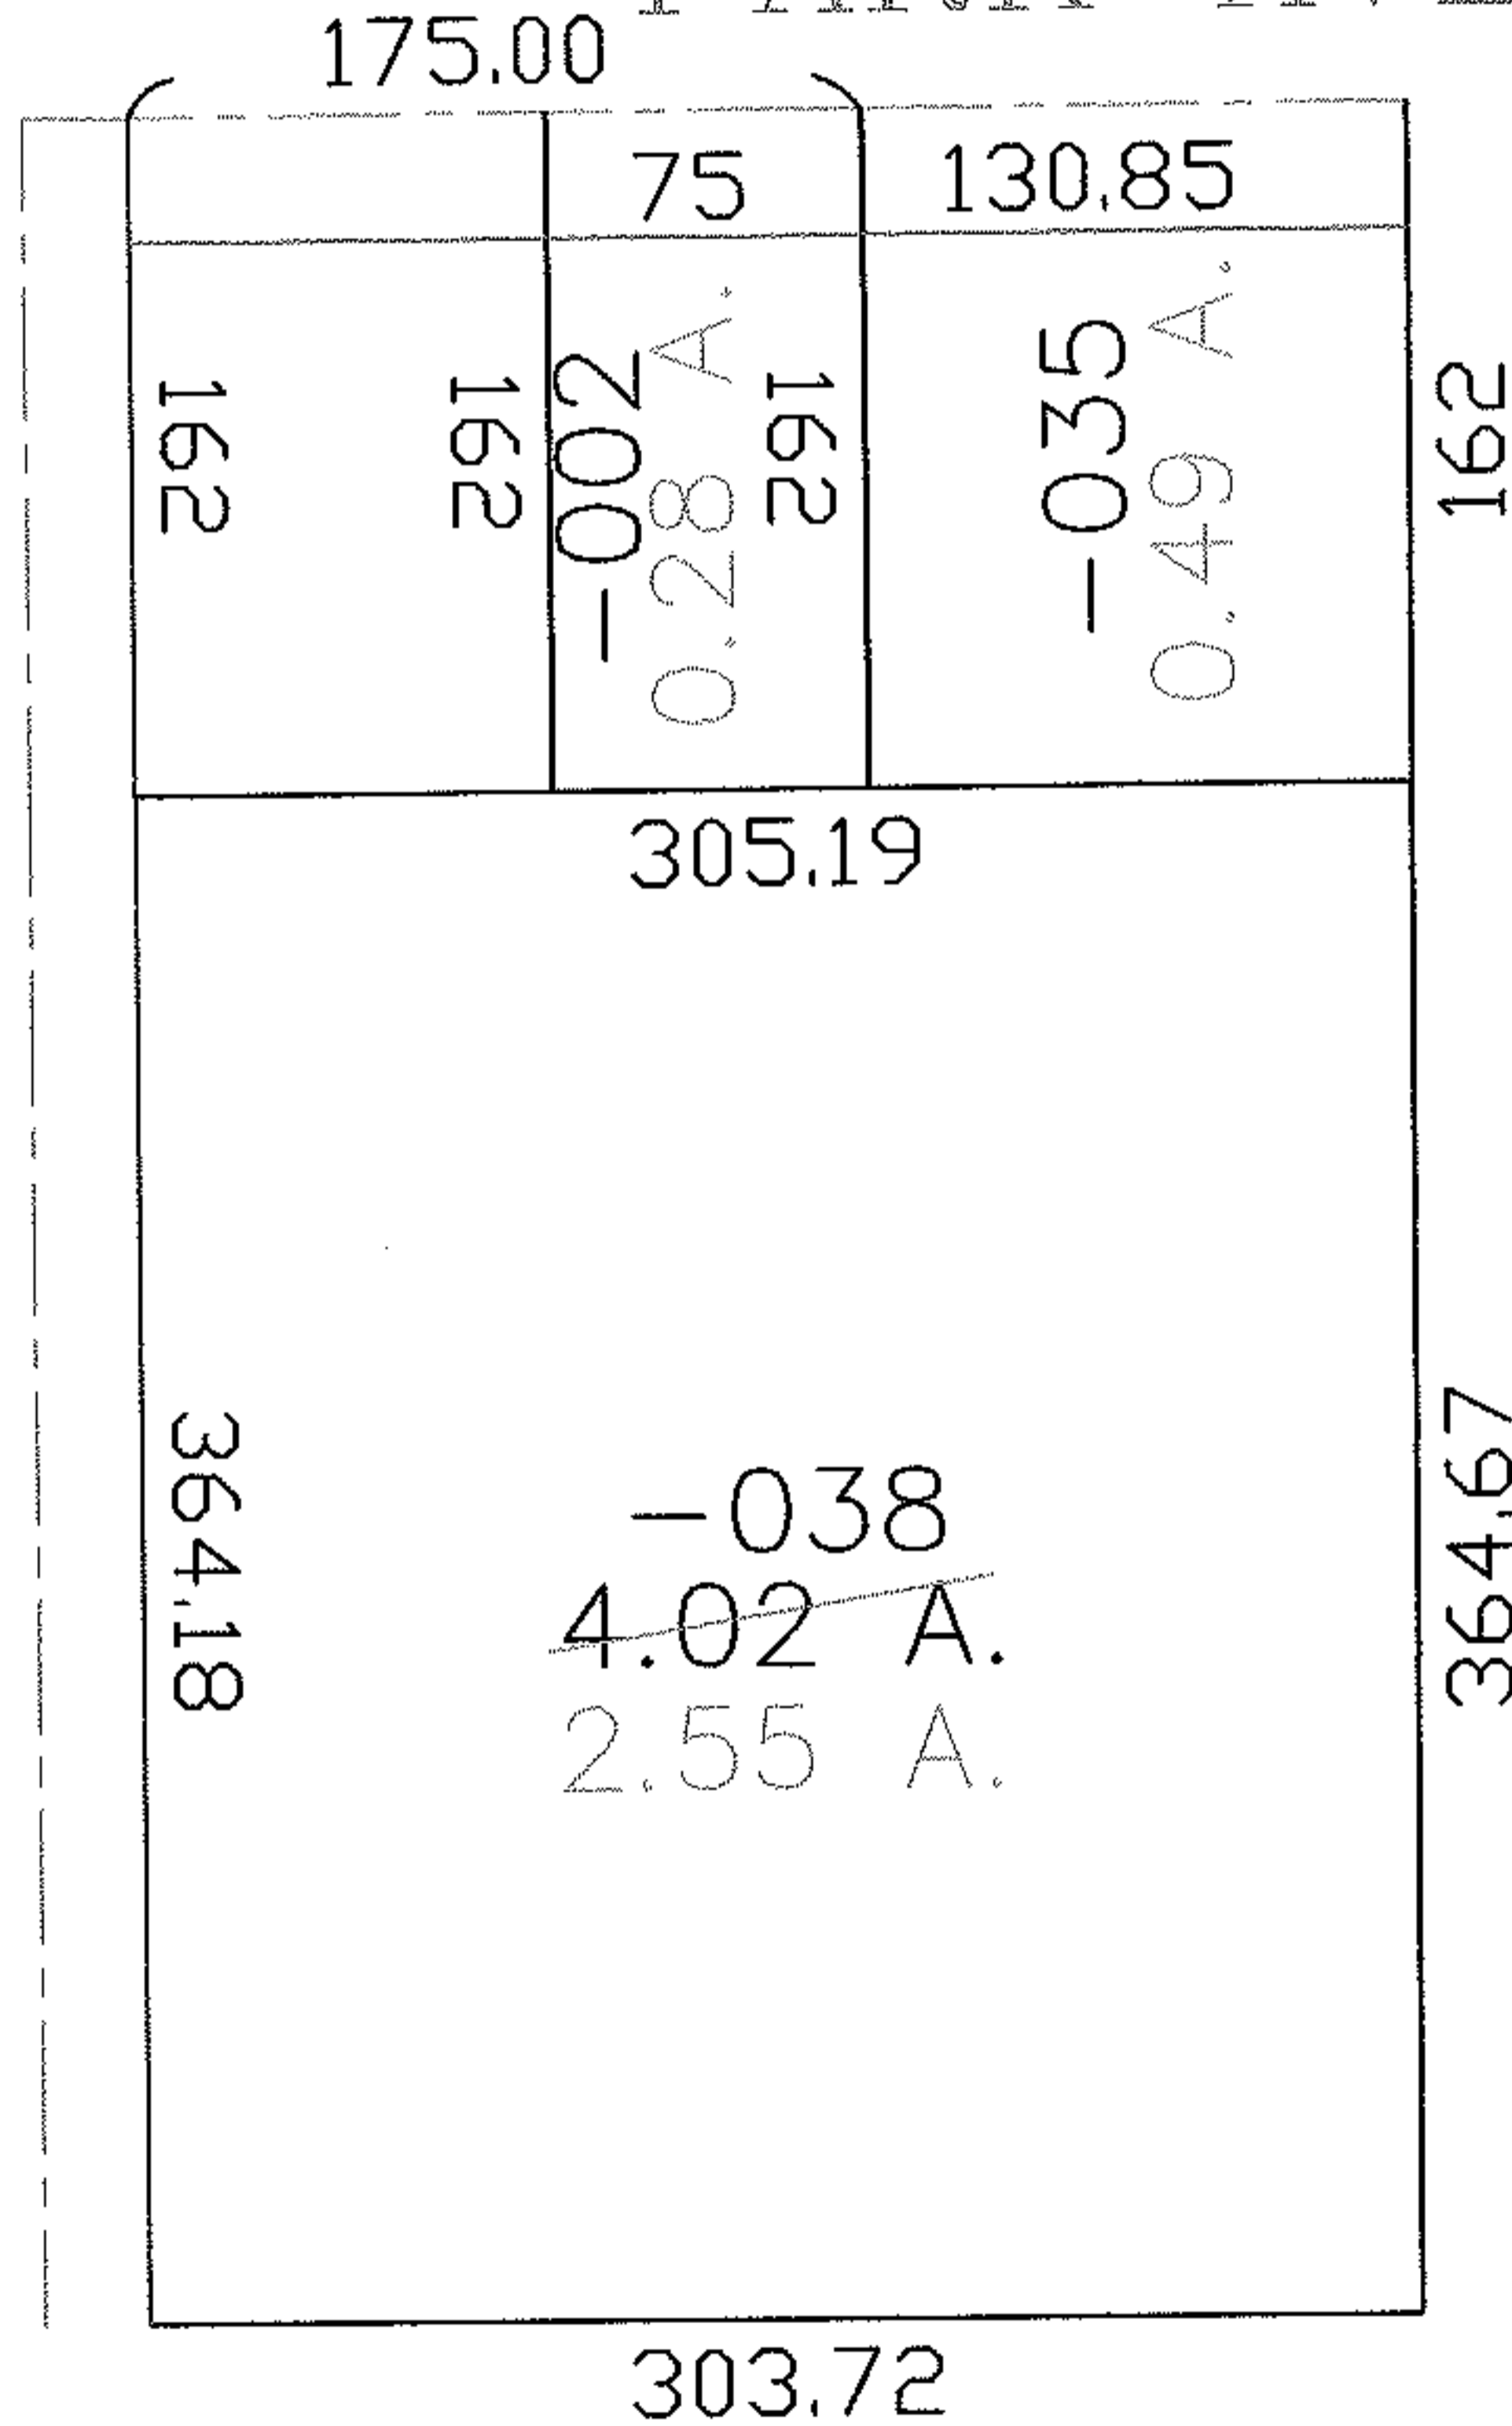

SPLITS/DEEDS PROCESSED

LORAIN COUNTY TAX MAP DEPARTMENT
226 MIDDLE AVE. ELYRIA, OHIO

SURVEYED BY: DAVID L. ELWELL

CLOSURE: 1:10,000

MAP PAGE(S): 05-00-037-B

APPROVED BY: DRH DATE: 10/21/2004

SCALE: 1" = 100' PRIOR INSTRUMENT: