

RASTER



PARENT PARCEL: 01-00-001-109-036

CHILD PARCEL: --SAME--

STARTING POINT:

NO. 01080-A

AC. CORR. PER DEED

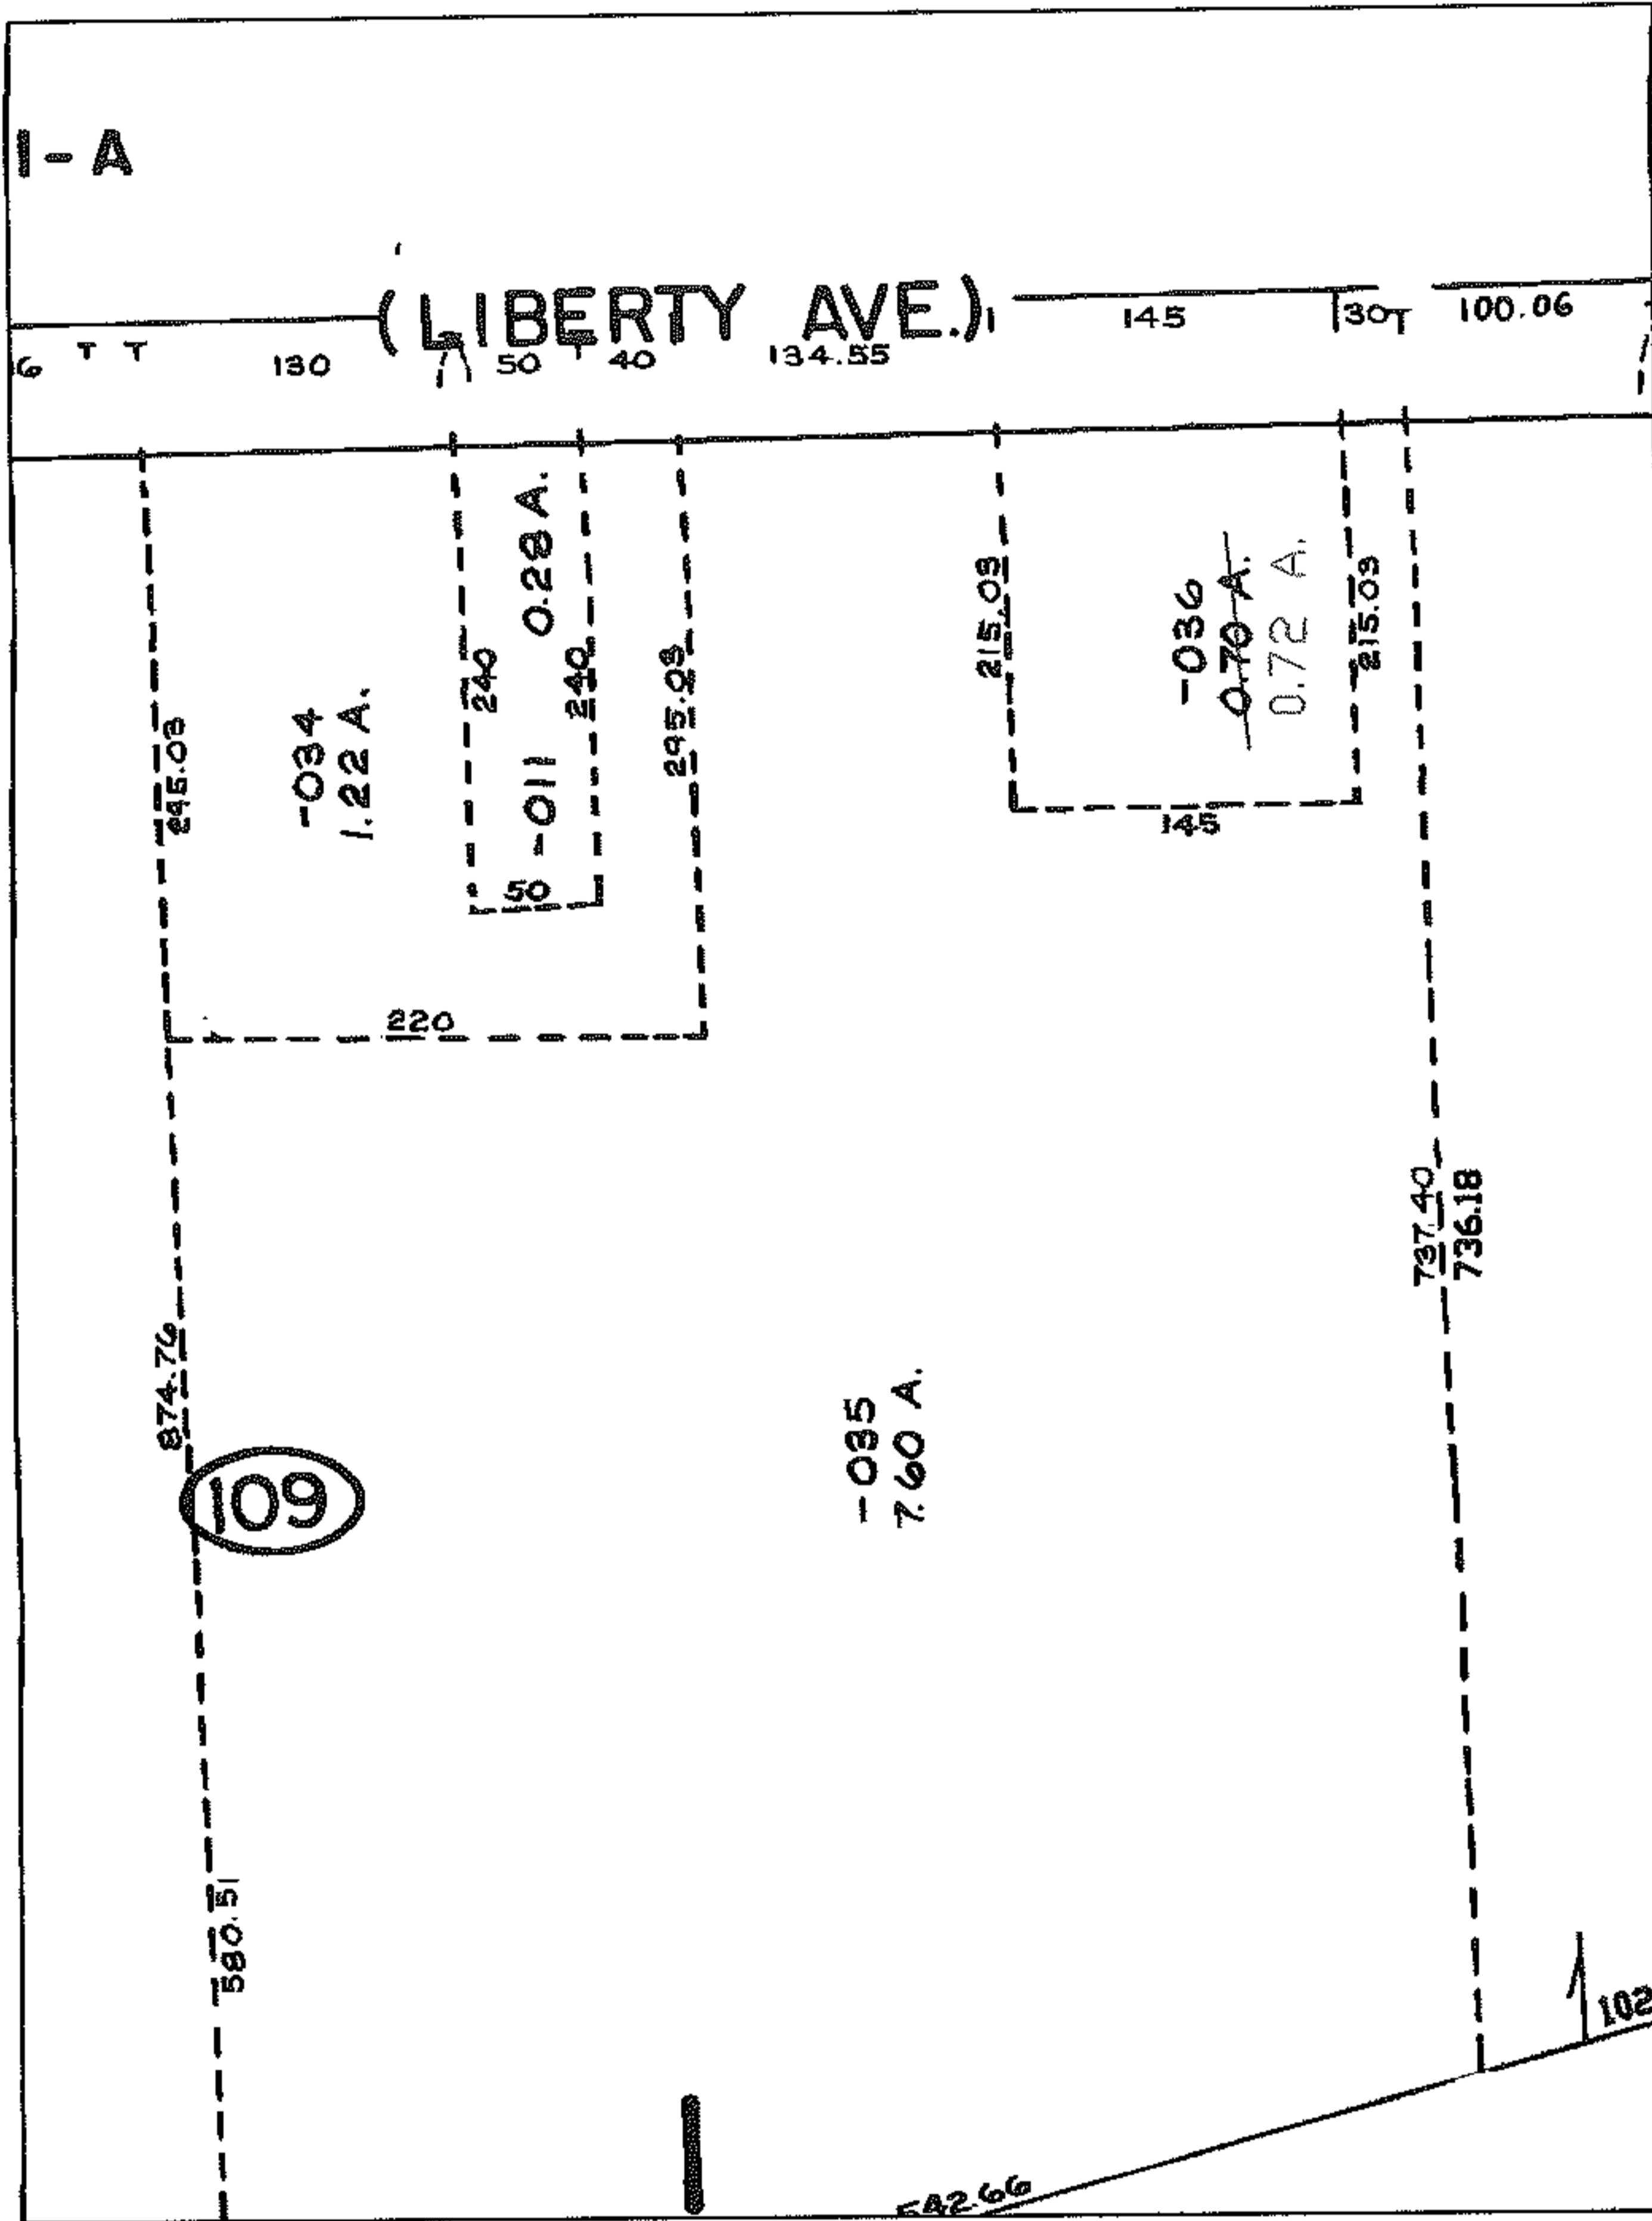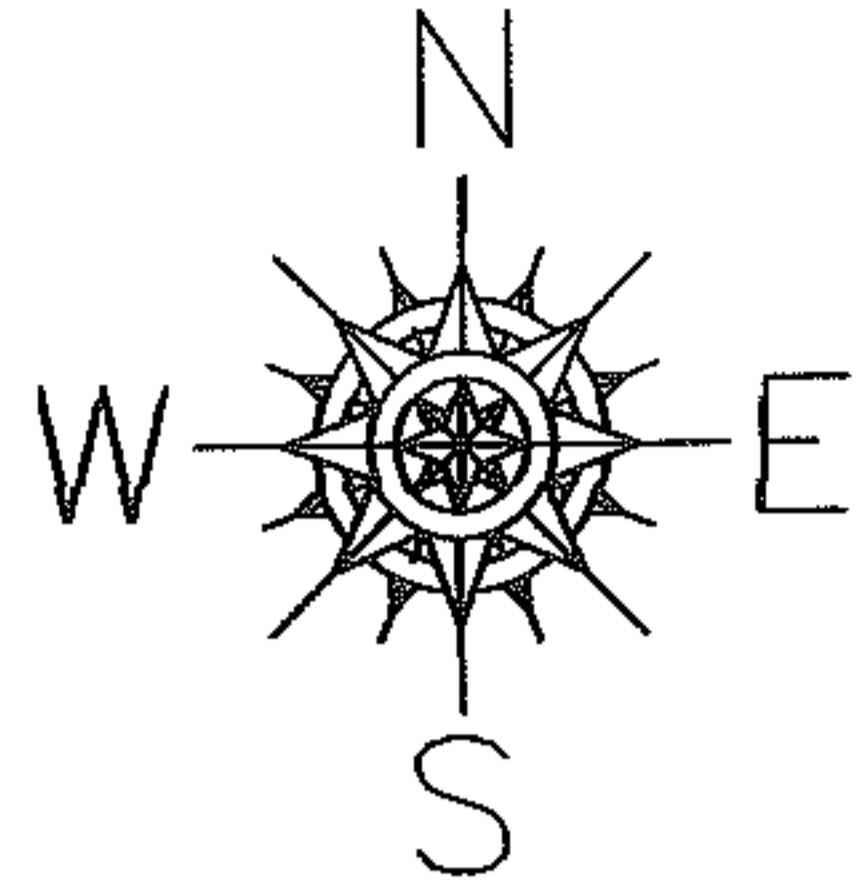

SPLITS/DEEDS PROCESSED
 LORAIN COUNTY TAX MAP DEPARTMENT
 226 MIDDLE AVE. ELYRIA, OHIO

SURVEYED BY: N/A
 CLOSURE: N/A
 MAP PAGE(S): 12/3/2004
 APPROVED BY: DRH DATE: 12/3/2004
 SCALE: 1" = 200 PRIOR INSTRUMENT: 980510215