



MASTER

PARENT PARCEL: 15-00-009-000-025


CHILD PARCEL: --SAME--

STARTING POINT: MON BOX NW CORNER OF O.L. 9

NO. 01082-A

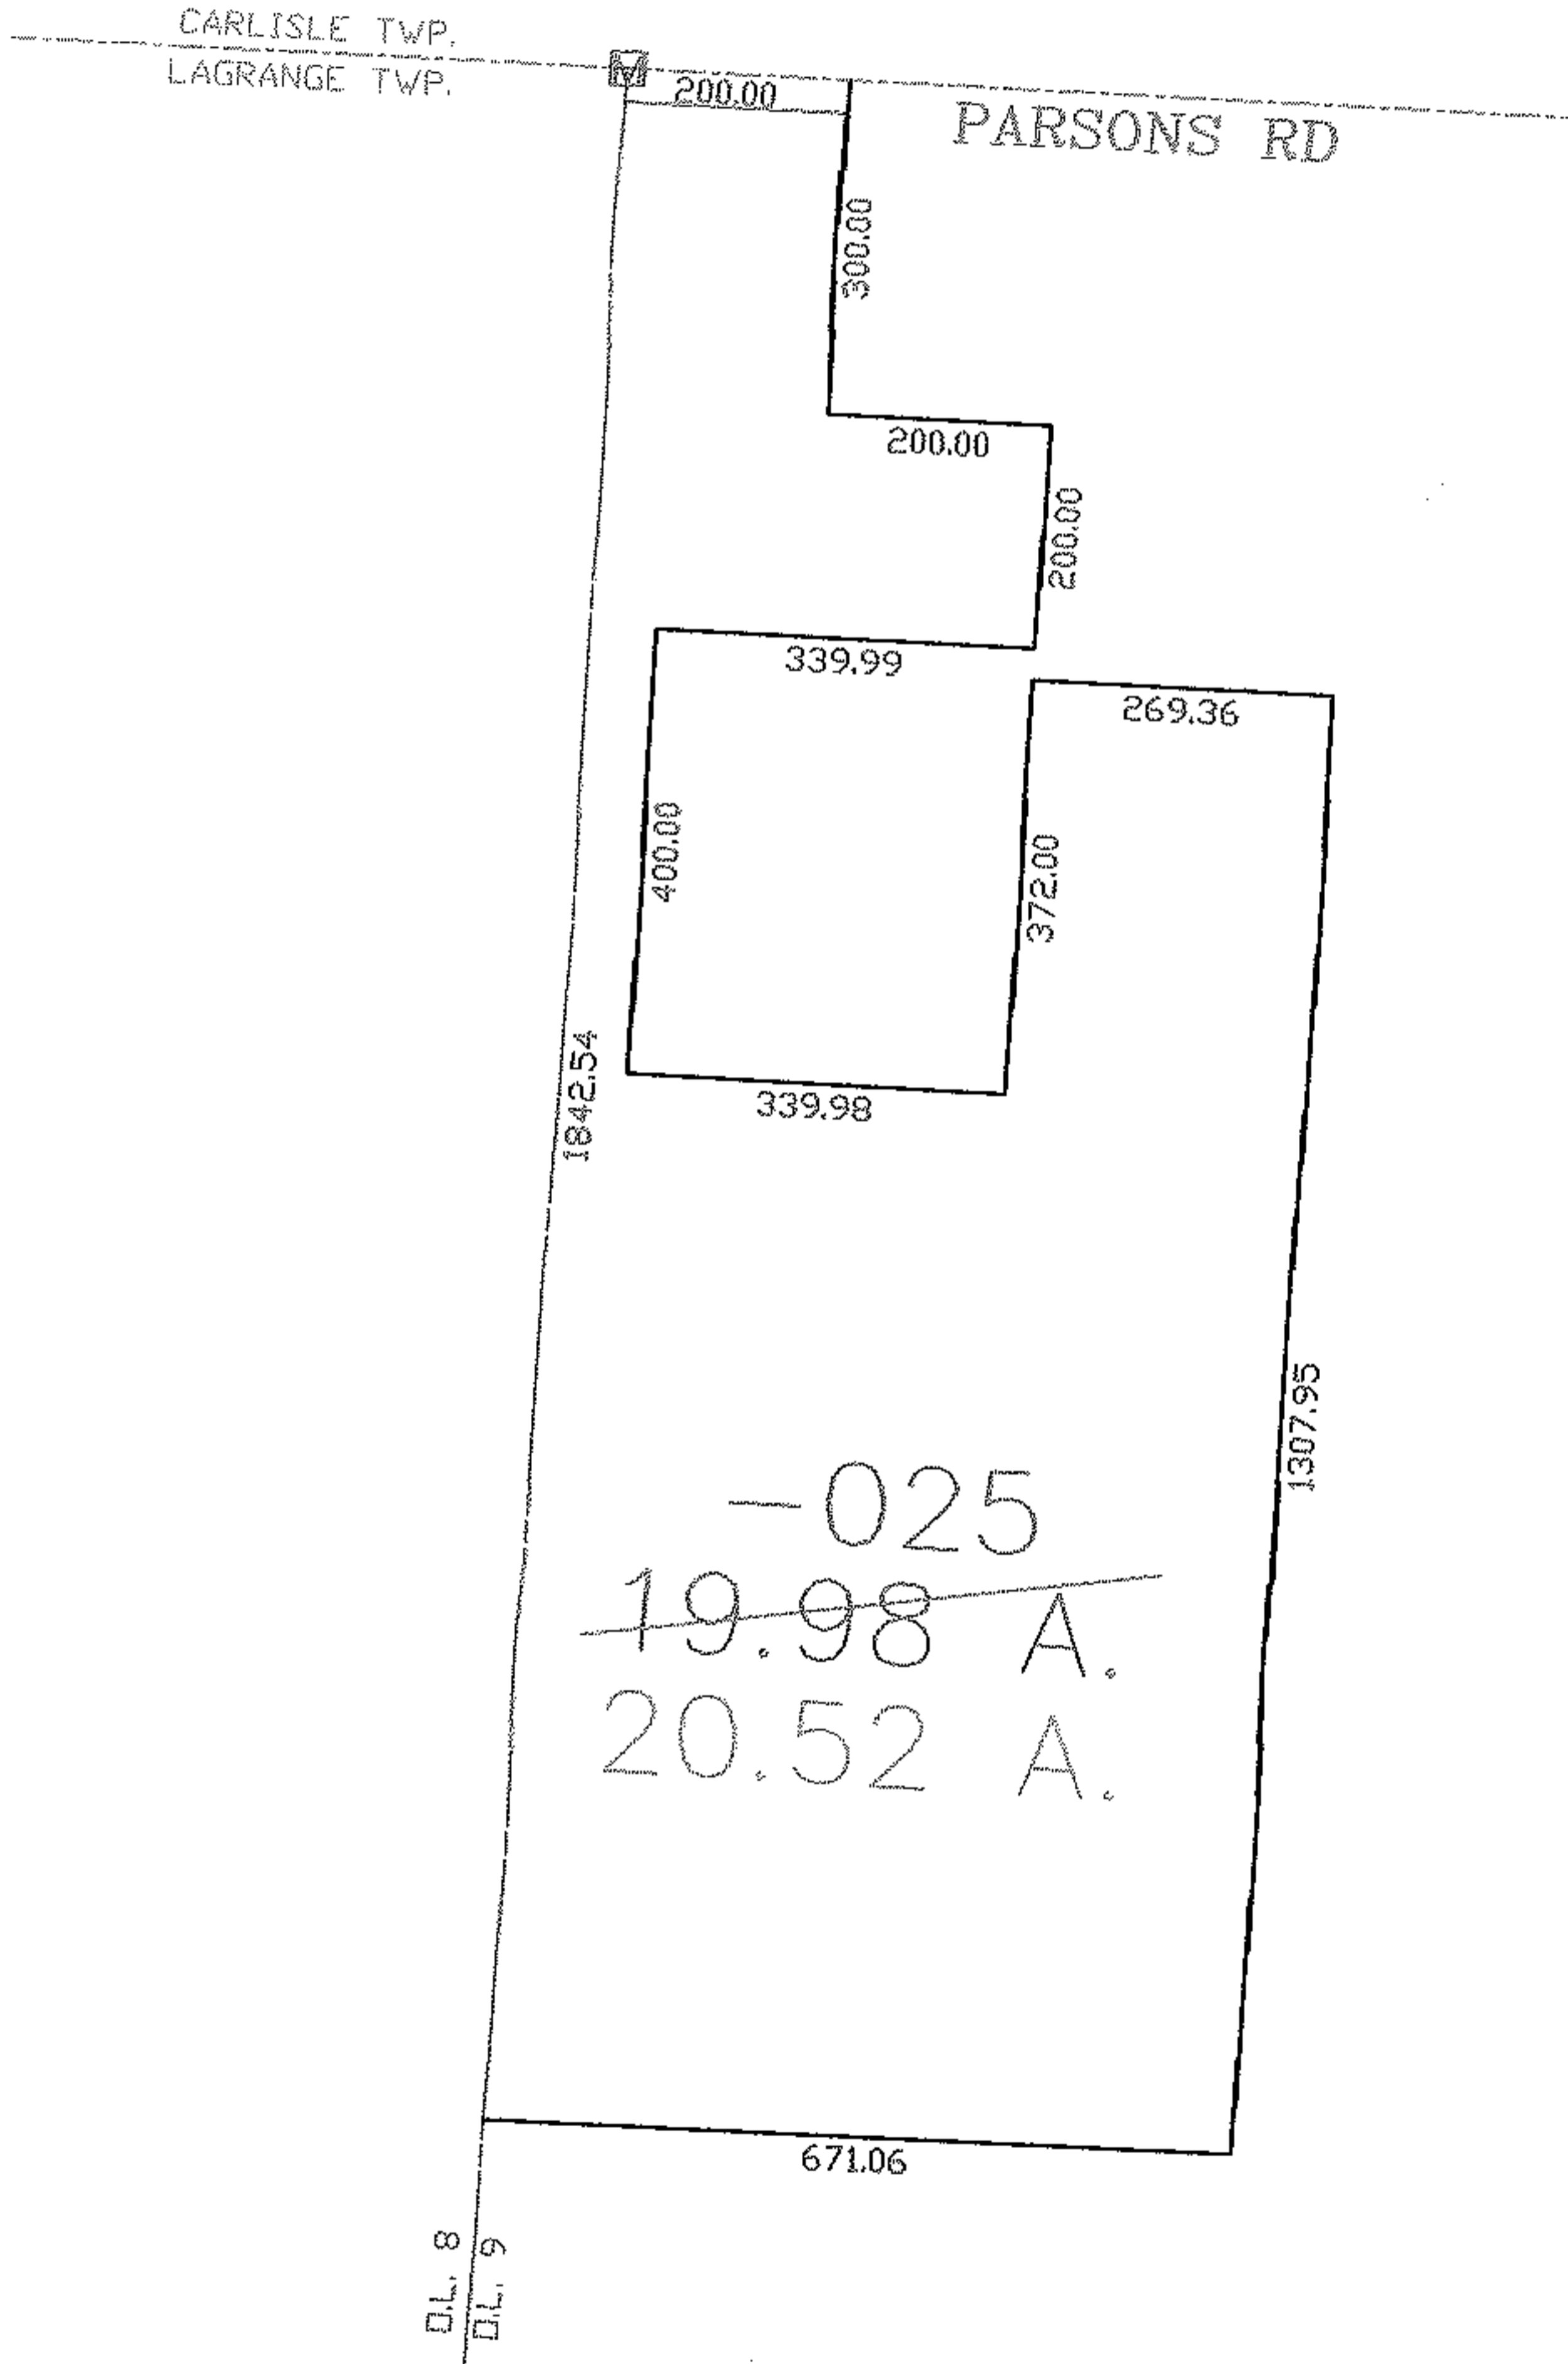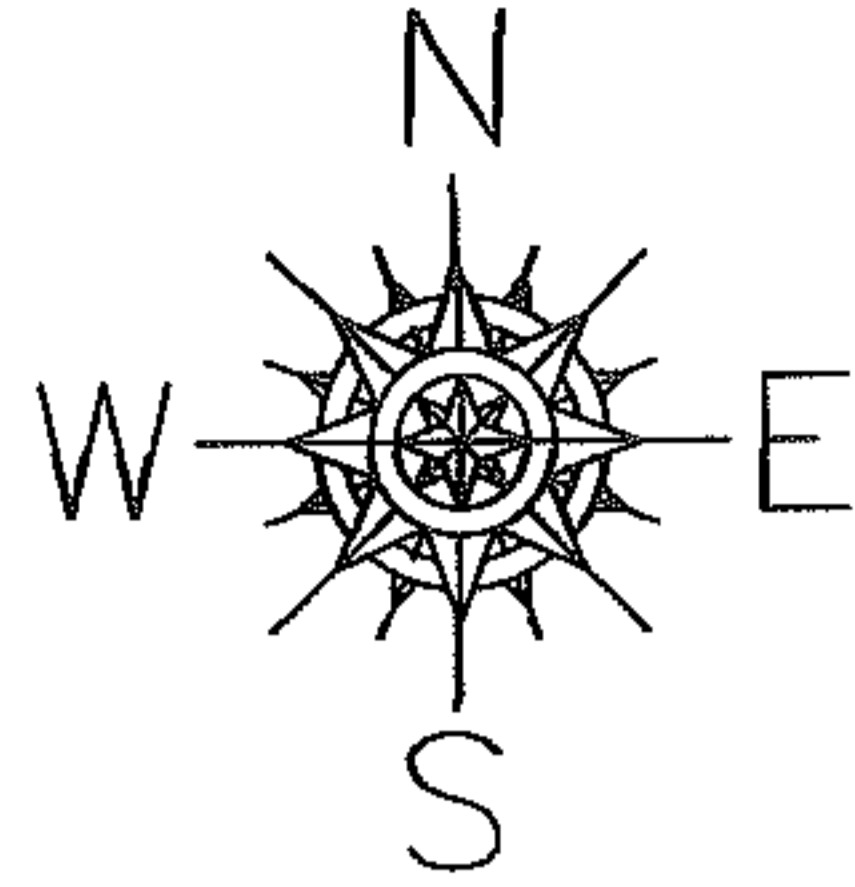

AC. CORR.
PER SURVEY
THOMAS SIMON

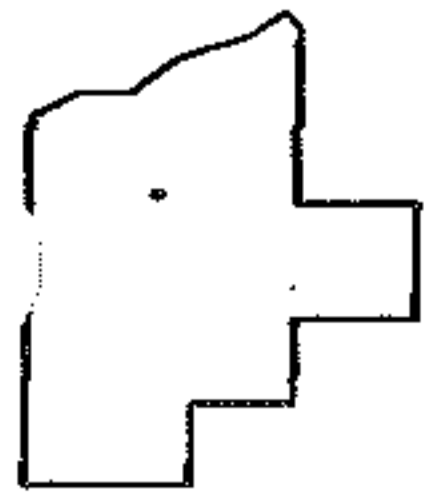

SPLITS/DEEDS PROCESSED
LORAIN COUNTY TAX MAP DEPARTMENT
226 MIDDLE AVE. ELYRIA, OHIO

SURVEYED BY: THOMAS SIMON
 CLOSURE: 1:10,000
 MAP PAGE(S): 15-D
 APPROVED BY: DRH DATE: 12/6/2004
 SCALE: 1" = 300 PRIOR INSTRUMENT: _____