

RASTER



PARENT PARCEL: 01-00-038-000-013

NO. 01087-A

CHILD PARCEL: --SAME--

STARTING POINT: INT CL NORTH RIDGE RD AND CL BAUMHART RD

AC. CORR.  
PER SURVEY  
ALEX KELSER

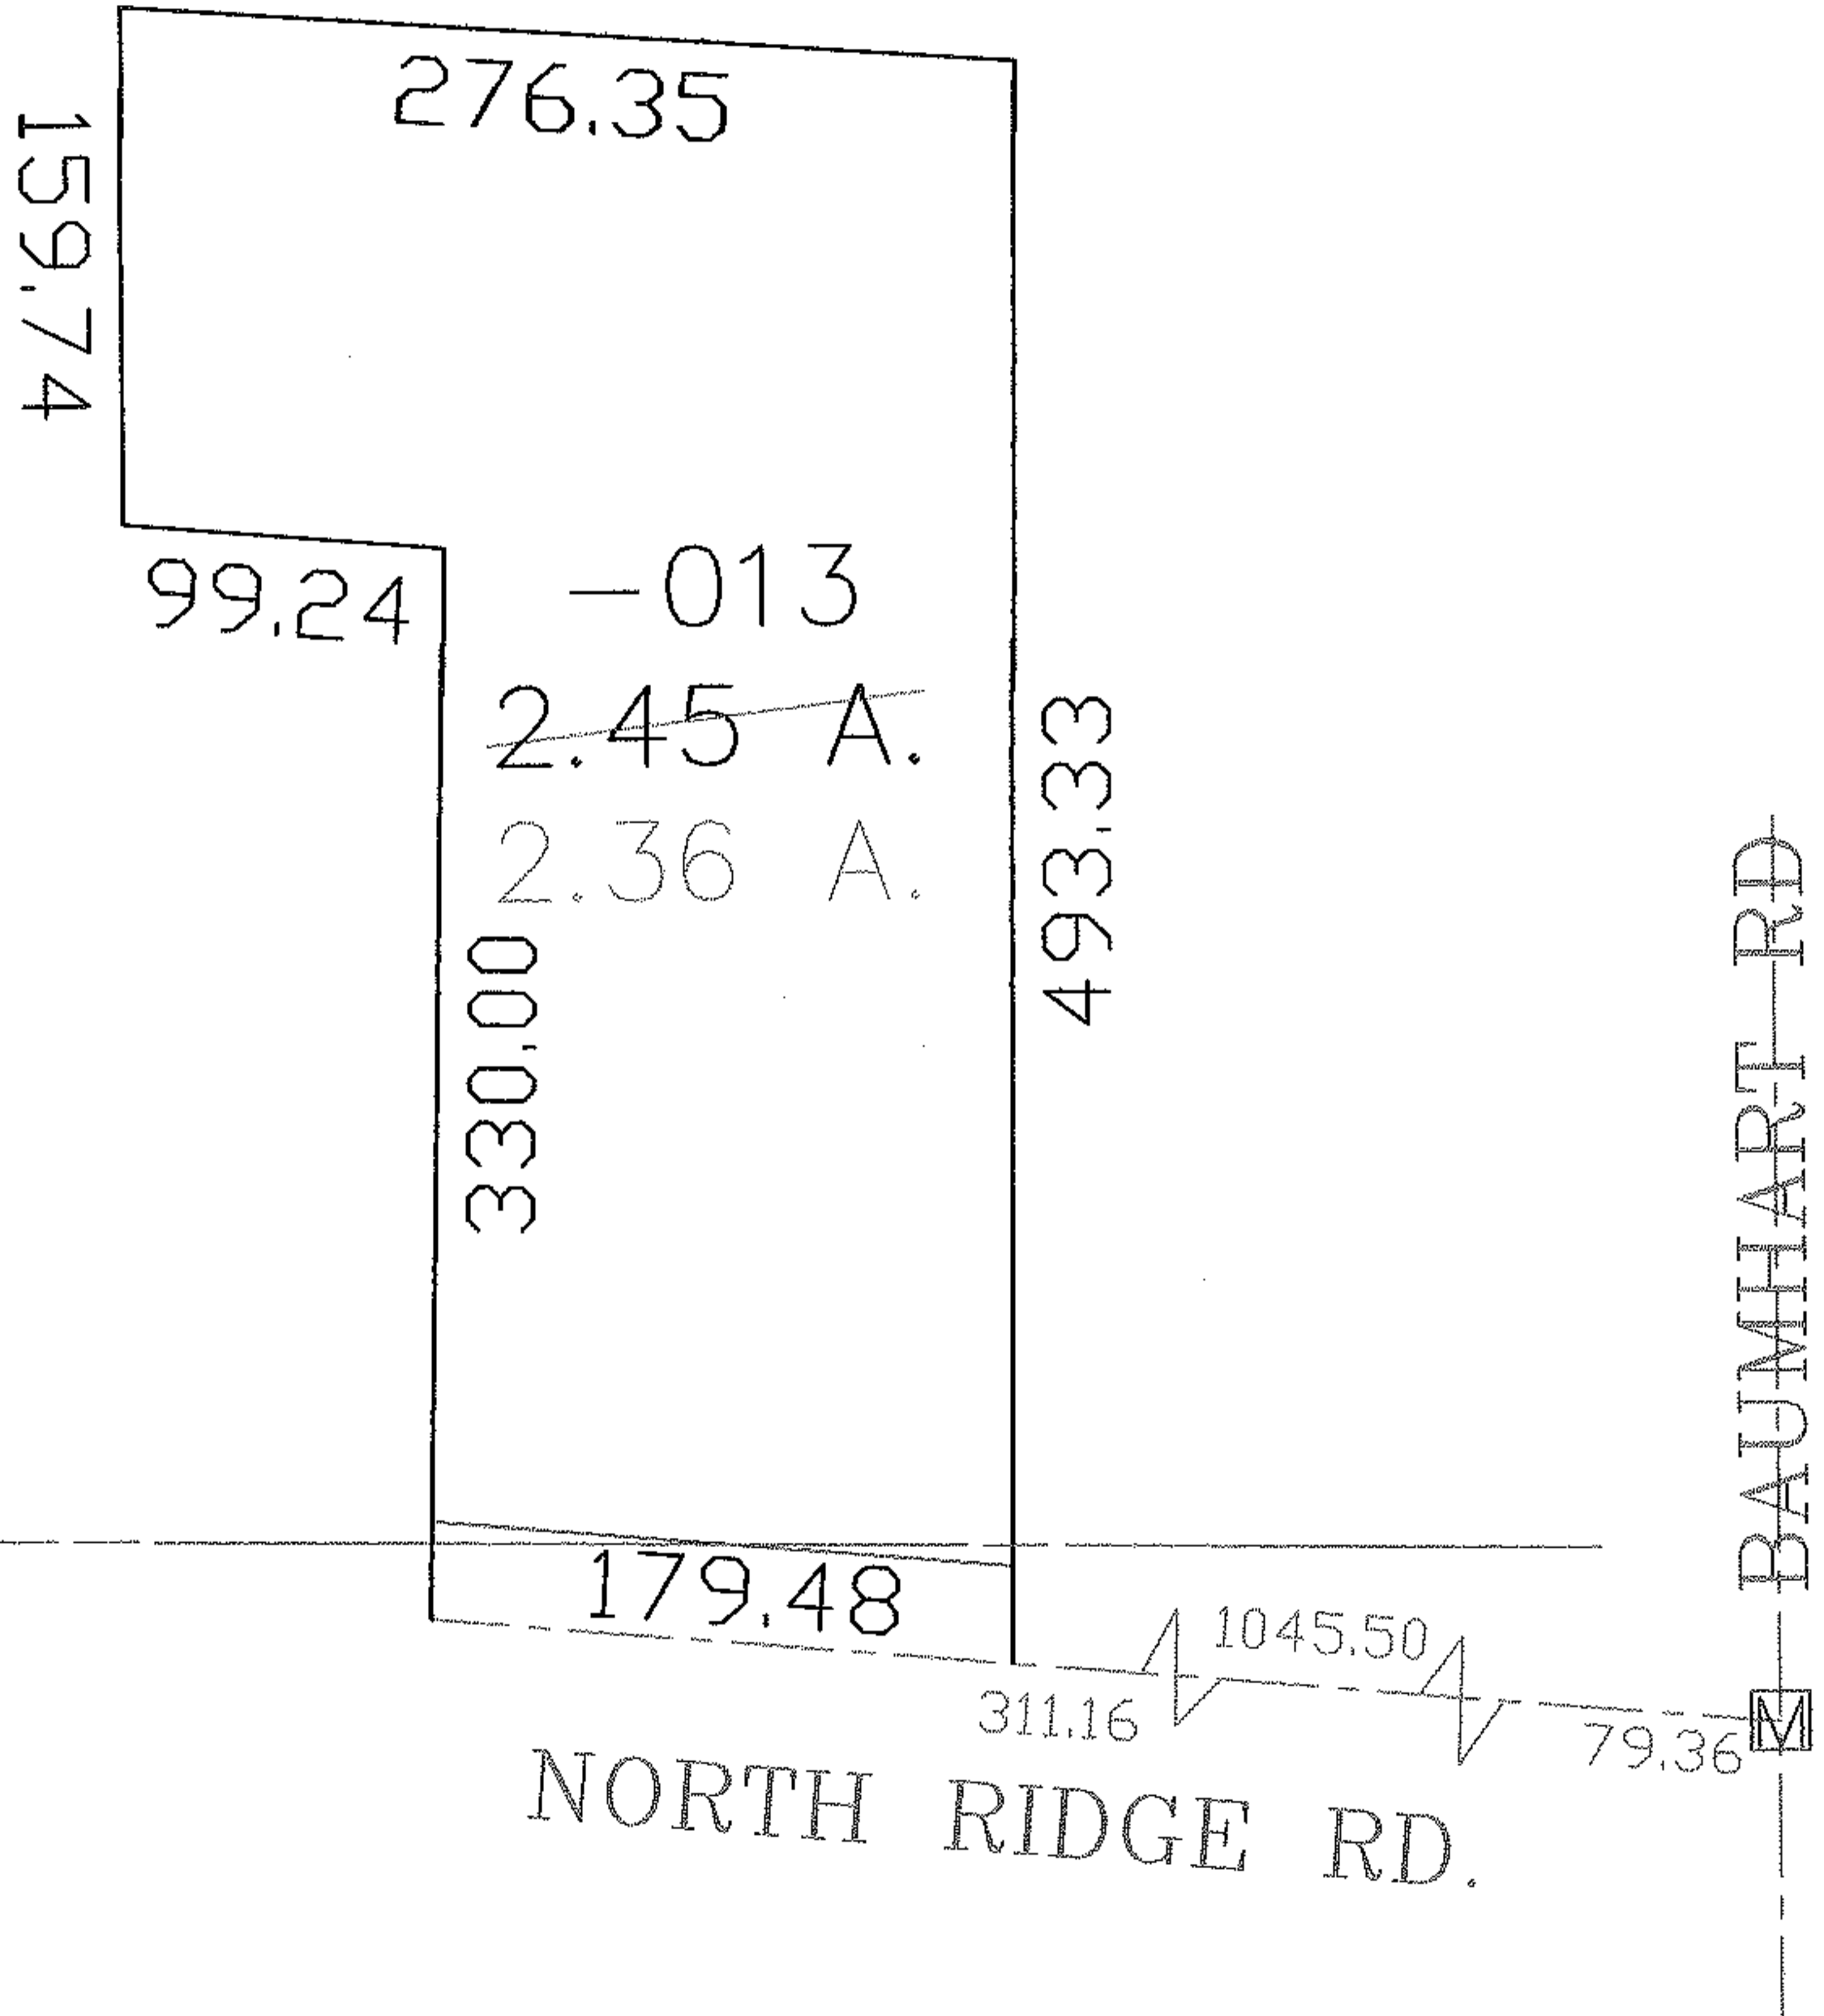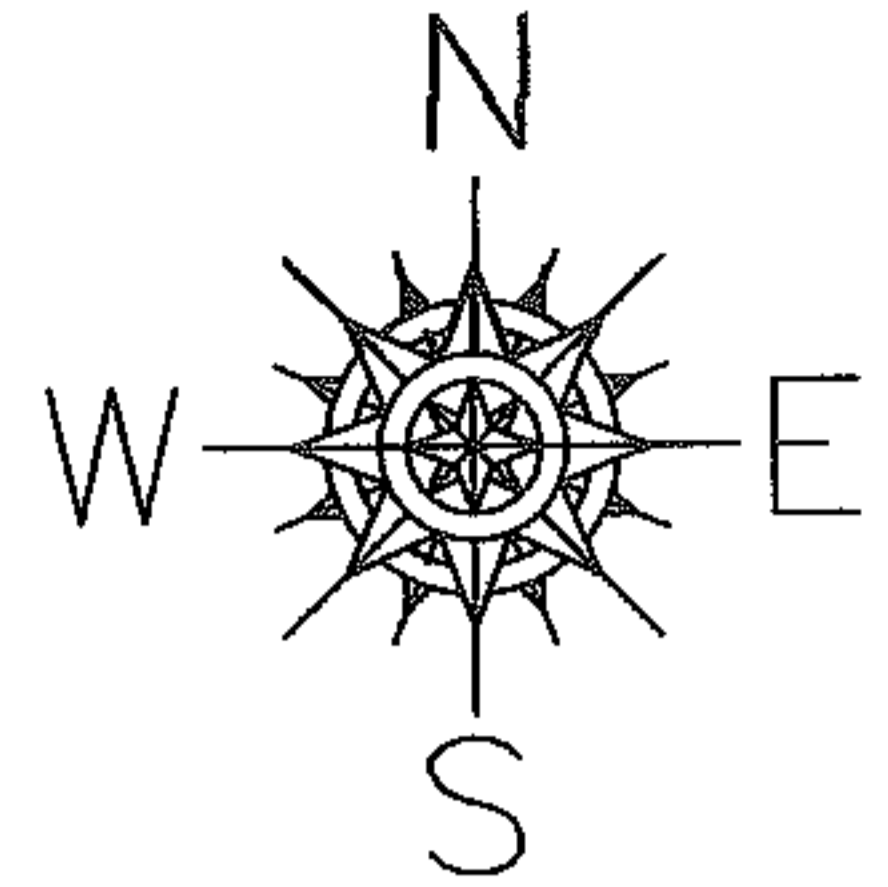

-013  
~~2.45 A.~~  
2.36 A.

D.L. 38  
D.L. 43



SPLITS/DEEDS PROCESSED

LORAIN COUNTY TAX MAP DEPARTMENT  
226 MIDDLE AVE. ELYRIA, OHIO

SURVEYED BY: ALEX KELSER  
CLOSURE: 1:10,000  
MAP PAGE(S): 01-00-038-A  
APPROVED BY: DRH DATE: 12/17/2004  
SCALE: 1" = 100 PRIOR INSTRUMENT: 20010728772