

RASTER


PARENT PARCEL: 13-11-012-000-001

CHILD PARCEL: --SAME--

STARTING POINT: SE CORNER O.L. 12

NO. 01096-D

AC. CORR
PER SURVEY
PHILLIP ROSEBECK

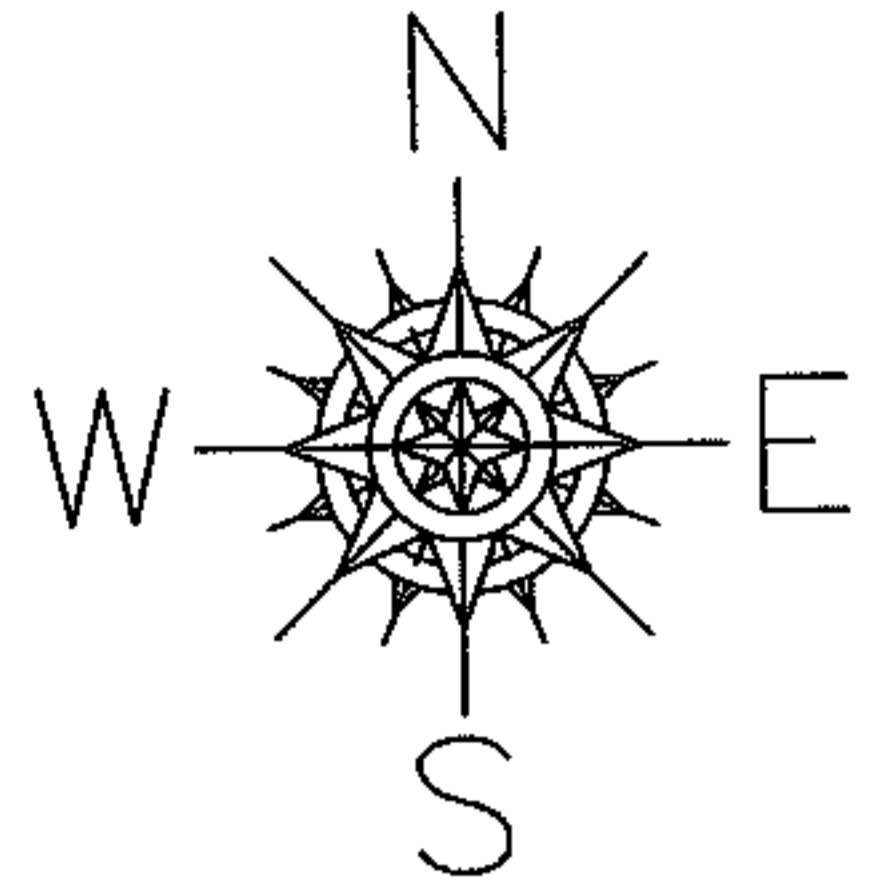

O.L. 8 O.L. 9
O.L. 13 O.L. 12

1846.09

2139.43


-001
~~90.00~~ A.
90.92 A.

2142.97

BAUMHART RD

1854.17

O.L. 13
O.L. 12

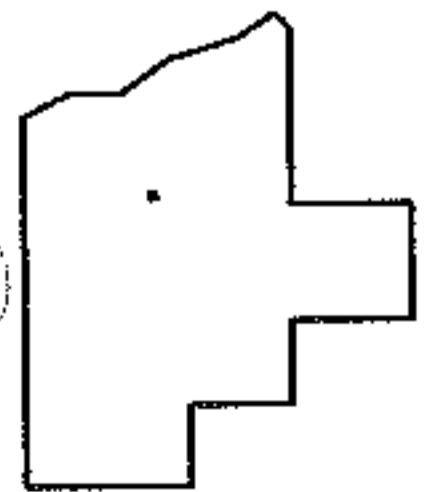

SPLITS/DEEDS PROCESSED
LORAIN COUNTY TAX MAP DEPARTMENT
226 MIDDLE AVE. ELYRIA, OHIO

SURVEYED BY: PHILLIP ROSEBECK
CLOSURE: 1:10,000
MAP PAGE(S): 13-11-012
APPROVED BY: DRH DATE: 1/14/2005
SCALE: 1" = 400' PRIOR INSTRUMENT: 20040999511