

RASTER



PARENT PARCEL: 03-00-073-000-055, 03-00-074-101-008

NO. 01098-A

CHILD PARCEL: --SAME--

STARTING POINT: MON BOX INT EAST RIVER RD AND STATE ROUTE 254

AC. CORR.  
PER SURVEY  
C. HIRZEL

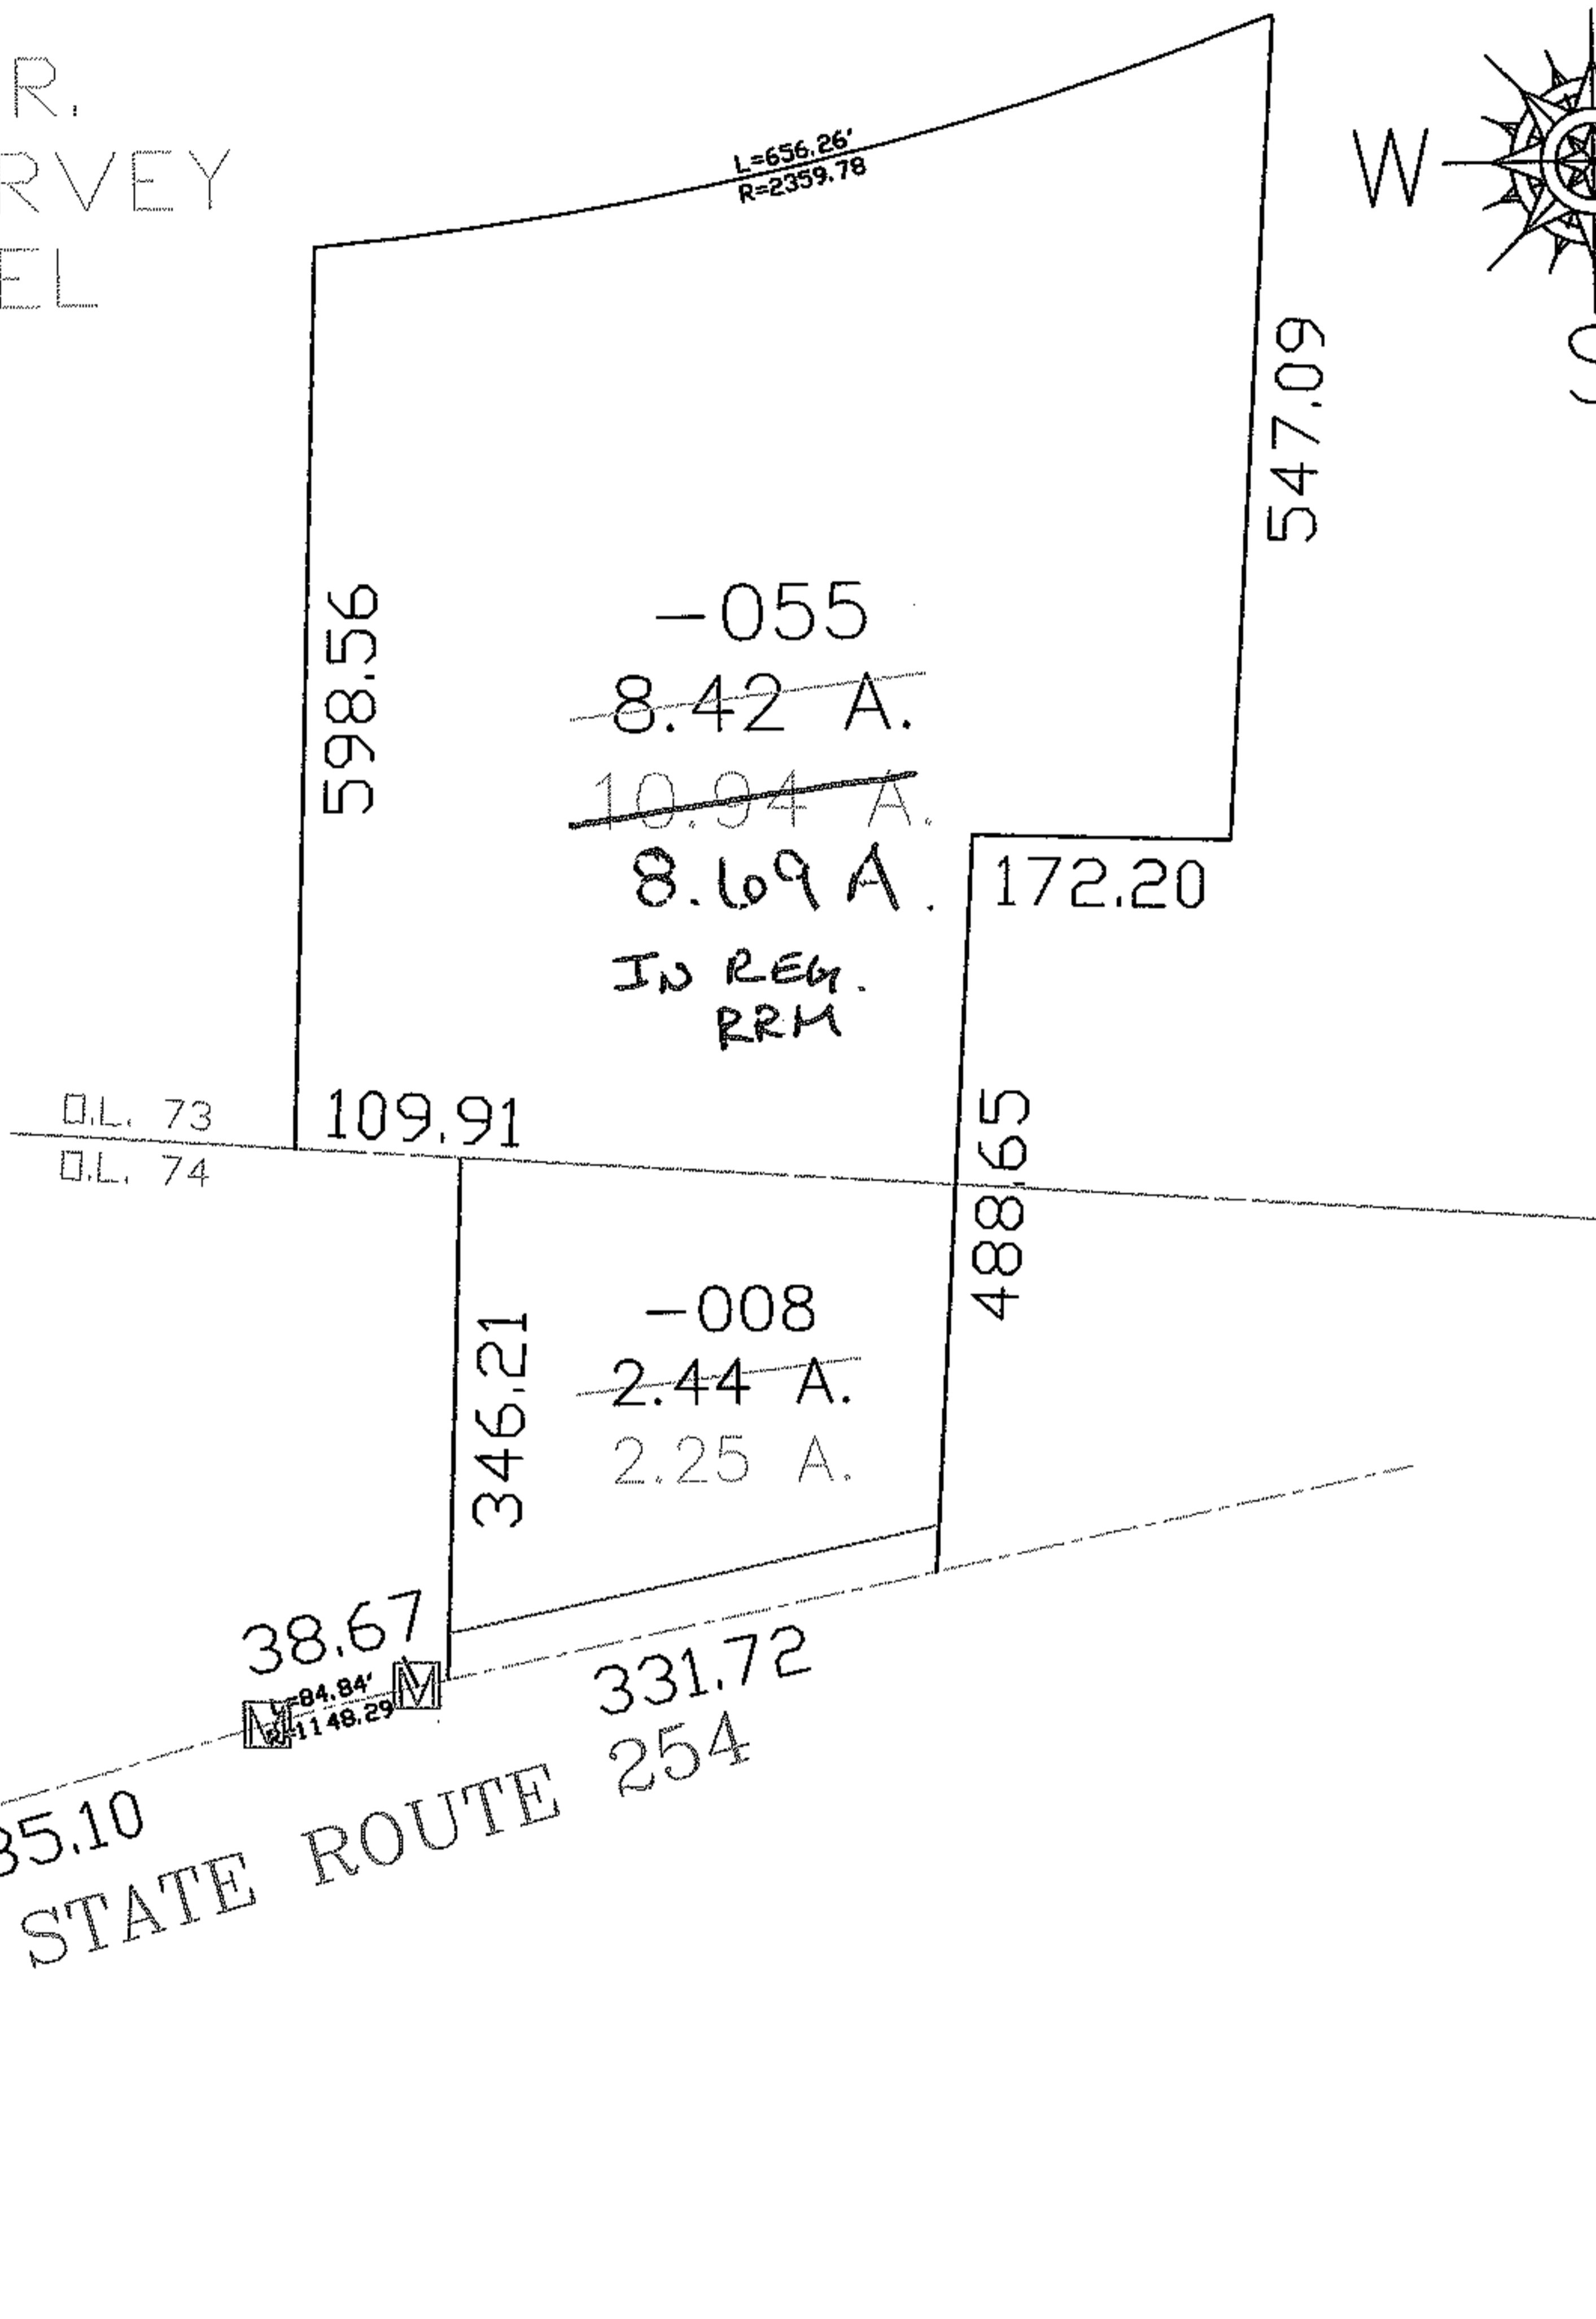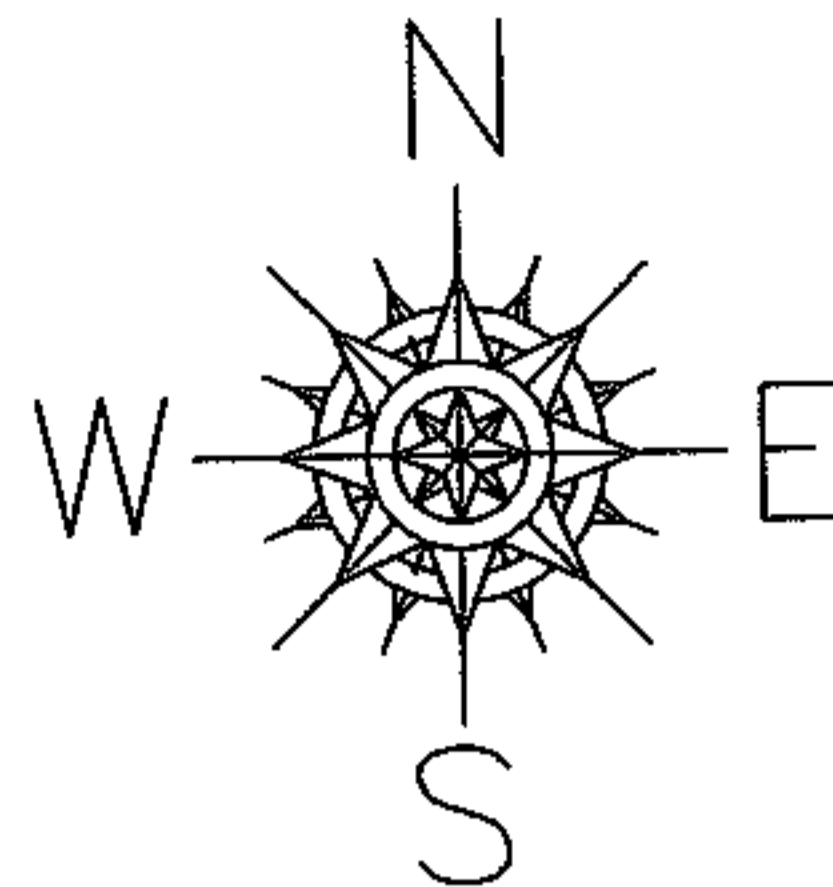

**SPLITS/DEEDS PROCESSED**  
LORAIN COUNTY TAX MAP DEPARTMENT  
226 MIDDLE AVE. ELYRIA, OHIO

SURVEYED BY: CHRISTOPHER HIRZEL  
CLOSURE: 1:10,000  
MAP PAGE(S): 03-00-073-A  
APPROVED BY: DRH DATE: 1/19/2005  
SCALE: 1" = 200' PRIOR INSTRUMENT: 20000712990