

RASTER



PARENT PARCEL: 04-00-008-104-092, -093

NO. 01099-D

CHILD PARCEL: --SAME--

STARTING POINT: PING N ROW PIN OAK PARKWAY

AC. CORR.
PER SURVEY
TIMOTHY R. DURR

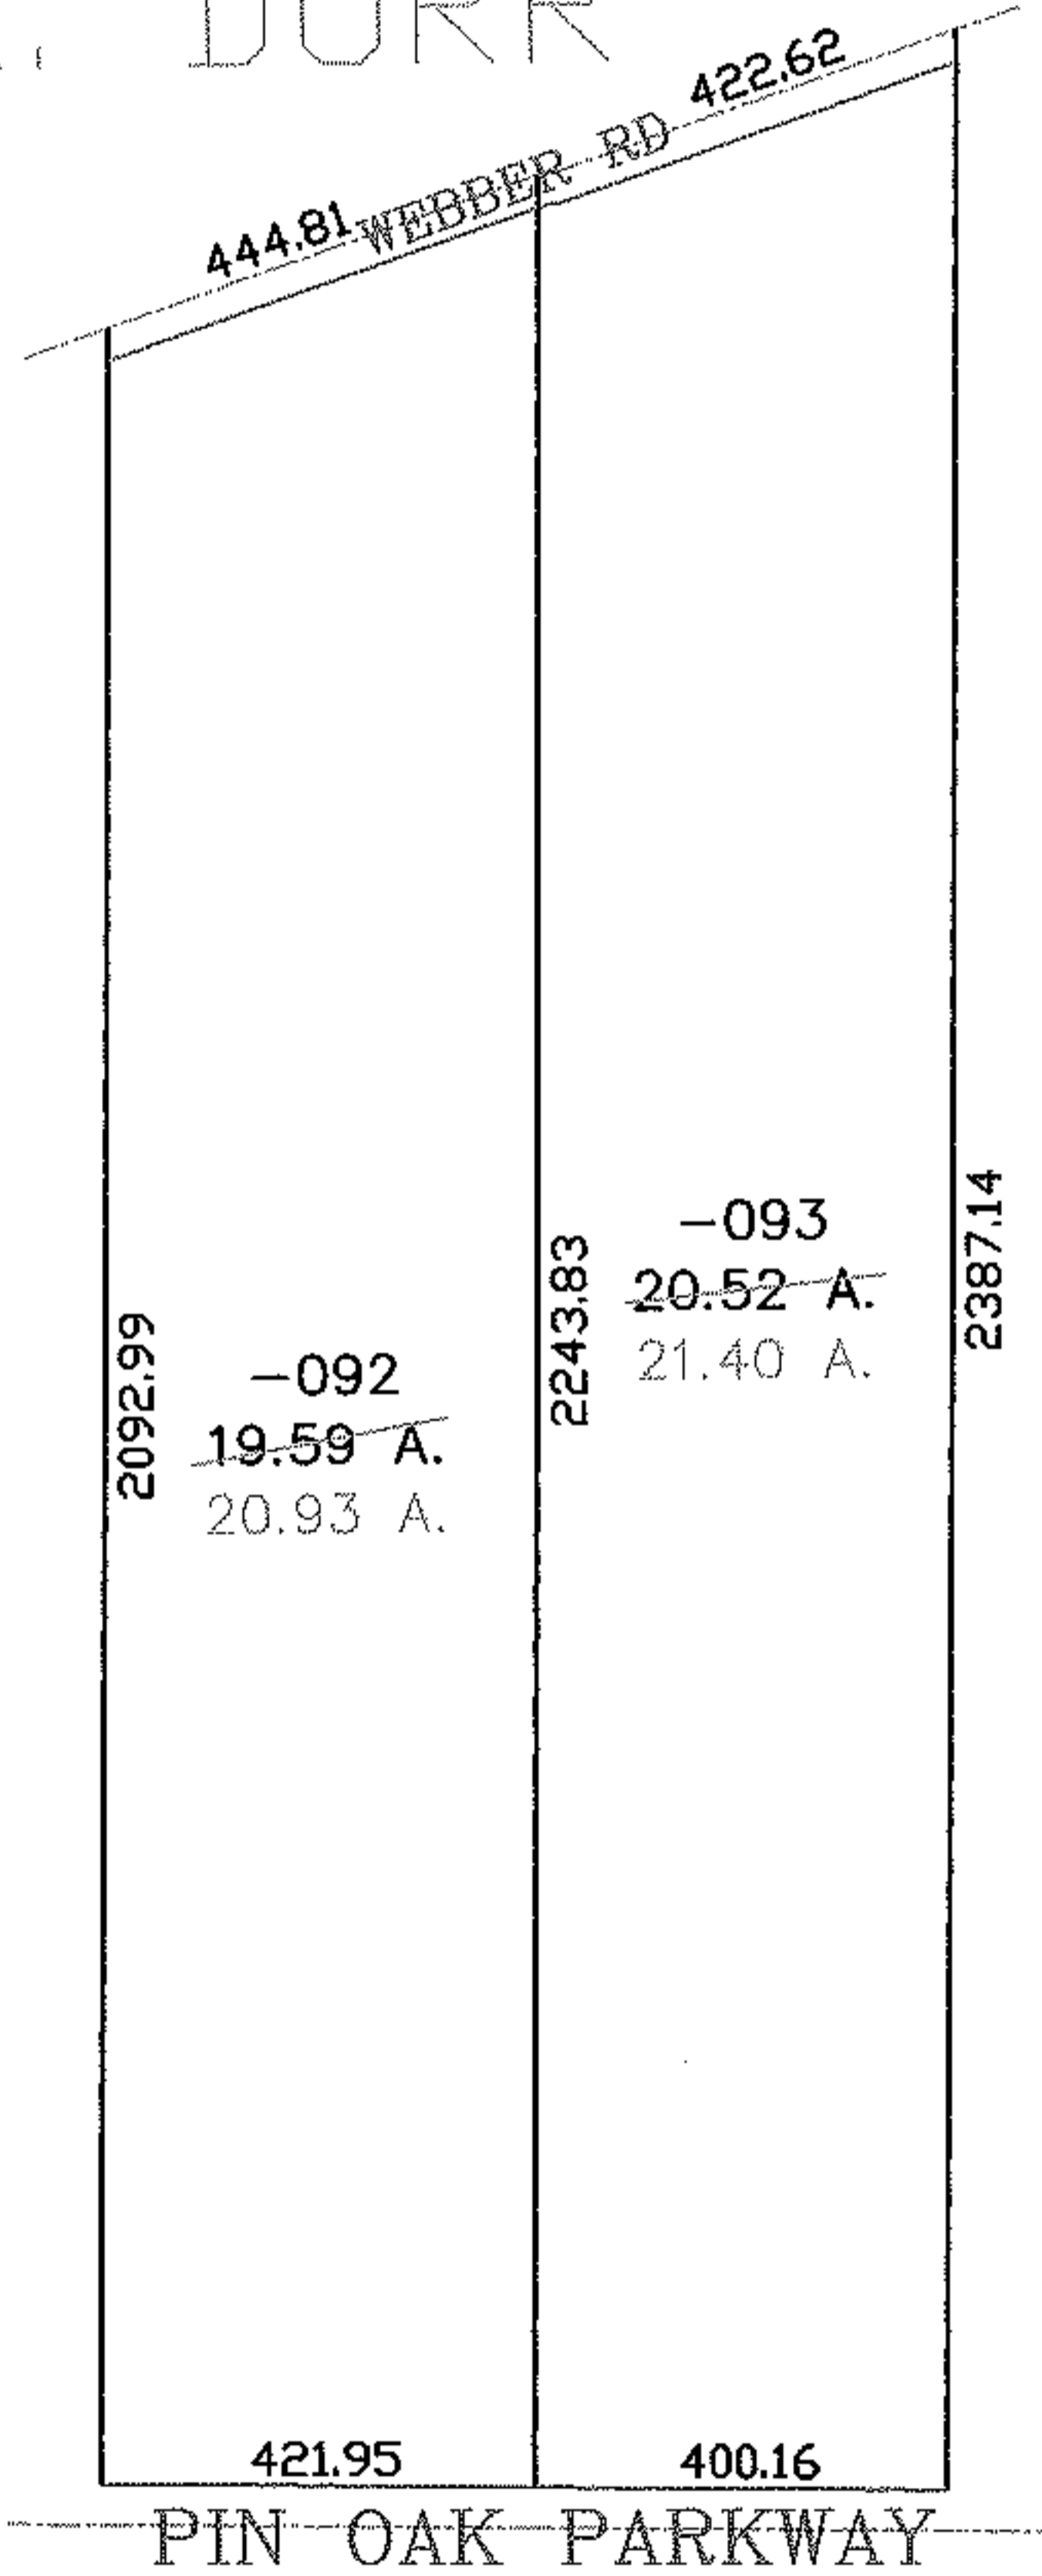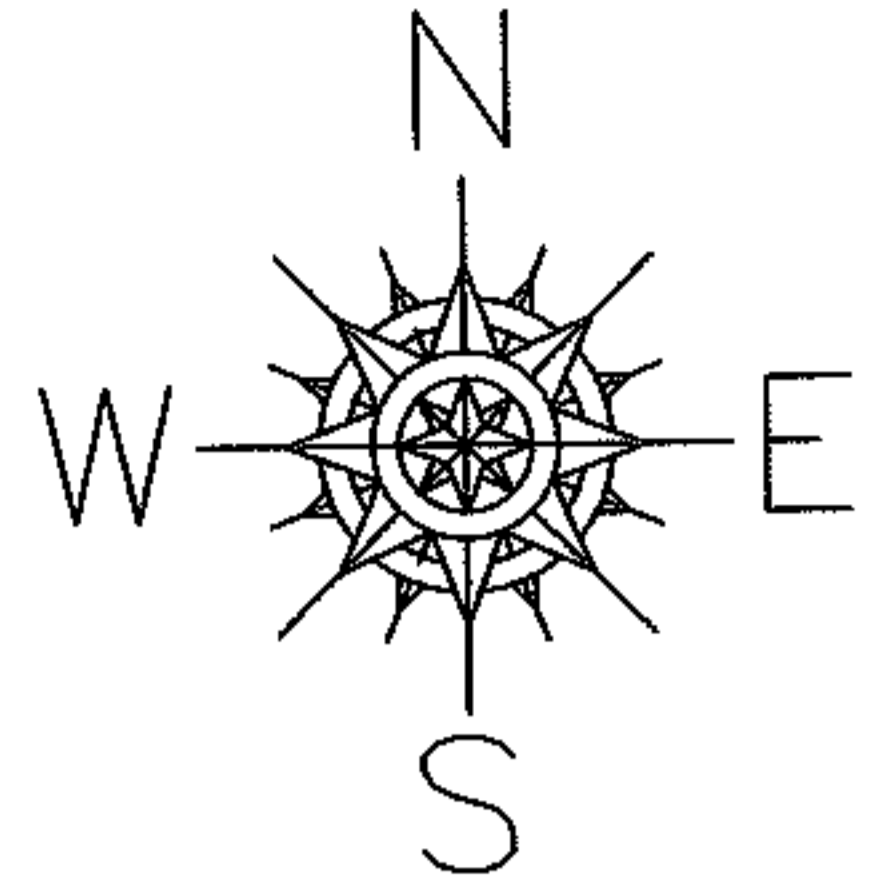


APPROVED
LORAIN CO.
MAP DEPT

DATE 1/20/2005

PAGE 4-00-008-C

BY D. Holland

#05-01099-D

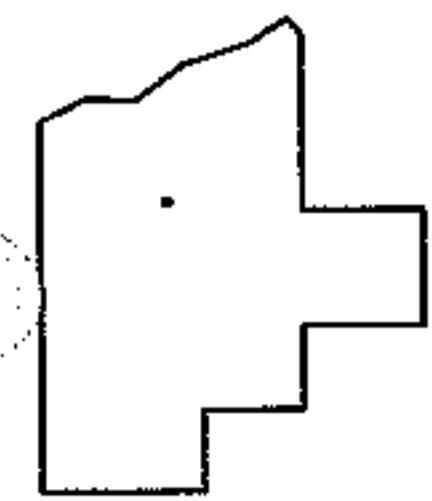

SPLITS/DEEDS PROCESSED
LORAIN COUNTY TAX MAP DEPARTMENT
226 MIDDLE AVE. ELYRIA, OHIO

SURVEYED BY: TIMOTHY R. DURR
CLOSURE: 1:10,000
MAP PAGE(S): 04-00-008-C
APPROVED BY: DRH DATE: 1/20/2005
SCALE: 1" = 400 PRIOR INSTRUMENT: 20010746147