
PARENT PARCEL: 05-00-023-111-018


CHILD PARCEL: 05-00-023-111-022, -023

STARTING POINT:_____

NO.01104-X

UNCIMBINATION DER DEED

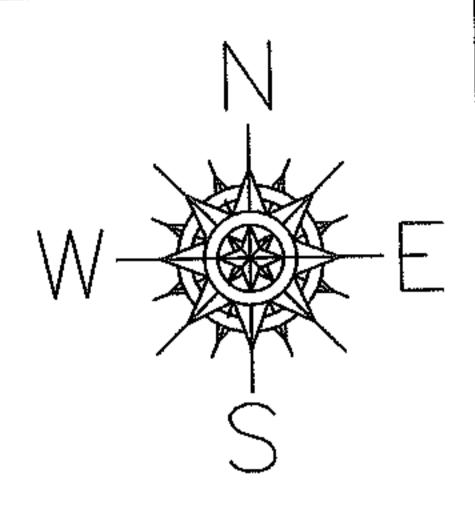

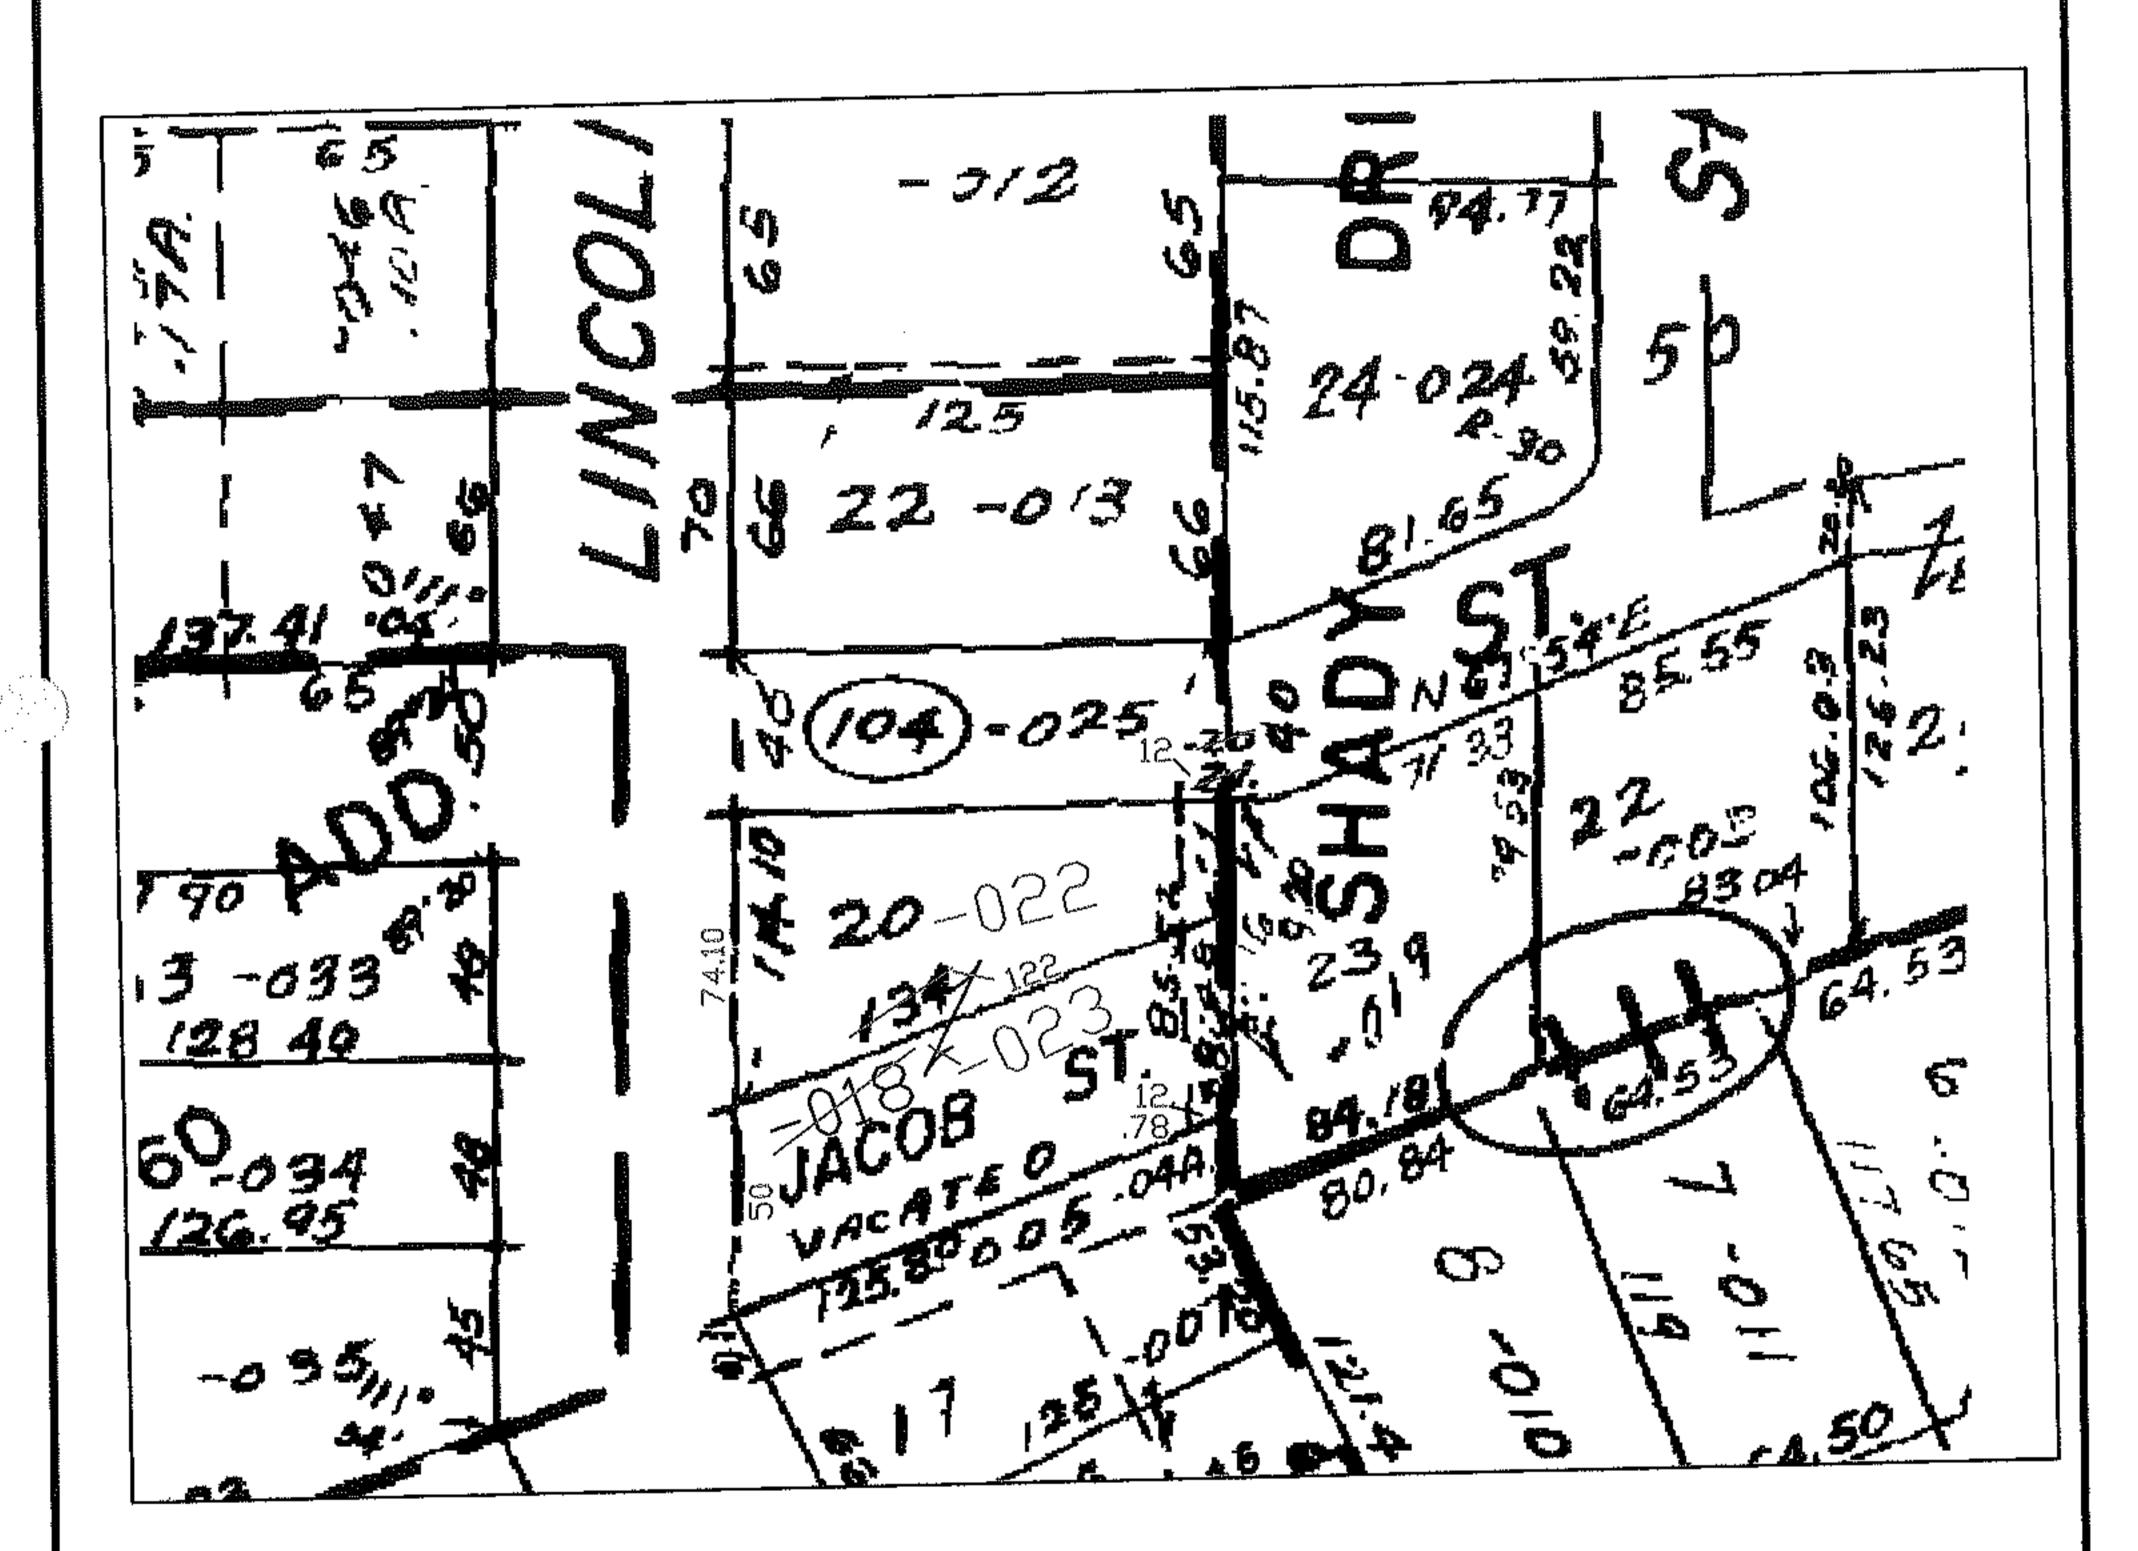

SPLITS/DEEDS PROCESSED

LORAIN COUNTY TAX MAP DEPARTMENT 226 MIDDLE AVE. ELYRIA, OHIO