



PASTER

PARENT PARCEL: 14-00-010-000-003, 14-00-009-000-002, 14-00-009-000-001

CHILD PARCEL: 14-00-009-000-022, 14-00-010-000-003

STARTING POINT: INT CL QUARRY RD AND N LINE OF O.L. 10

NO. 01114-A

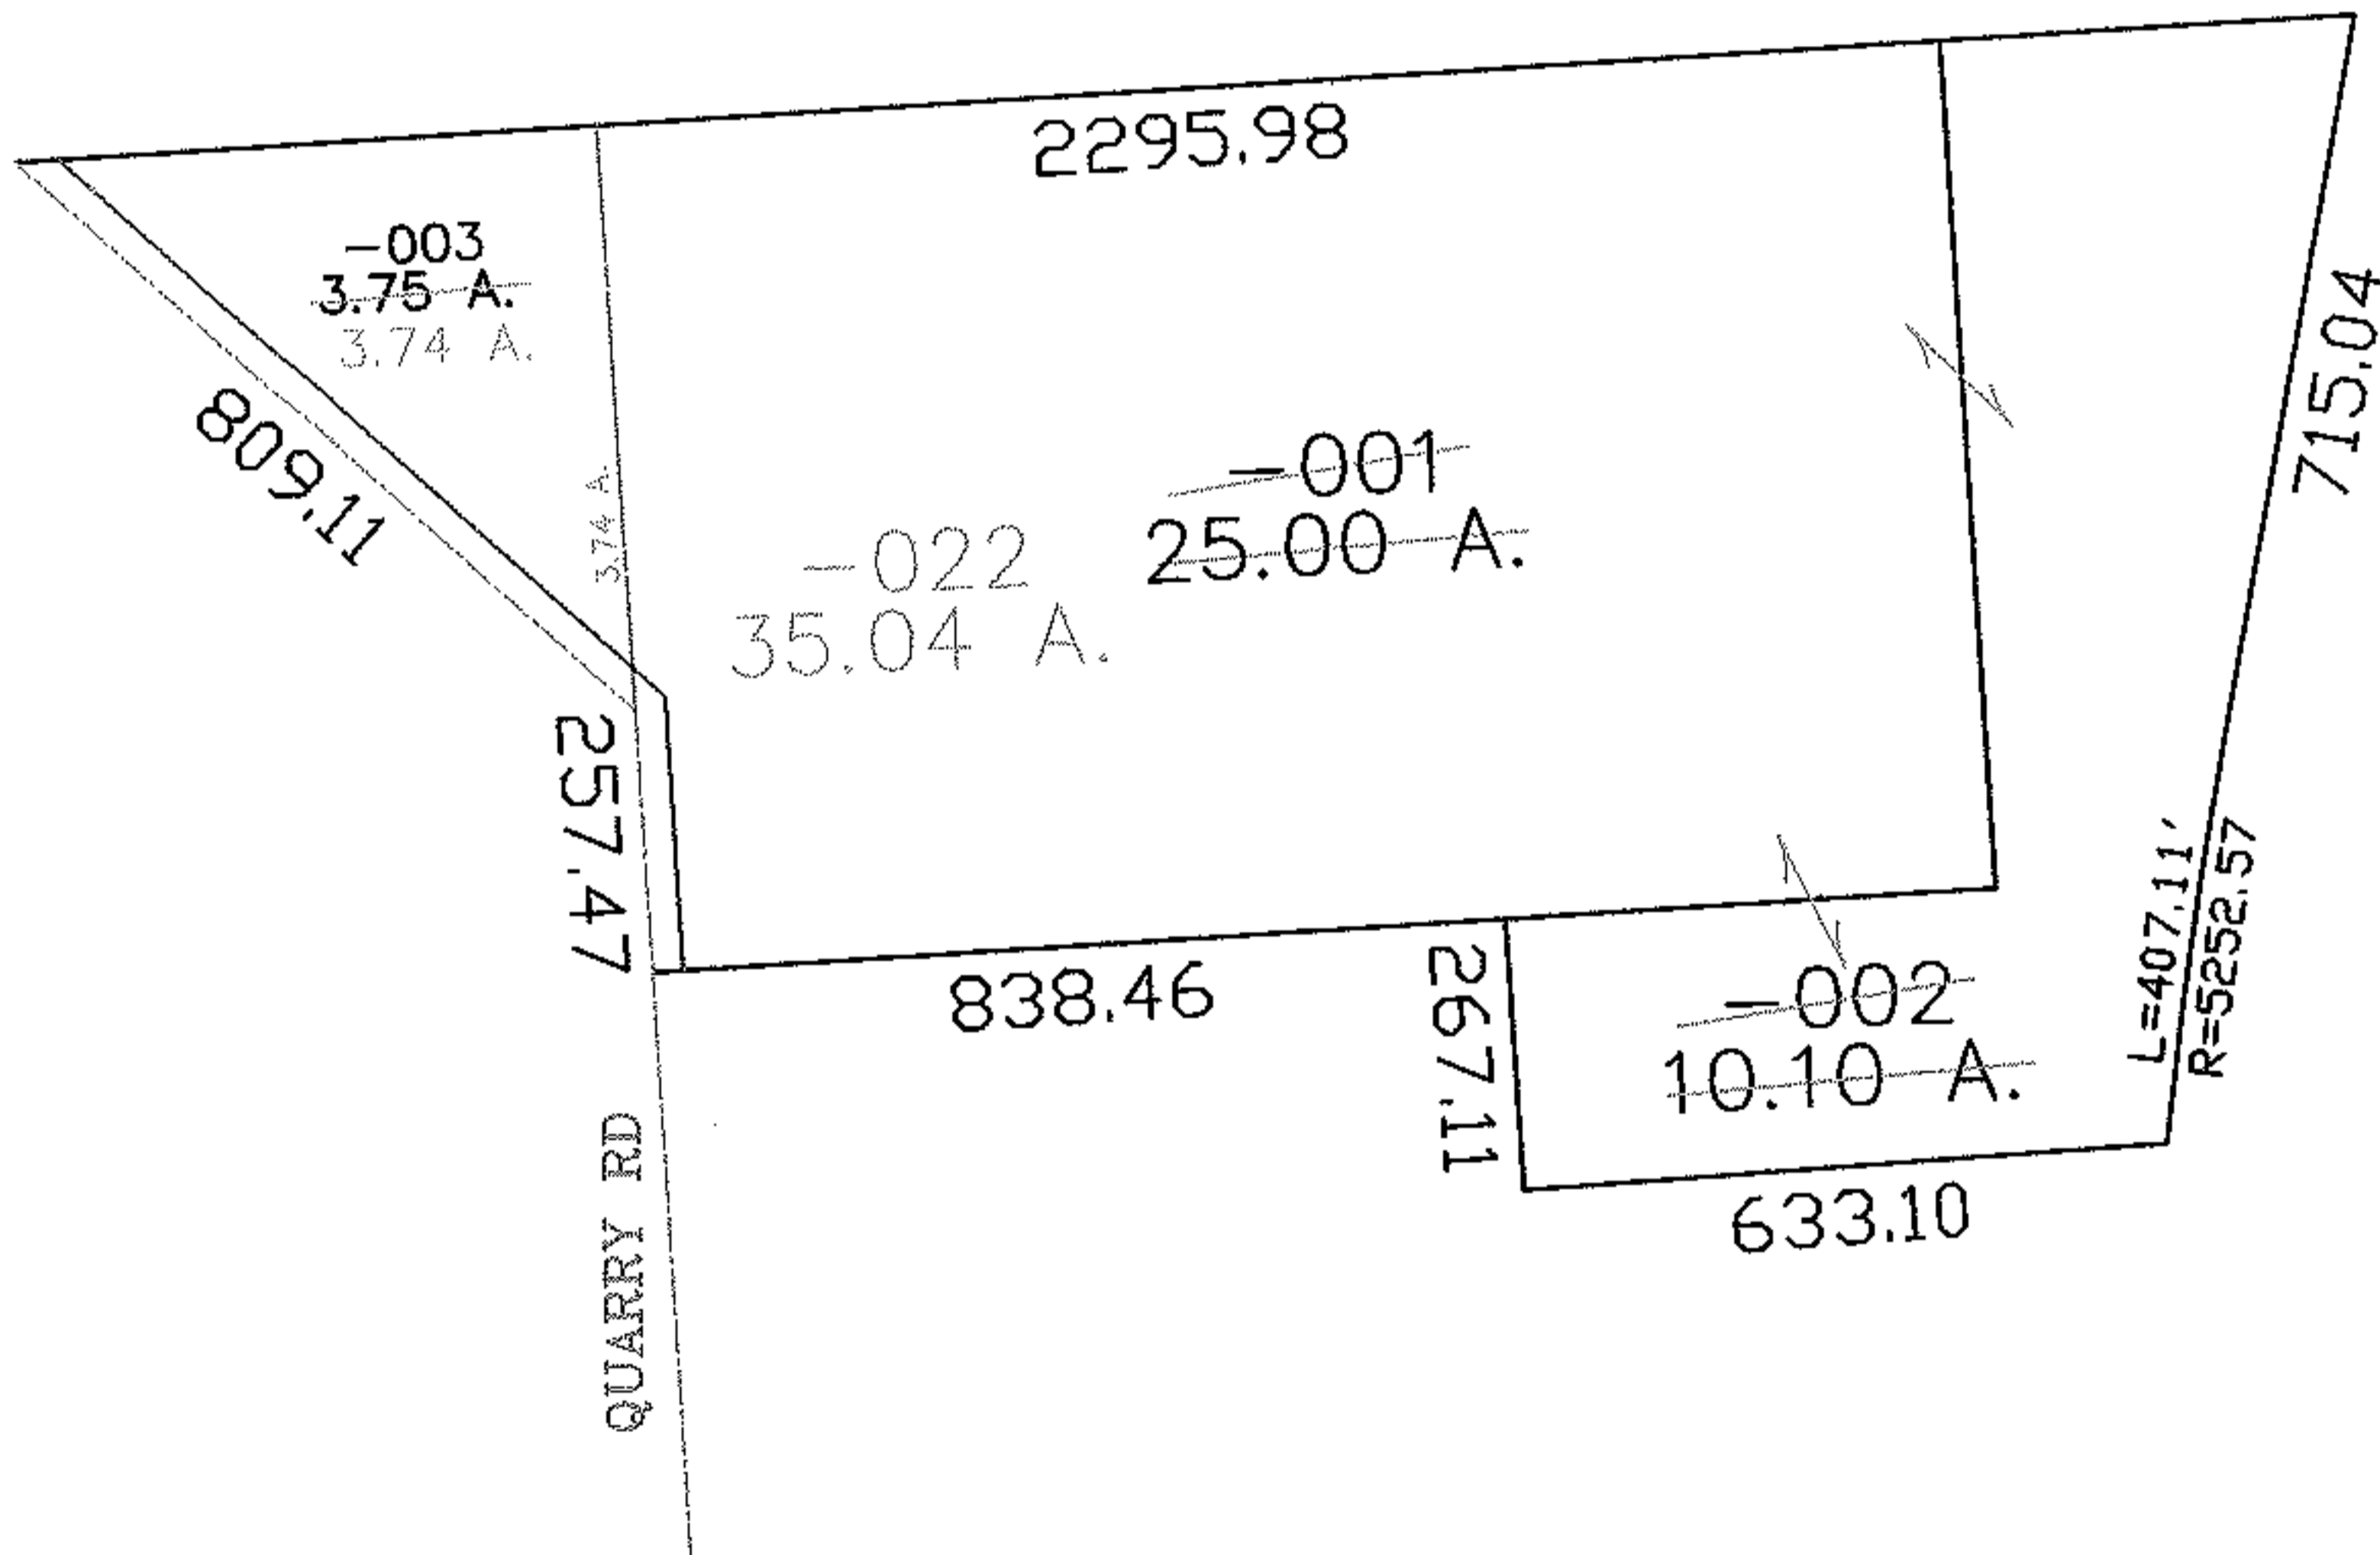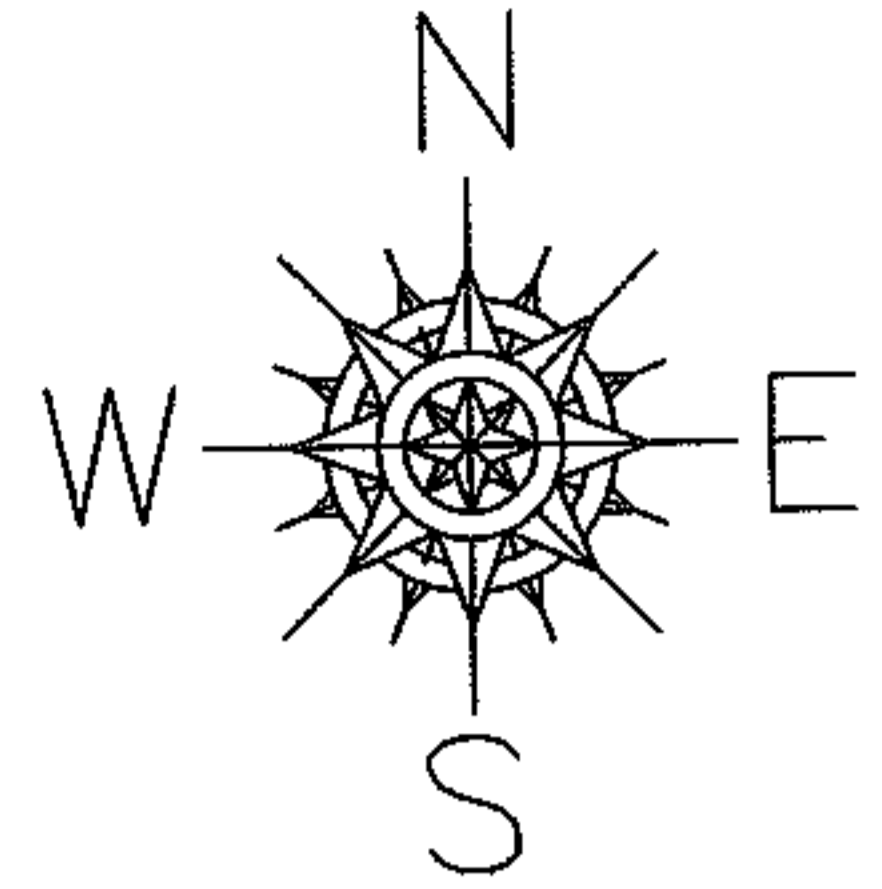

SURVEYED BY: DOUGLAS H. MOSLEY

CLOSURE: 1:10,000

MAP PAGE(S): 14-00-009-A

APPROVED BY: DRH DATE: 3/8/2005

SCALE: 1" = 400 PRIOR INSTRUMENT: 20000690326

SPLITS/DEEDS PROCESSED

LORAIN COUNTY TAX MAP DEPARTMENT
226 MIDDLE AVE. ELYRIA, OHIO

