

PARENT PARCEL: 10-00-008-108-009


CHILD PARCEL: 10-00-008-108-011, -012, -013

STARTING POINT:



NO. 01121-D

UNCOMBINATION
10-00-008-108-009

ADD TO DUP
10-00-008-108-013

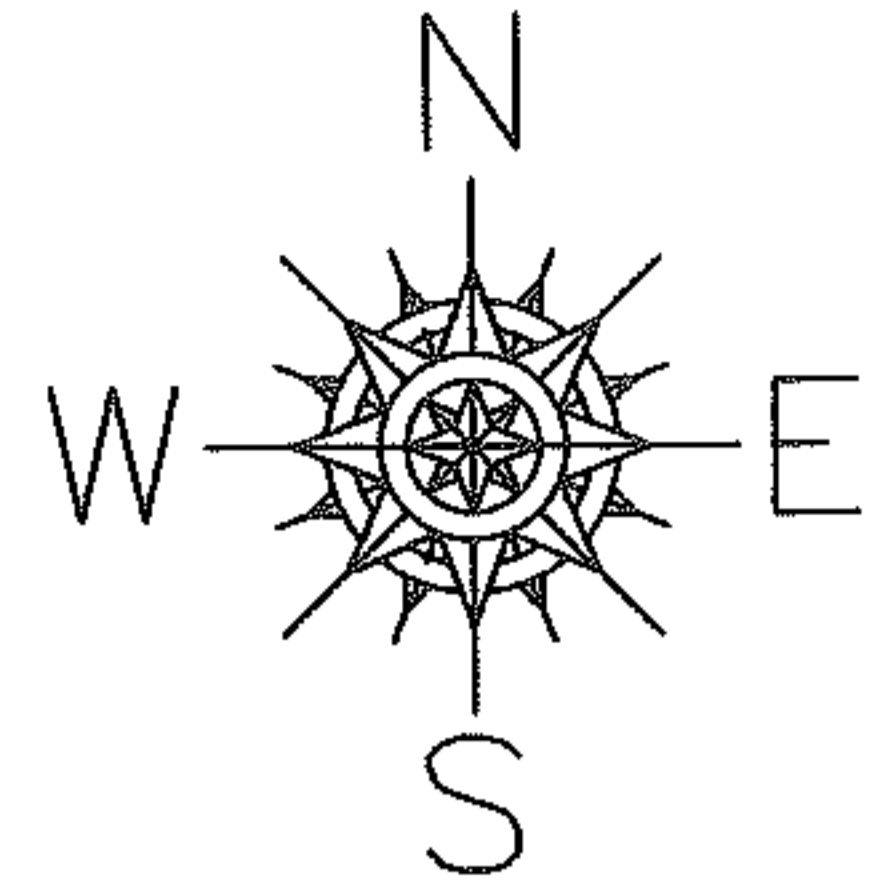

SURVEY BEFORE NEXT TRANSFER ON PARCEL -013

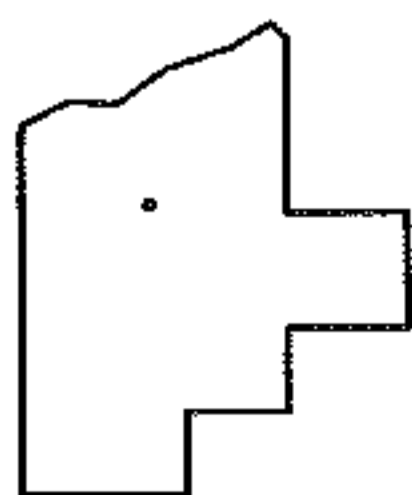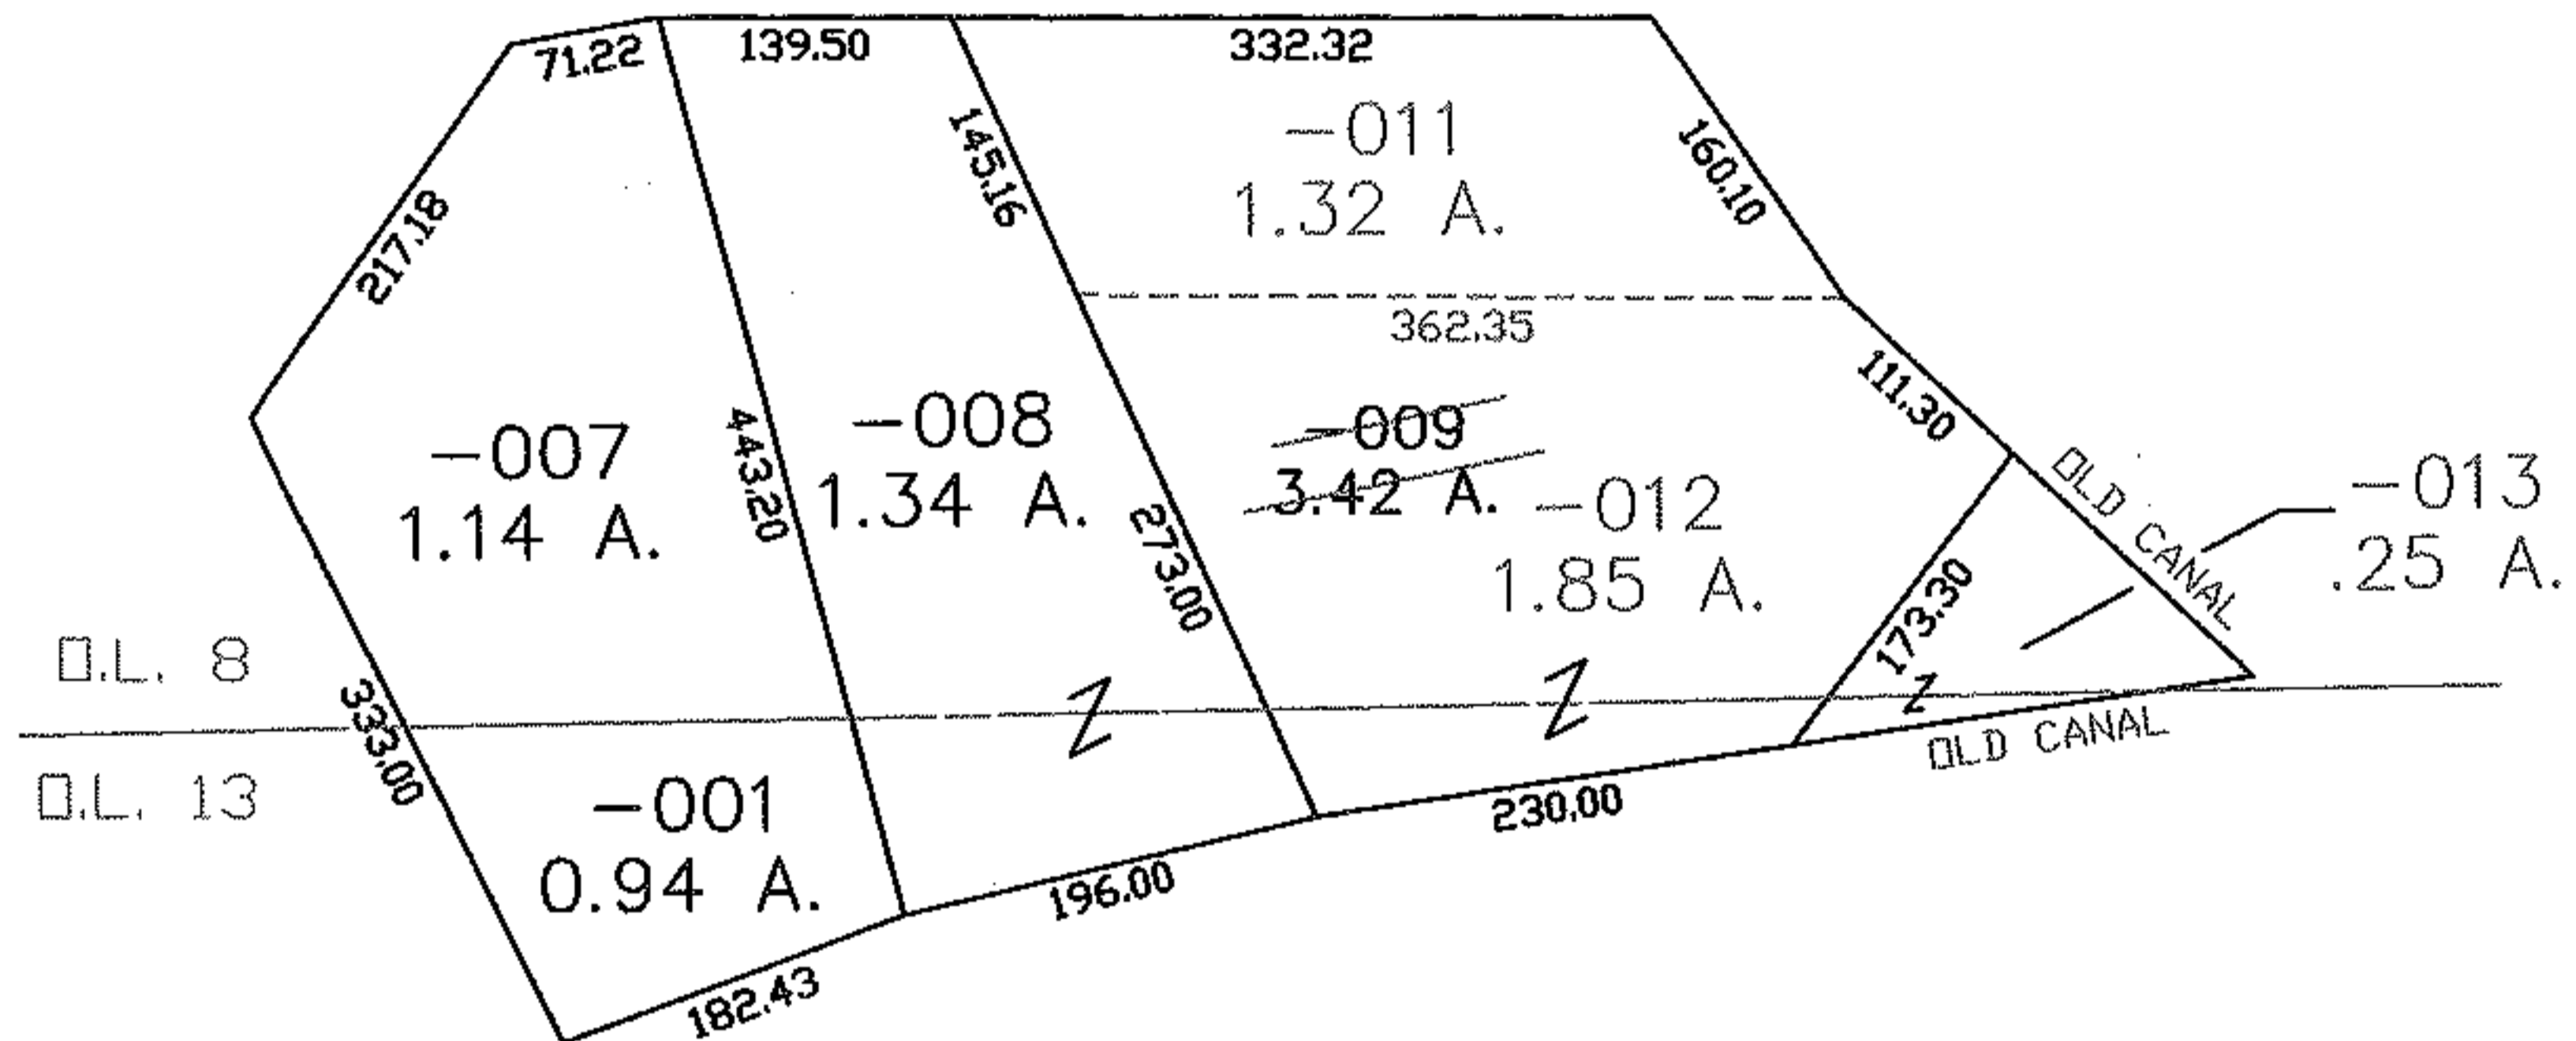

SPLITS/DEEDS PROCESSED
LORAIN COUNTY TAX MAP DEPARTMENT
226 MIDDLE AVE. ELYRIA, OHIO

SURVEYED BY: C.E. PENFOUND
CLOSURE: DOESN'T CLOSE
MAP PAGE(S): 10-00-008-E
APPROVED BY: DRH DATE: 3/23/2005
SCALE: 1" = 200' PRIOR INSTRUMENT: DV 646/375