



ENT PARCEL: 05-00-004-102-063
CHILD PARCEL: 05-00-004-102-065, -066
STARTING POINT: N/A


NO. 01122-X

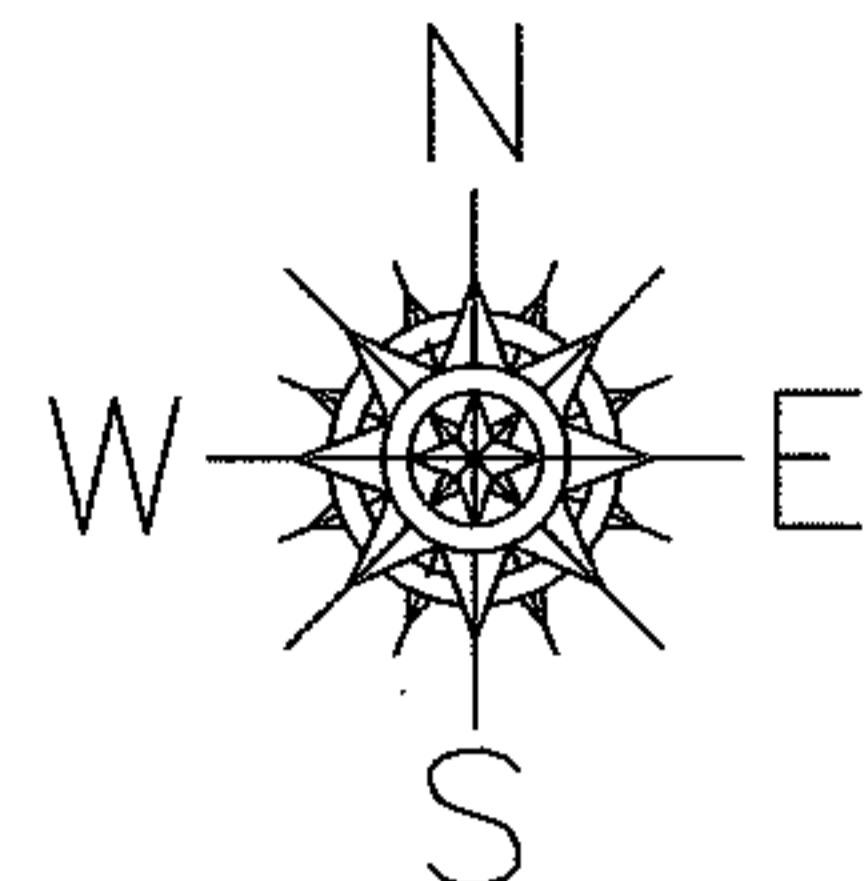

UNCOMBINATION
PER ERROR IN
TAX MAP DEPT
AND TRANSFER DEPT

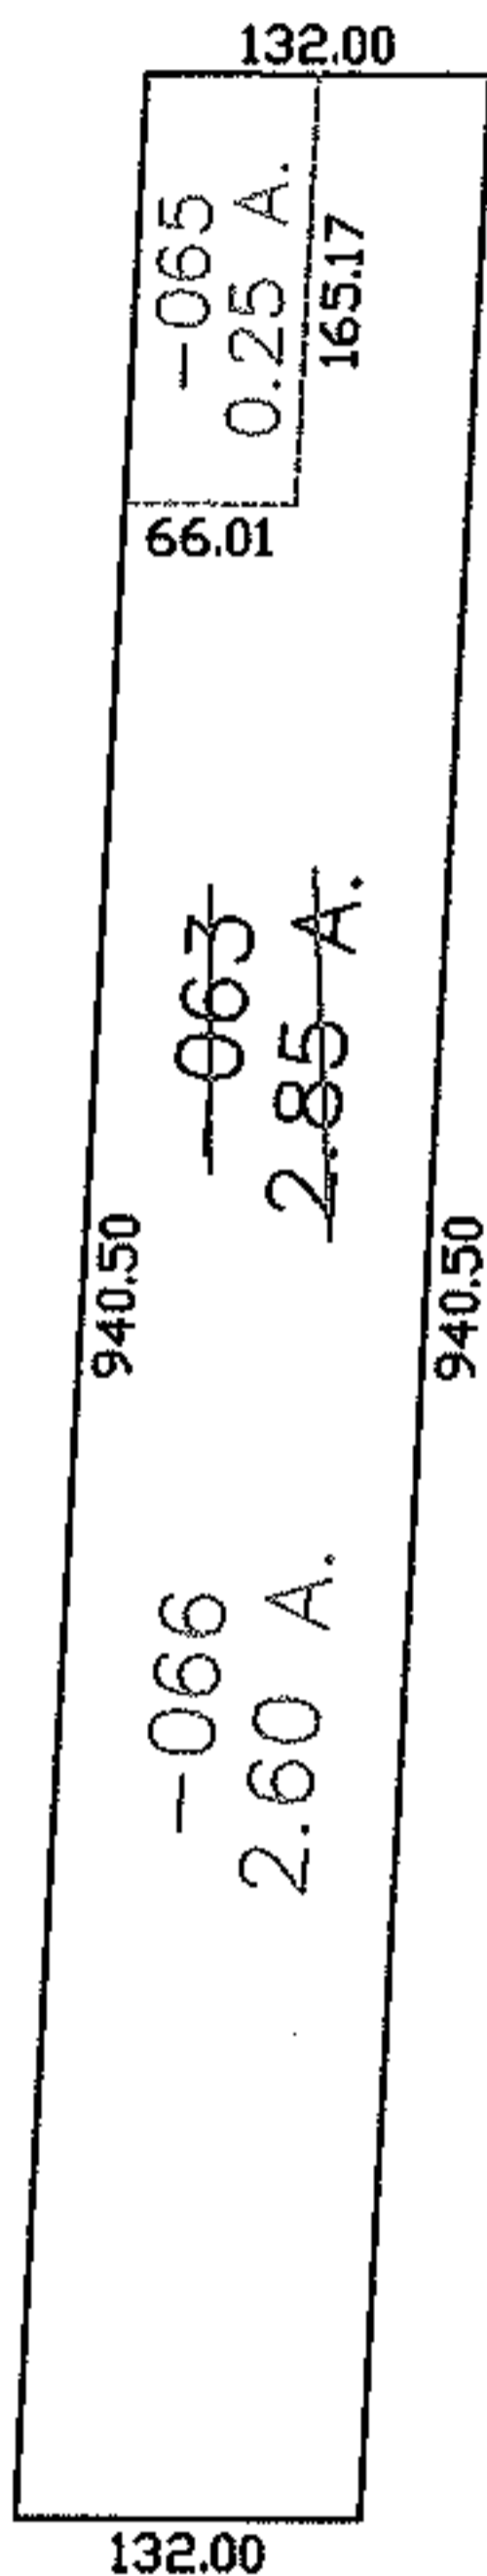

Drop from Dup:
05-00-004-102-064

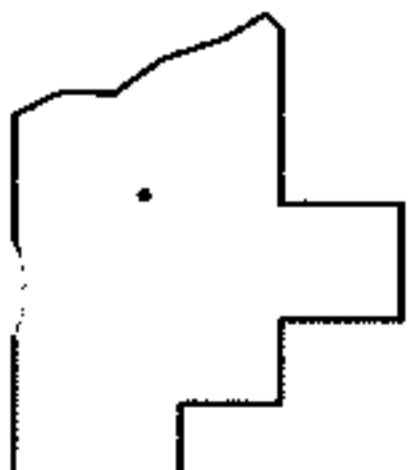

SPLITS/DEEDS PROCESSED
LORAIN COUNTY TAX MAP DEPARTMENT
226 MIDDLE AVE. ELYRIA, OHIO

SURVEYED BY: N/A
CLOSURE: N/A
MAP PAGE(S): 05-00-003-A
APPROVED BY: DRH DATE: 3/23/2005
SCALE: 1" = 200 PRIOR INSTRUMENT: DV XXXX/XXX