
PARENT PARCEL: 06-24-035-101-010


CHILD PARCEL: --SAME--

NO.01139-C

STARTING POINT: N/A

DEPTH CORR PER DEED AND MAP

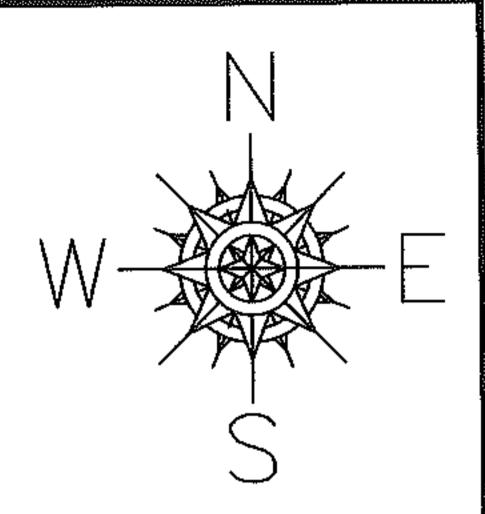

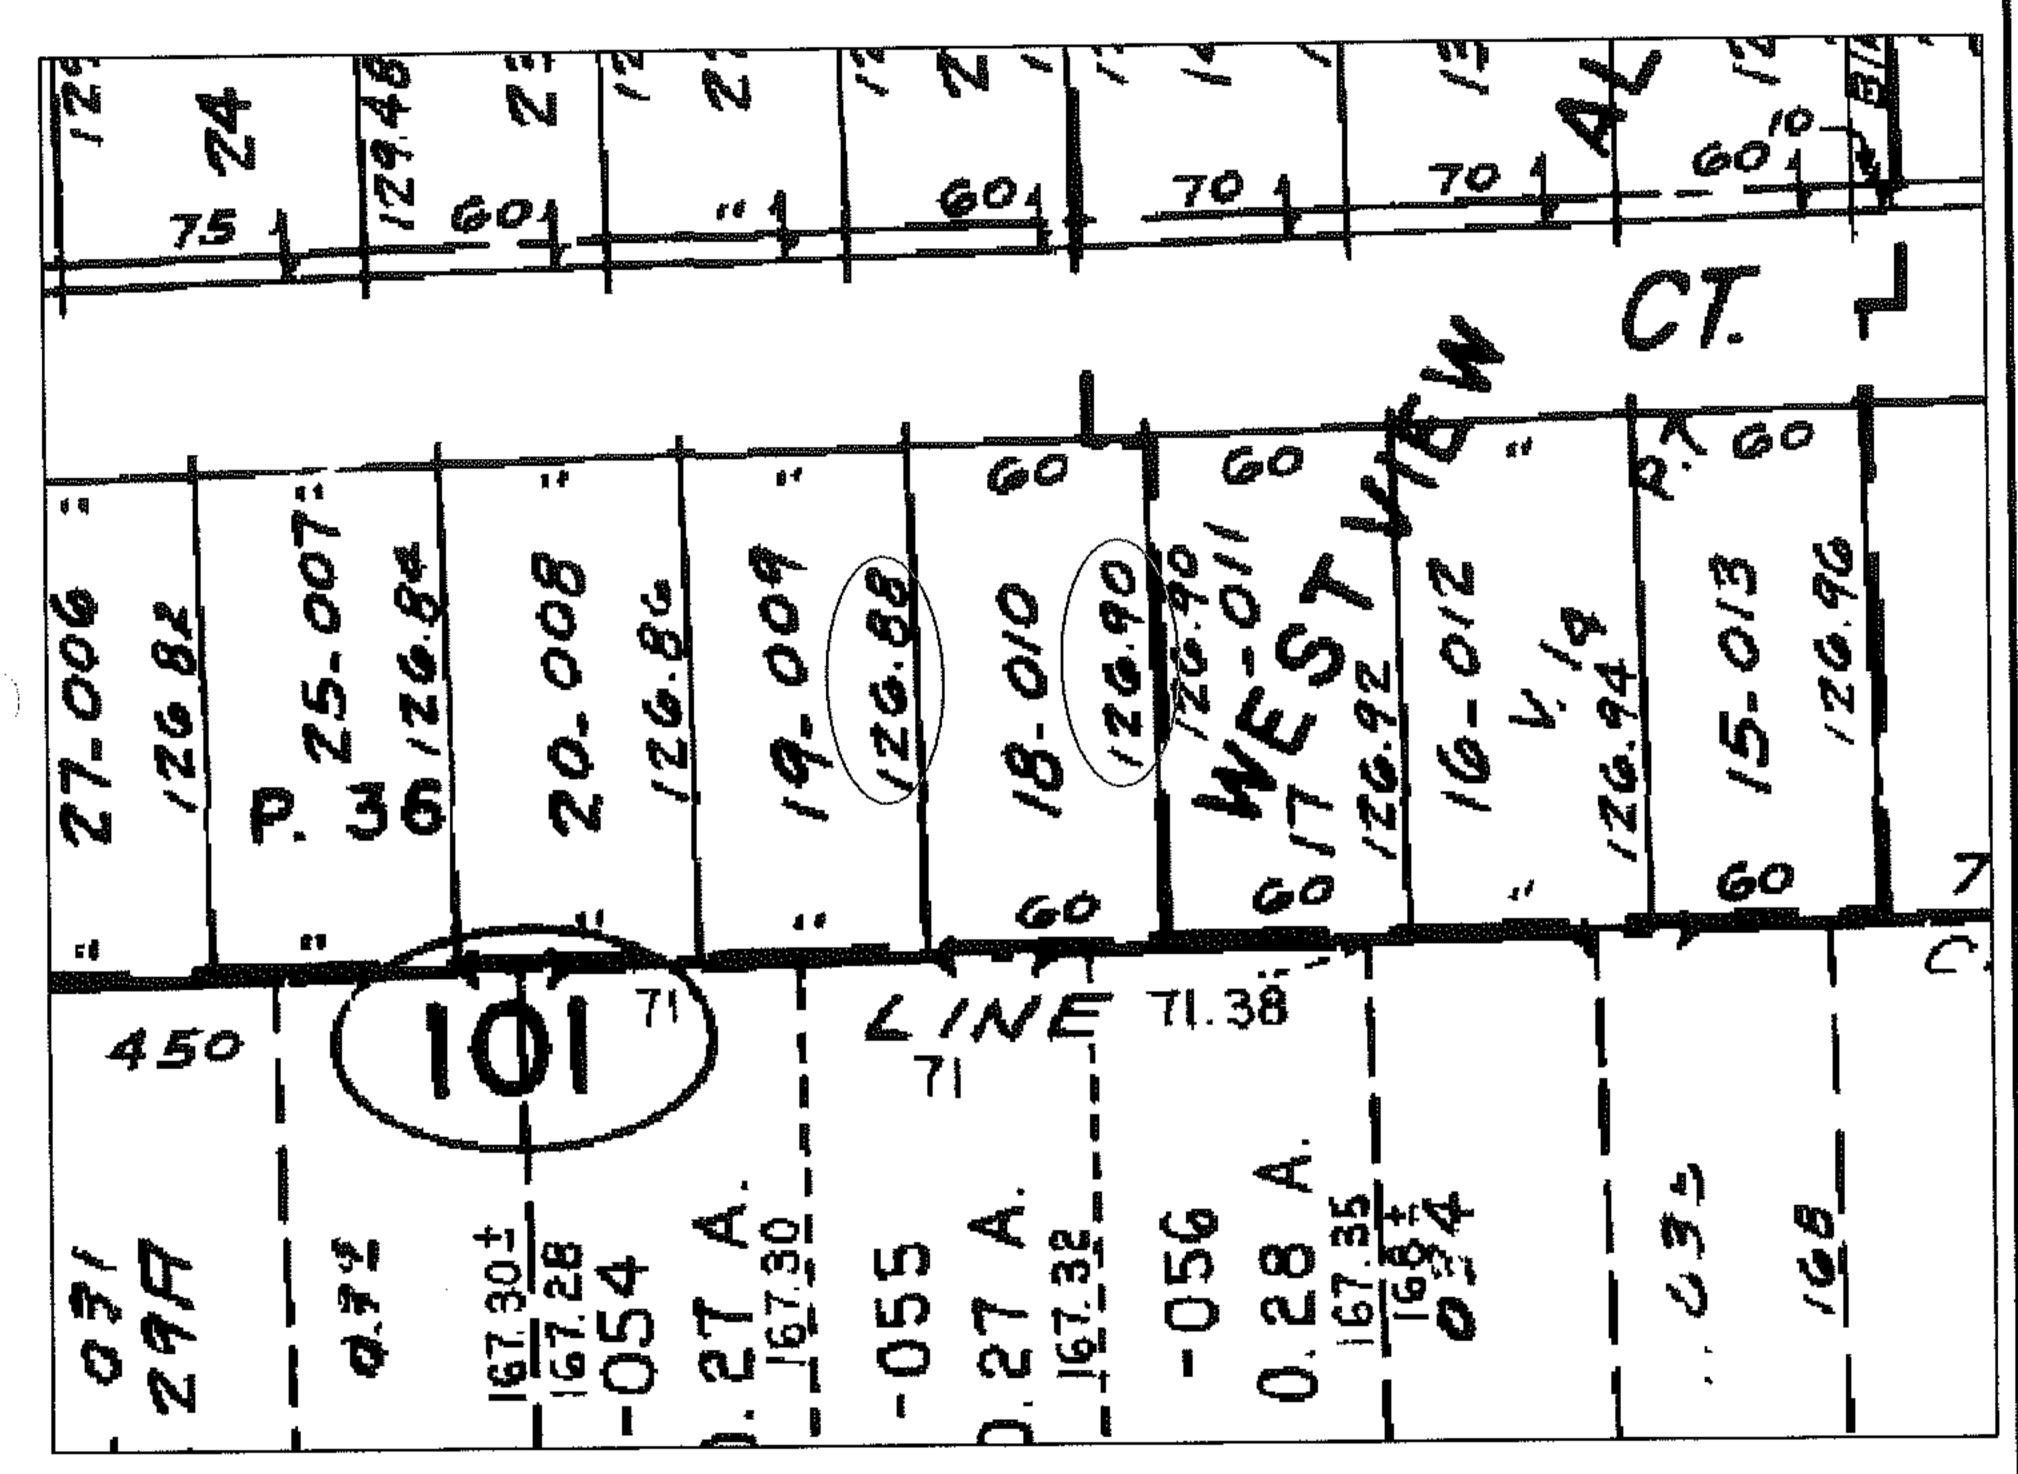

SPLITS/DEEDS PROCESSED

LORAIN COUNTY TAX MAP DEPARTMENT 226 MIDDLE AVE. ELYRIA, OHIO

SURVEYED BY: N/A

CLOSURE: N/A

MAP PAGE(S): 06-60

APPROVED BY: <u>DRH</u> DATE: <u>4/21/2005</u> SCALE: 1"= 100 PRIOR INSTRUMENT: 200108394