

MASTER



PARENT PARCEL: 07-00-011-101-003

CHILD PARCEL: --SAME--

STARTING POINT: INT ROW S.R. 10 AND N LINE OF O.L. 11

NO. 01145-A

AC. CORR.  
PER SURVEY  
CHRISTOPHER M. HIRZEL

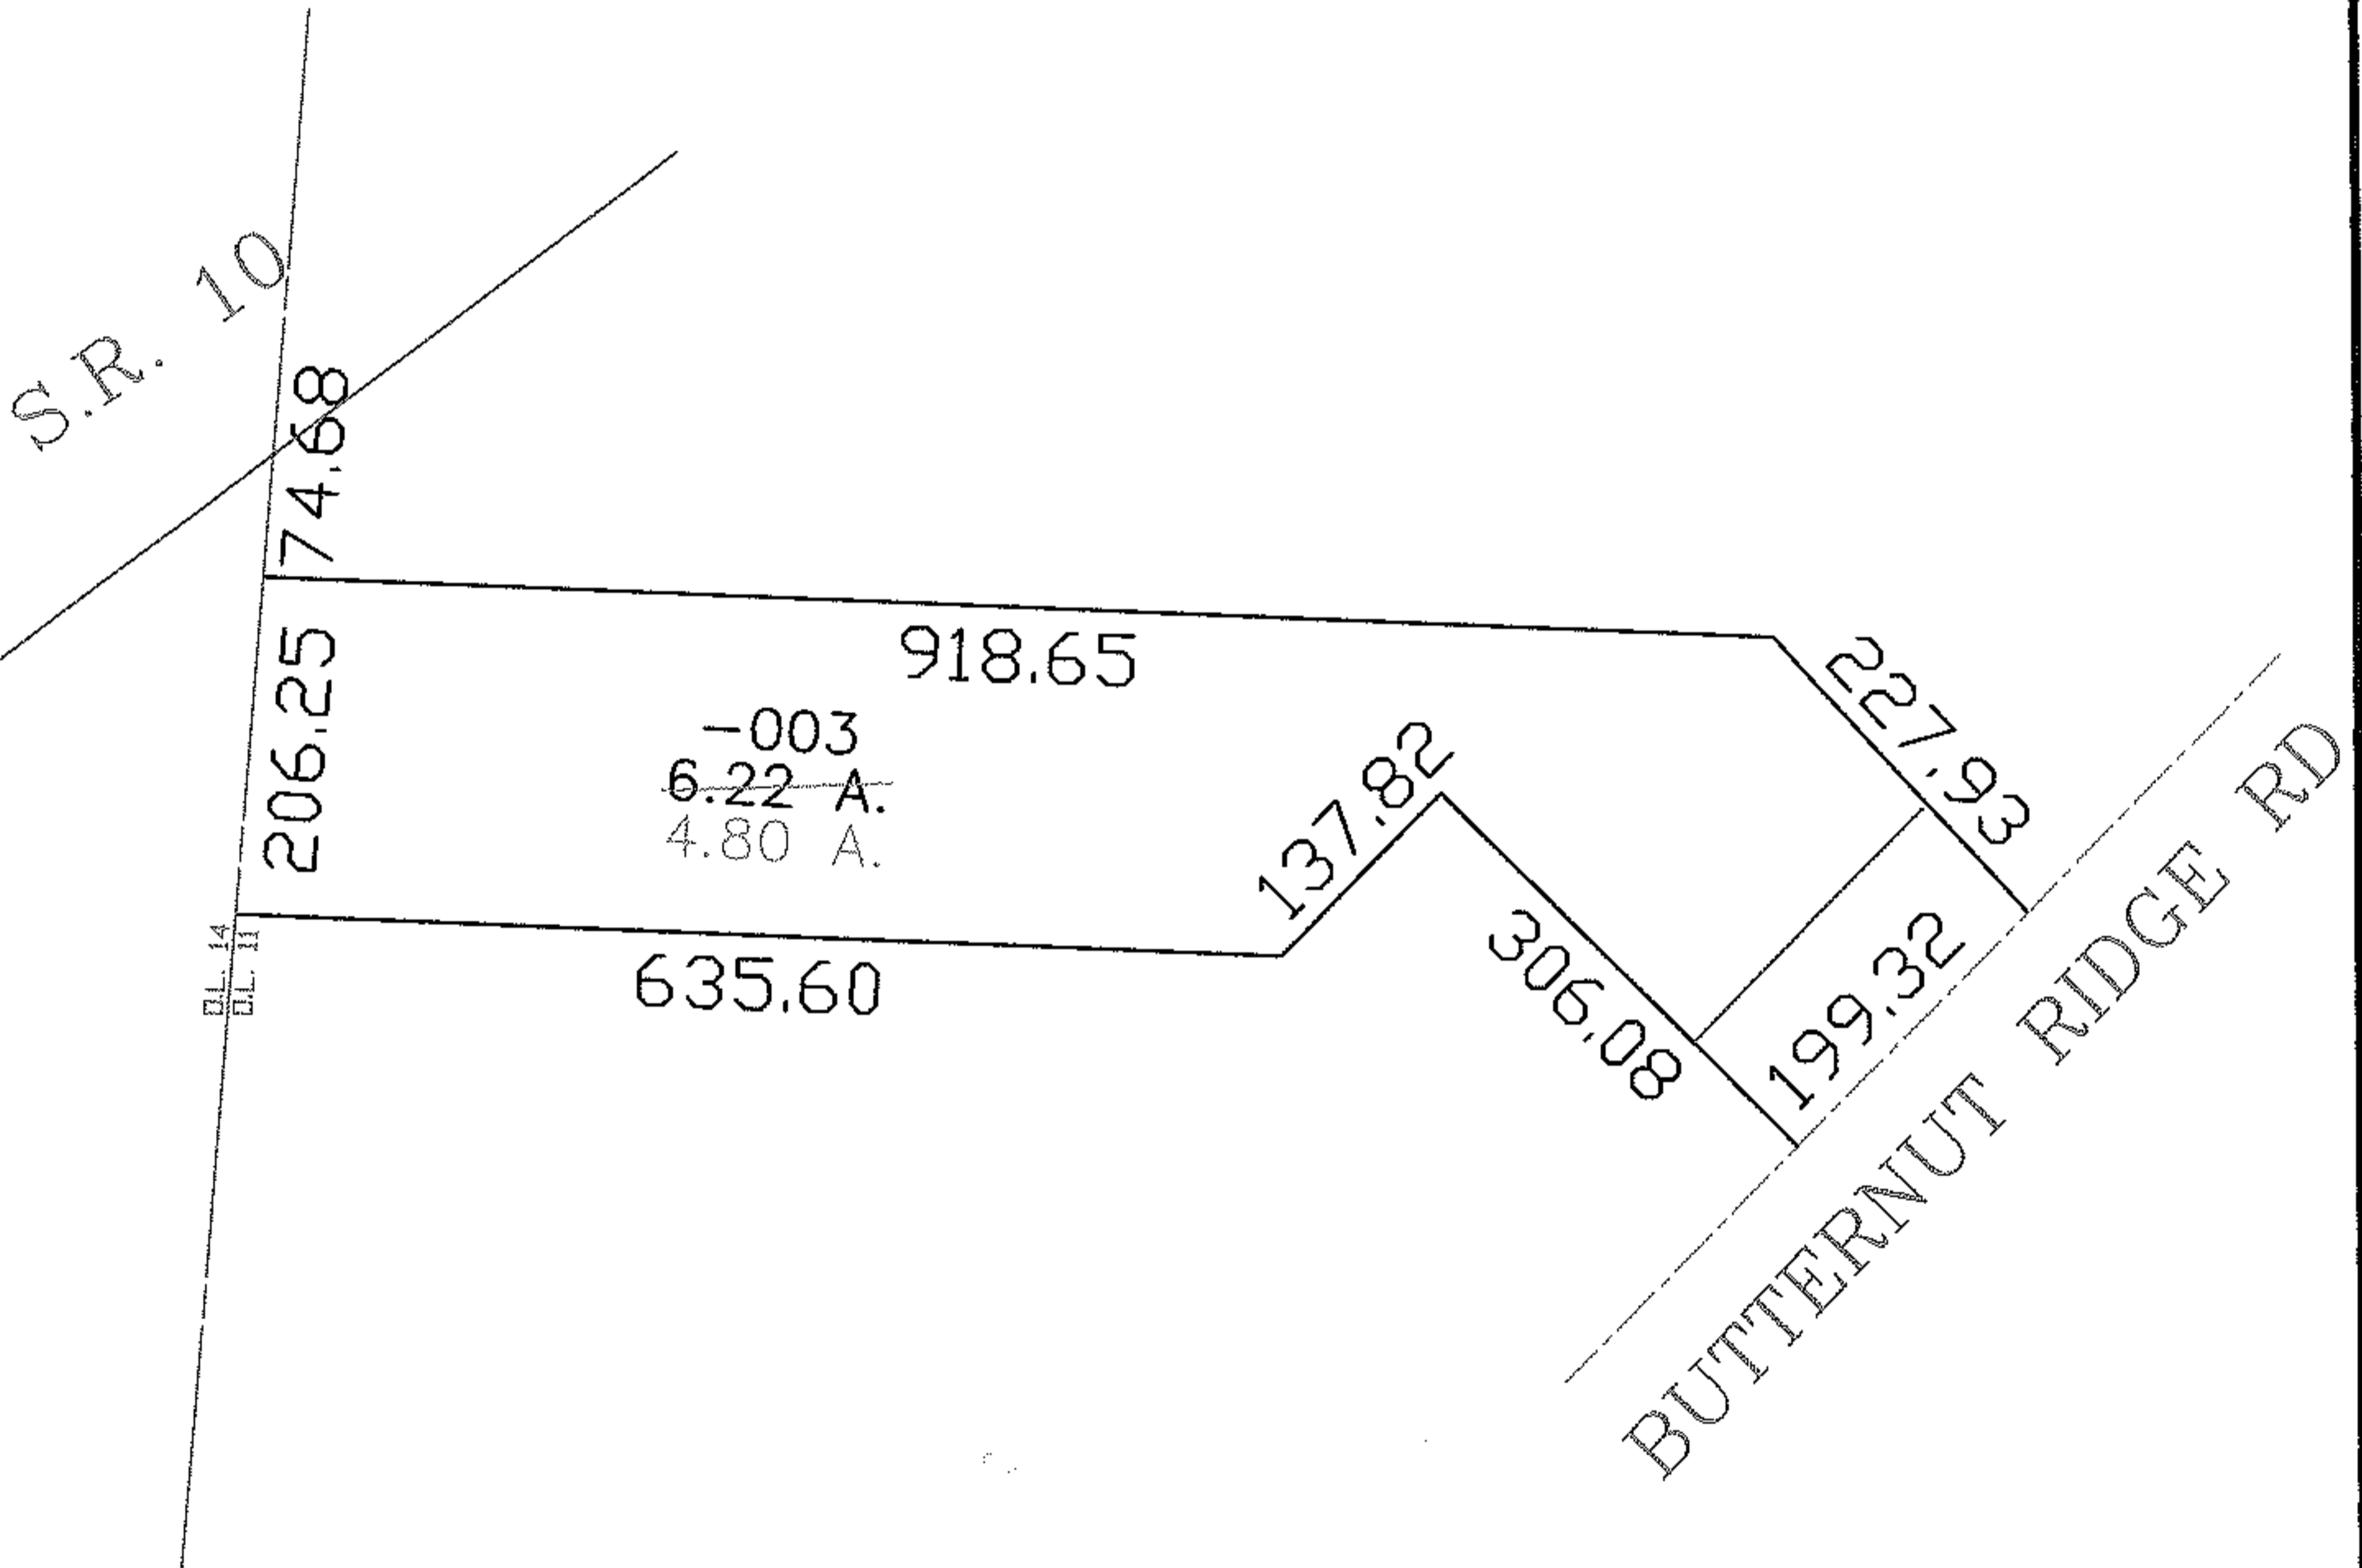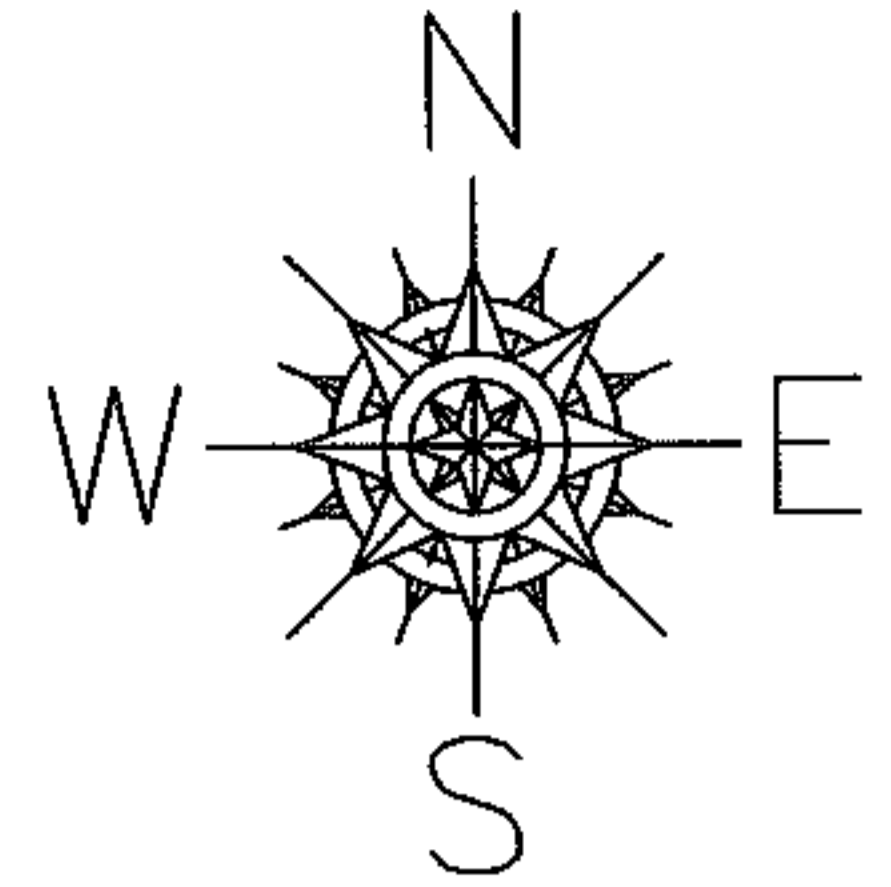

**SPLITS/DEEDS PROCESSED**  
LORAIN COUNTY TAX MAP DEPARTMENT  
226 MIDDLE AVE. ELYRIA, OHIO

SURVEYED BY: CHRISTOPHER M. HIRZEL  
 CLOSURE: 1:10,000  
 MAP PAGE(S): 07-00-011-A  
 APPROVED BY: DRH DATE: 5/6/2005  
 SCALE: 1" = 200 PRIOR INSTRUMENT: \_\_\_\_\_