



RASTER

PARENT PARCEL: 05-00-051-000-015, 05-00-070-000-001

CHILD PARCEL: --SAME--

STARTING POINT: INT N LINE O.L. 51 AND CL OF OBERLIN RD

NO. 01146-C

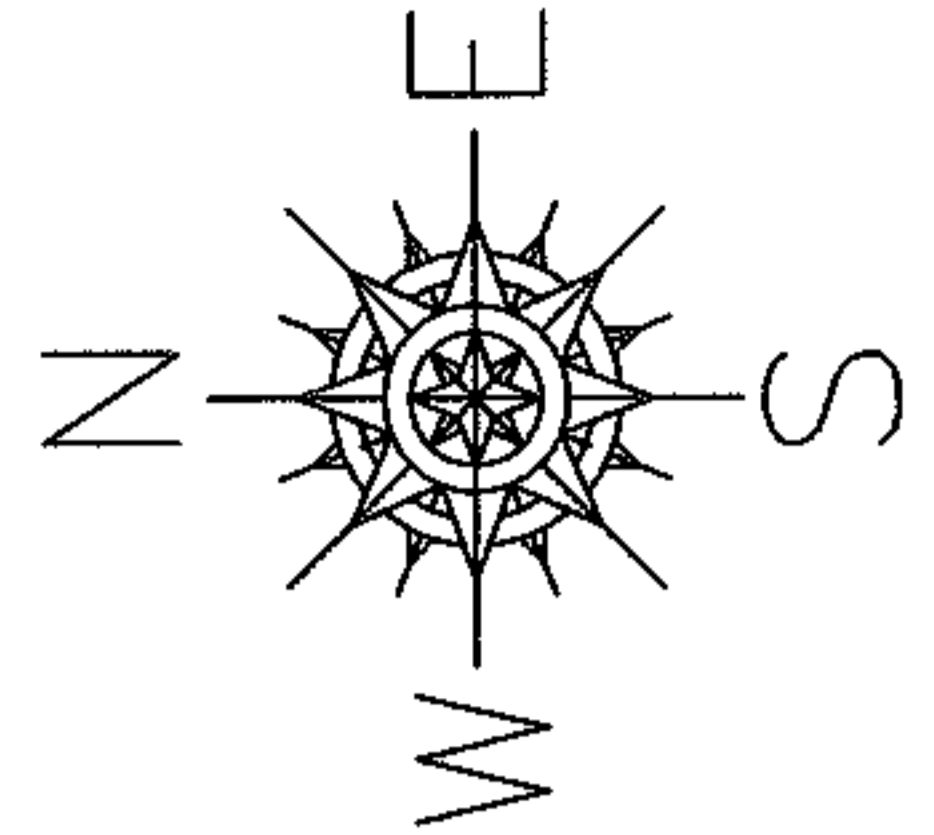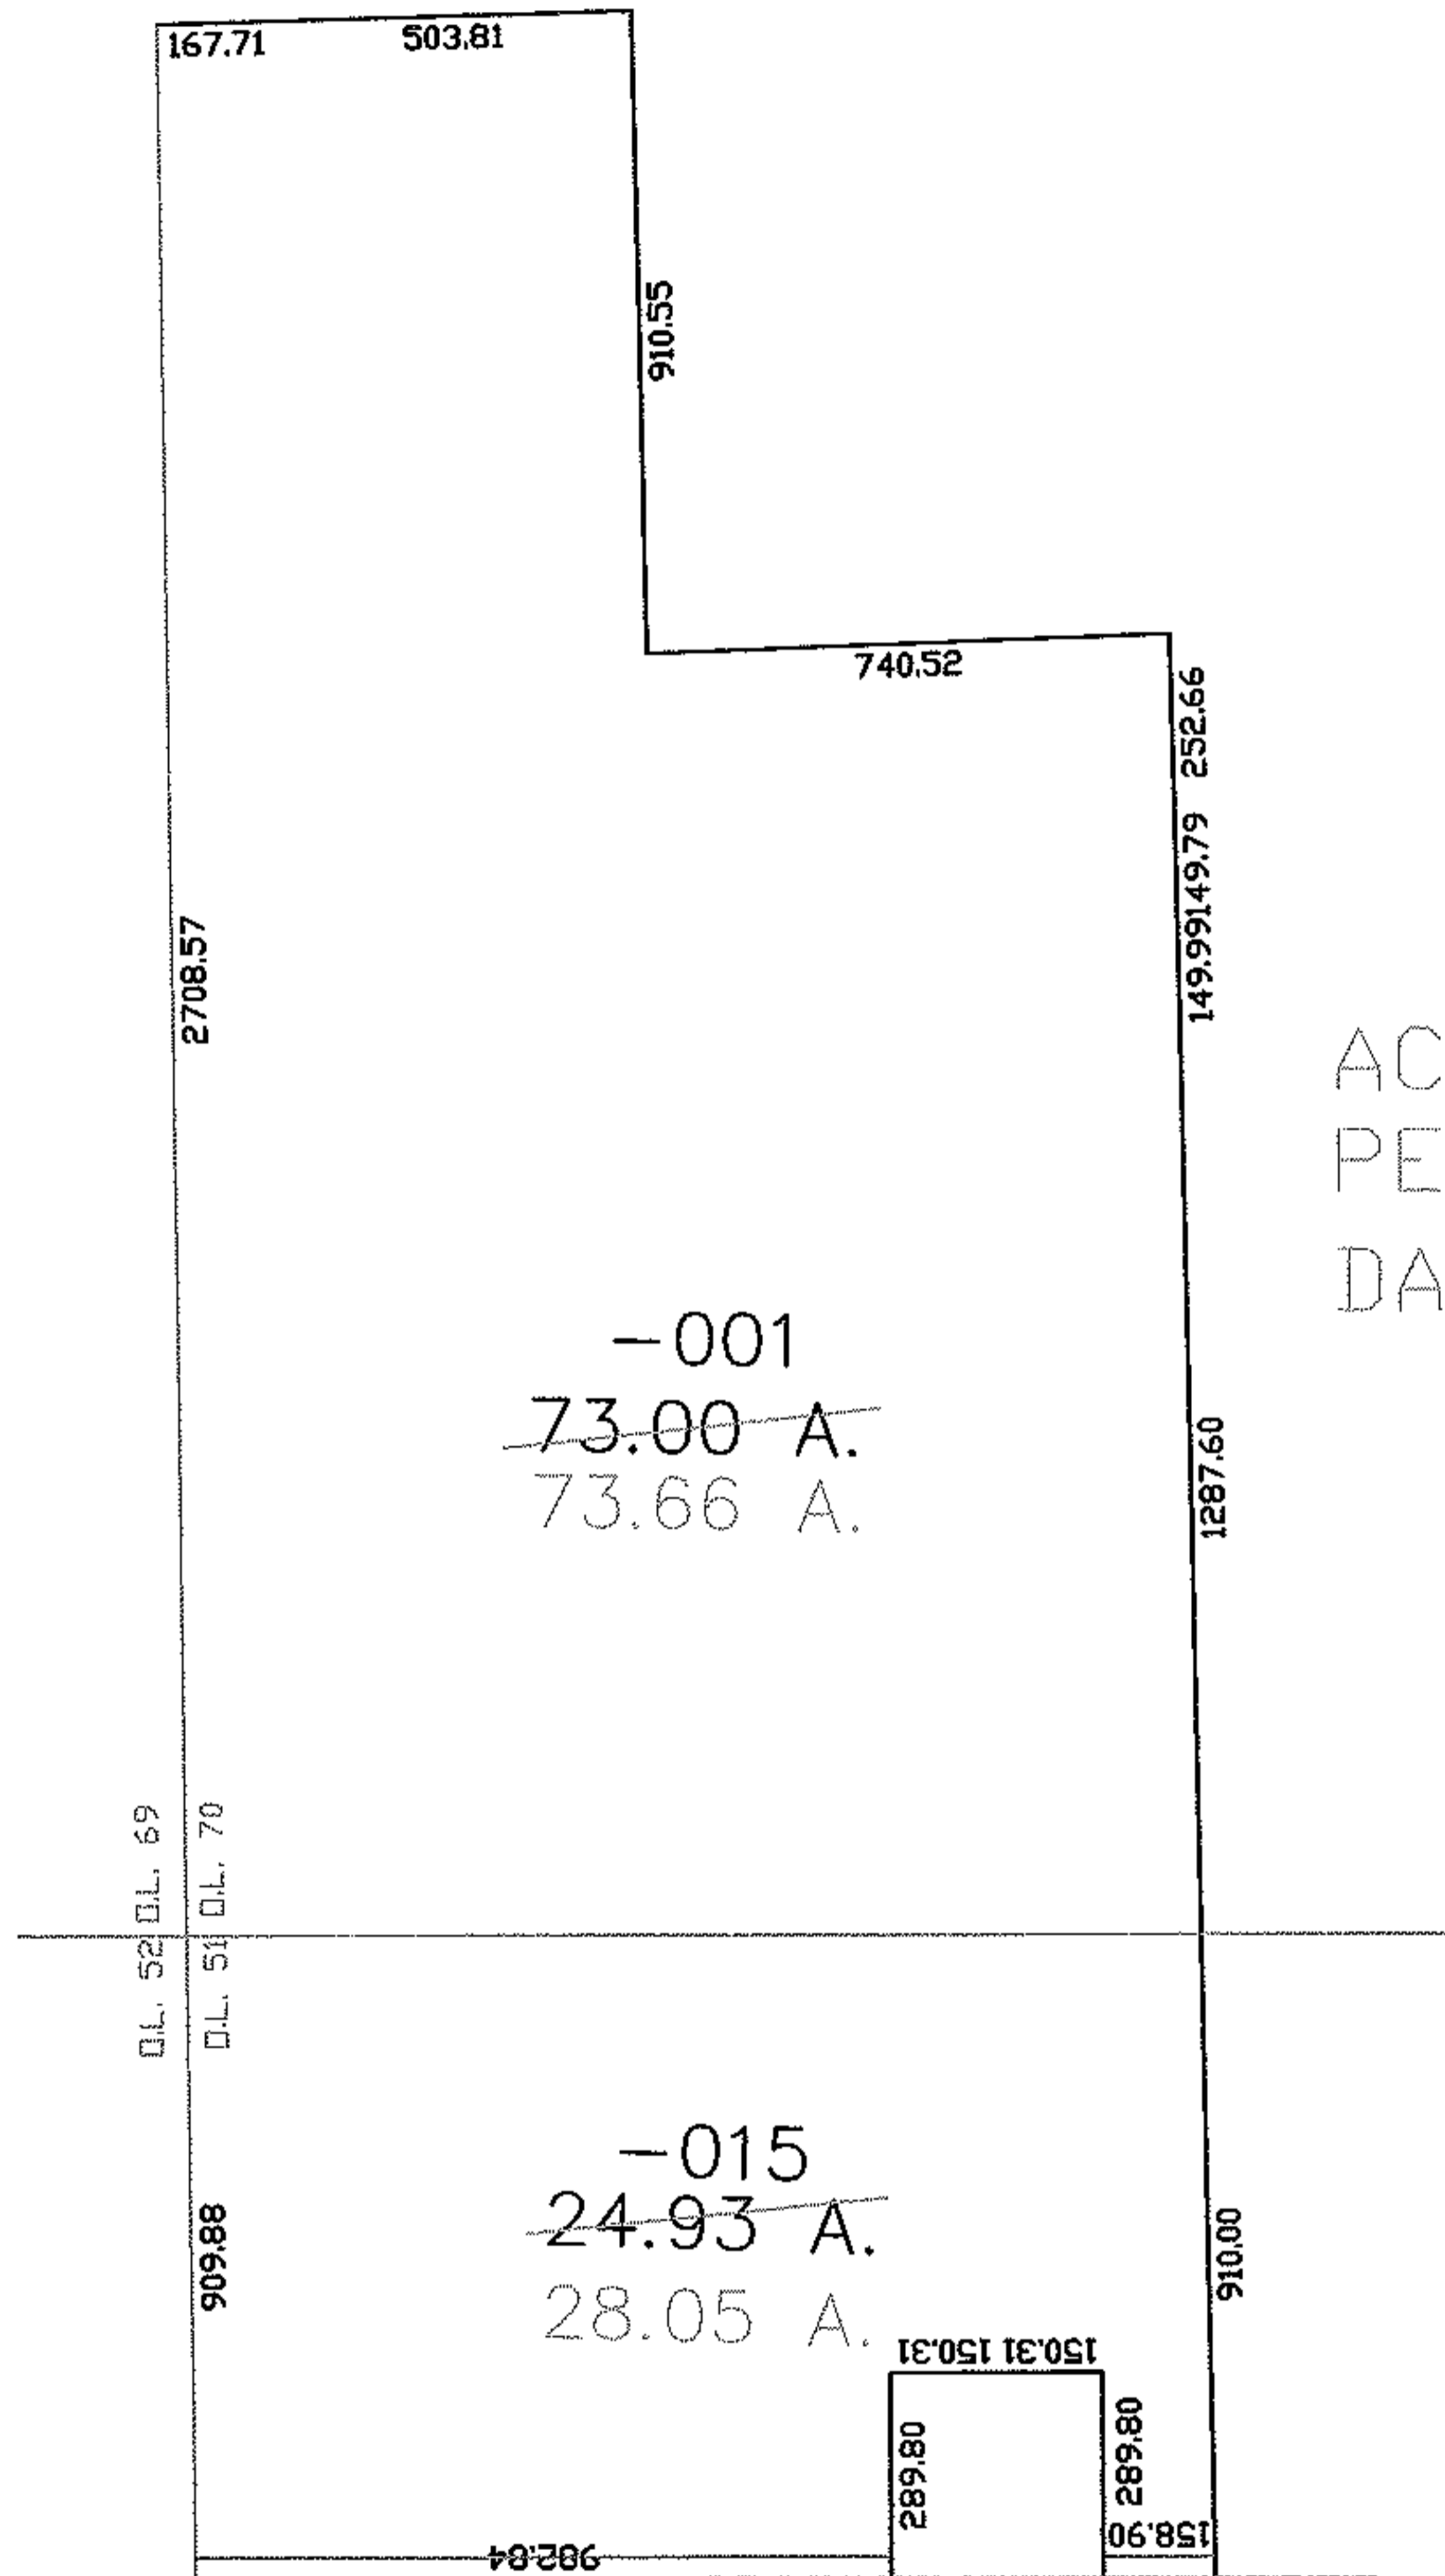

AC. CORR.
PER SURVEY
DALE HAYWOOD

OBERLIN RD.



SPLITS/DEEDS PROCESSED

LORAIN COUNTY TAX MAP DEPARTMENT
226 MIDDLE AVE. ELYRIA, OHIO

SURVEYED BY: DALE HAYWOOD

CLOSURE: 1:10,000

MAP PAGE(S): 05-00-051-B

APPROVED BY: DRH DATE: 5/5/2005

SCALE: 1" = 500 PRIOR INSTRUMENT: