

RASTER




PARENT PARCEL: 02-02-002-000-013, -02-02-009-102-025

NO. 01147-A

CHILD PARCEL: --SAME--

STARTING POINT: MON BOX INT JEAGER RD AND W LINE OF O.L. 9

# AC. CORR. PER SURVEY NICHOLAS MARINO

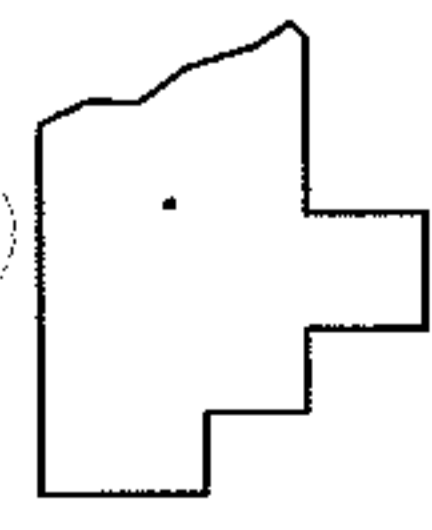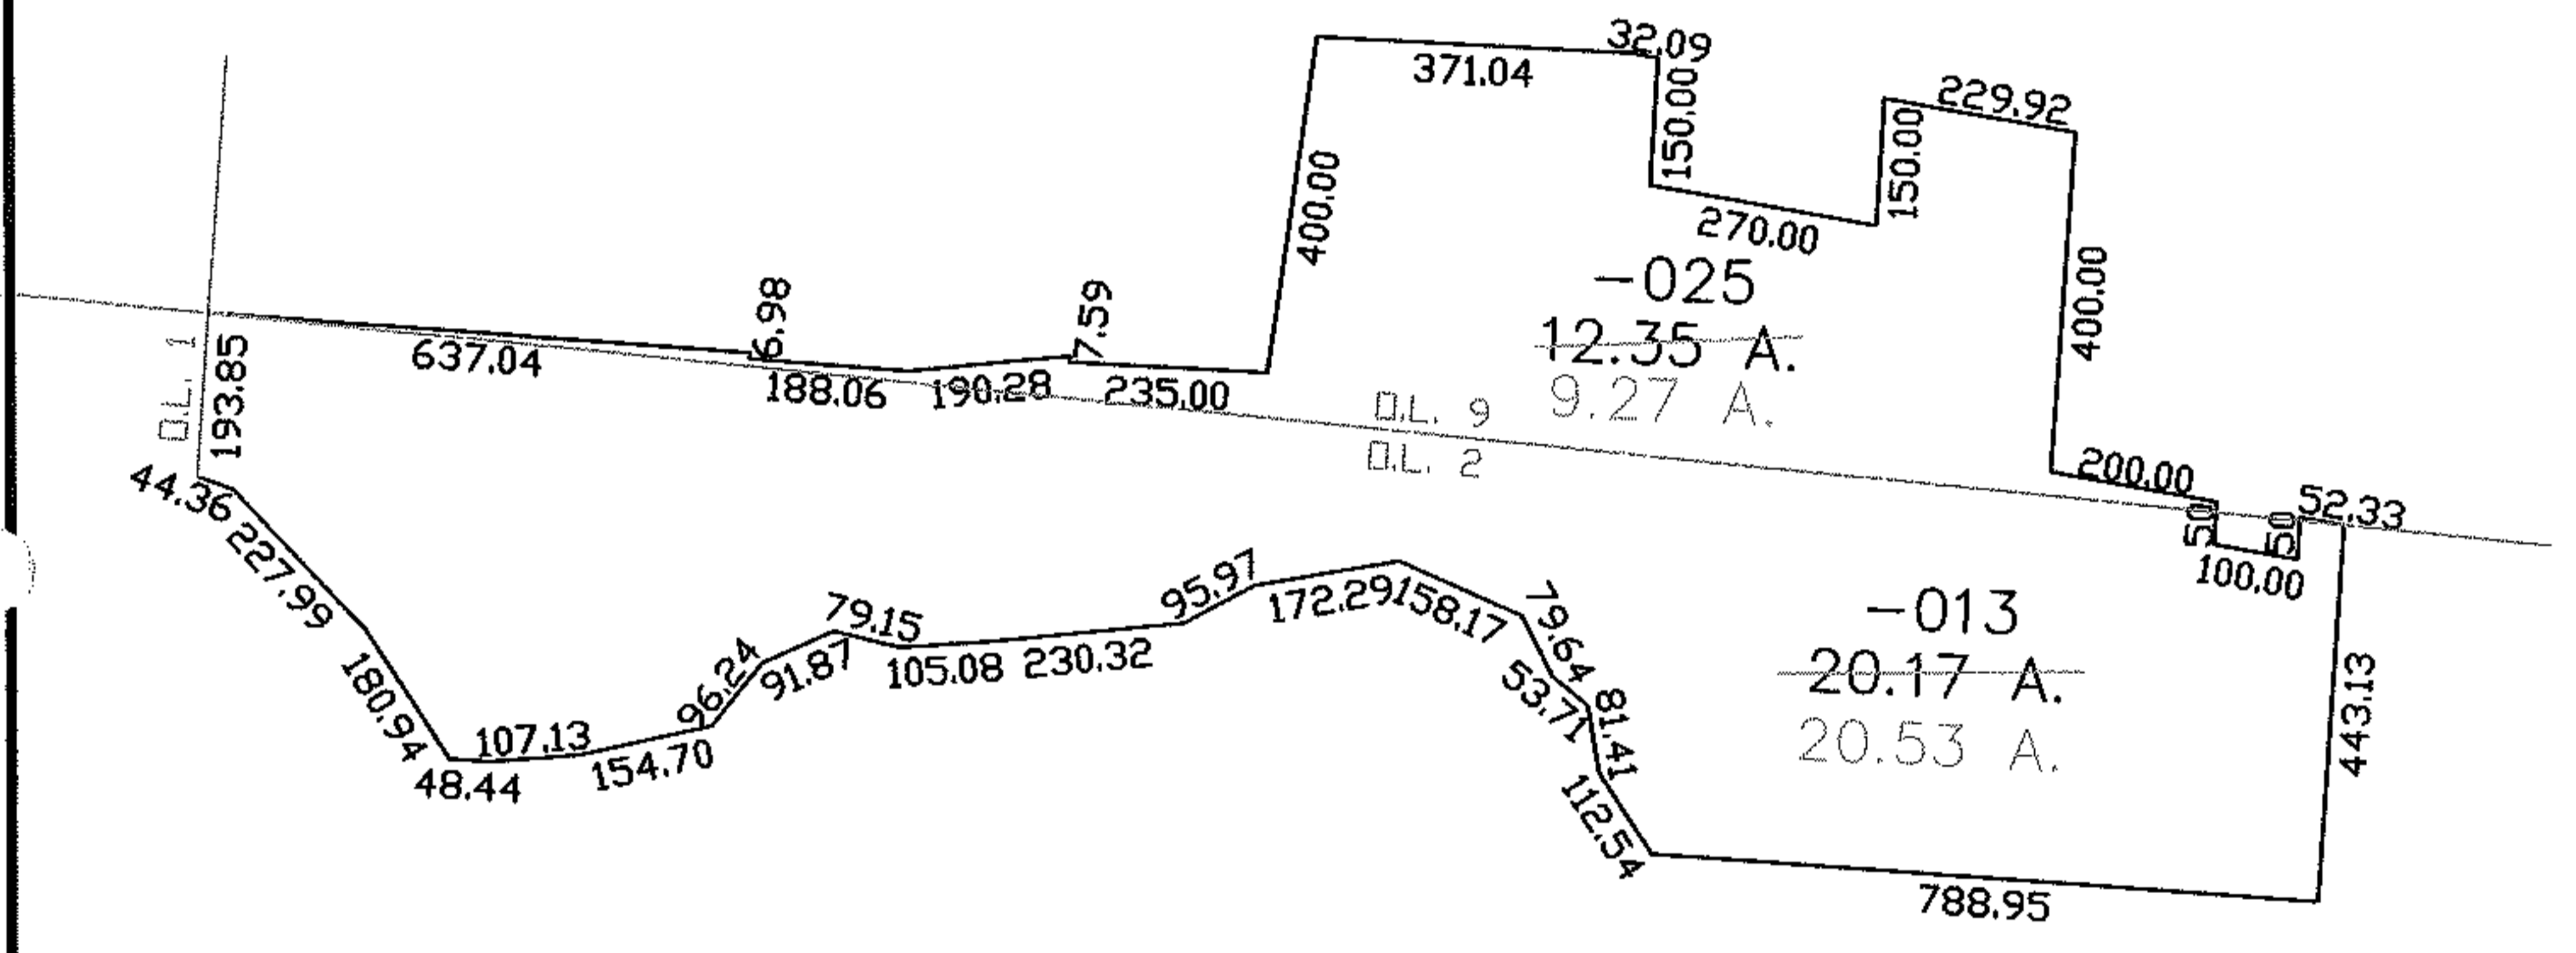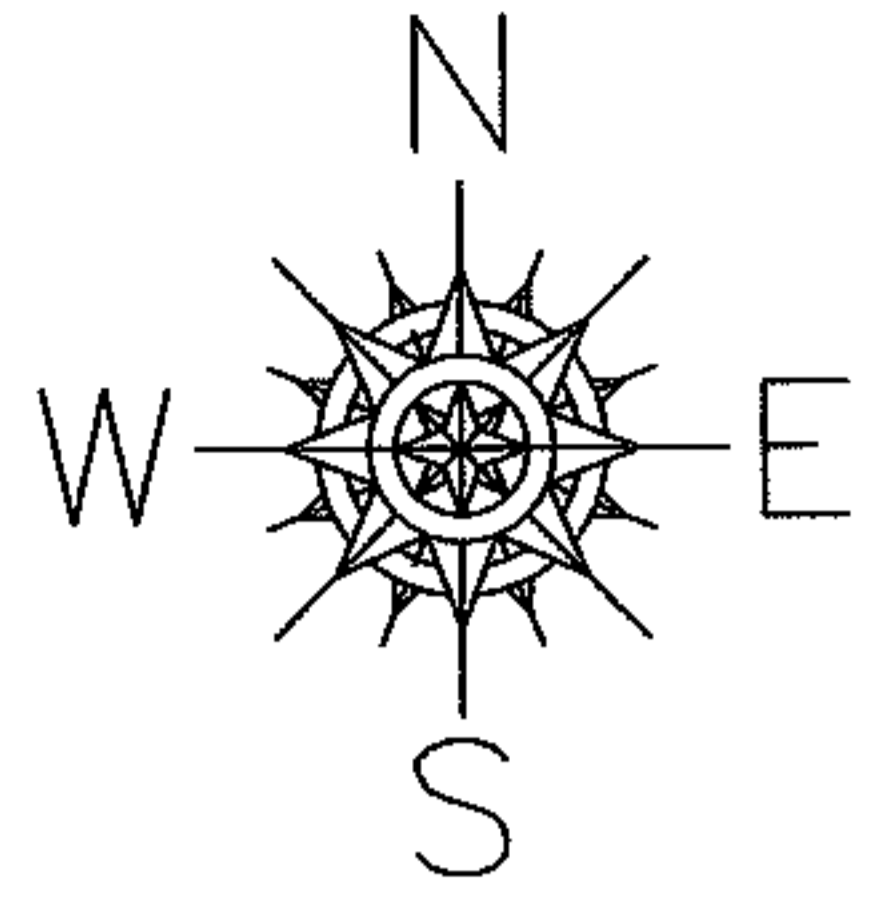

**SPLITS/DEEDS PROCESSED**  
LORAIN COUNTY TAX MAP DEPARTMENT  
226 MIDDLE AVE. ELYRIA, OHIO

SURVEYED BY: NICHOLAS MARINO  
CLOSURE: 1:10,000  
MAP PAGE(S): 02-02-002-A  
APPROVED BY: DRH DATE: 5/9/2005  
SCALE: 1" = 400' PRIOR INSTRUMENT: 970478122