

MASTER




PARENT PARCEL: 07-00-018-106-050

CHILD PARCEL: --SAME--

STARTING POINT:

NO. 01167-C

REGISTER CORRECTION  
MAP HAS CORRECT  
FRONTAGE OF 25 FEET

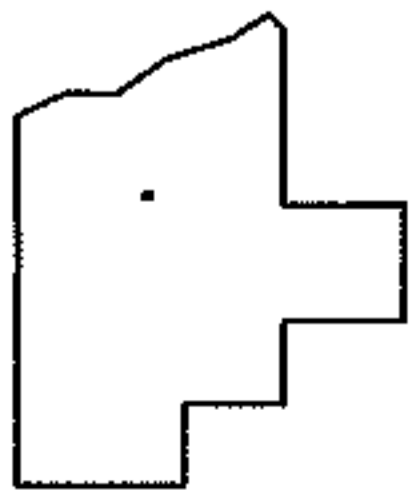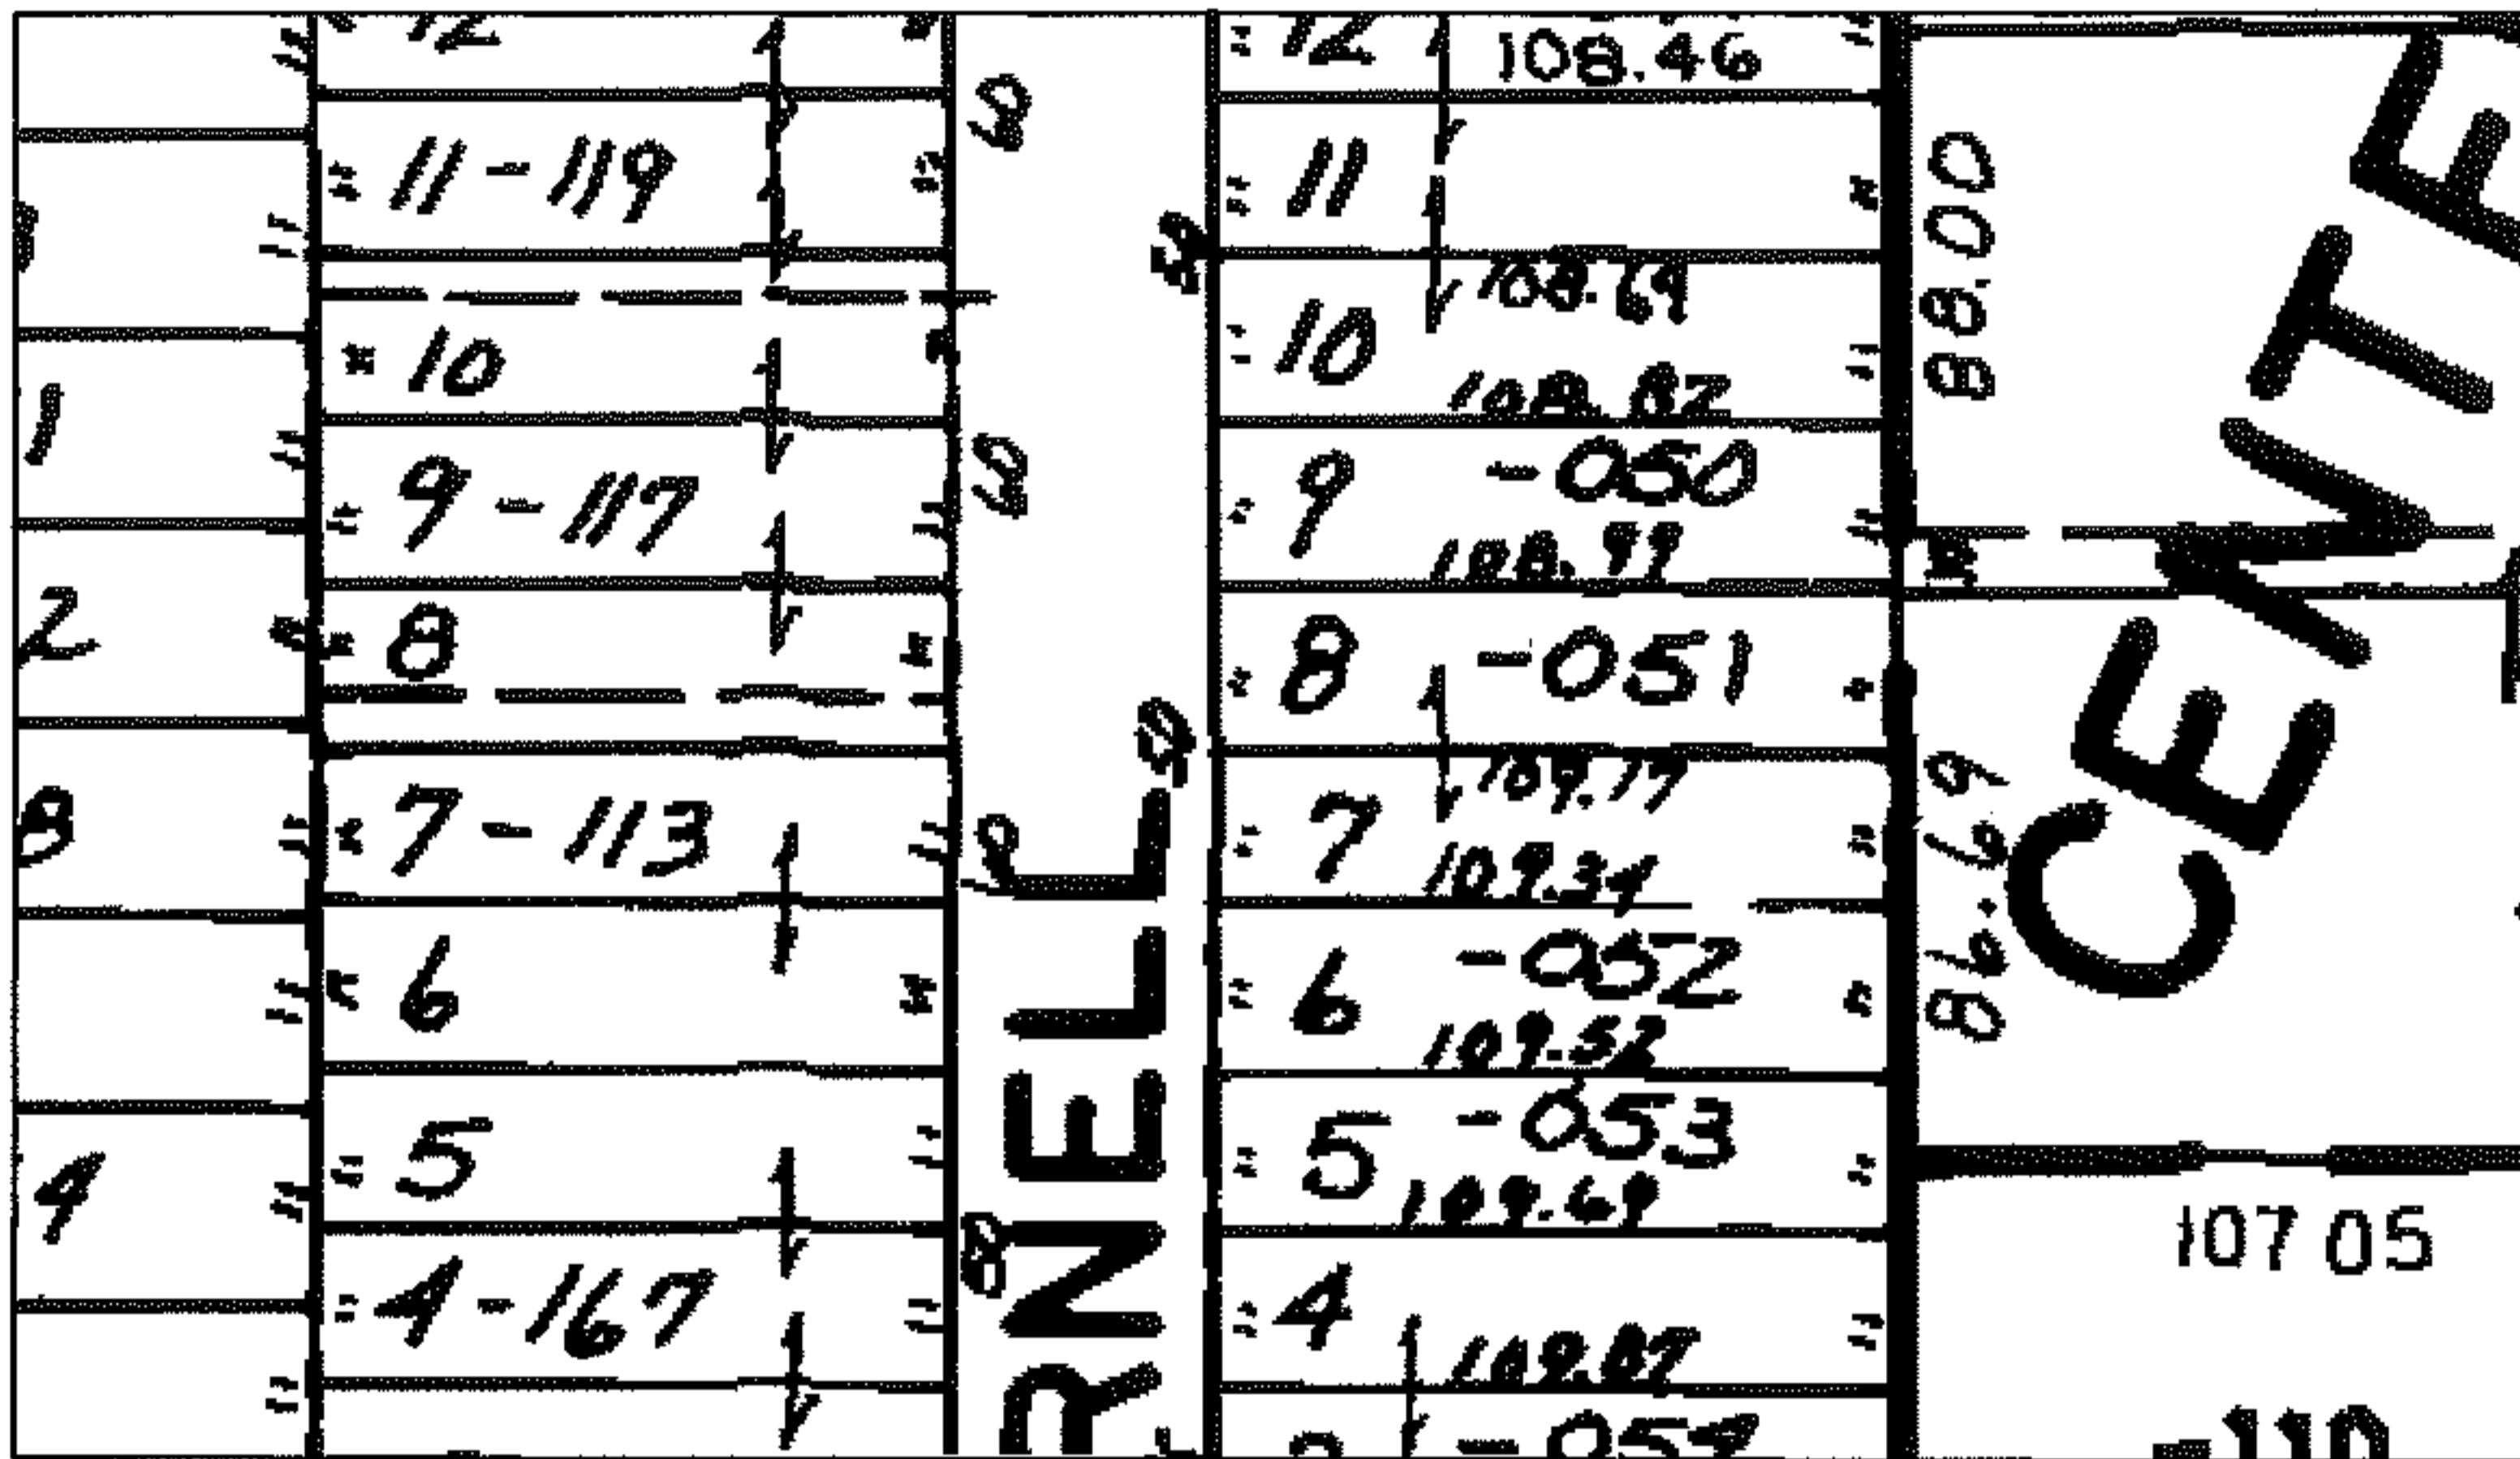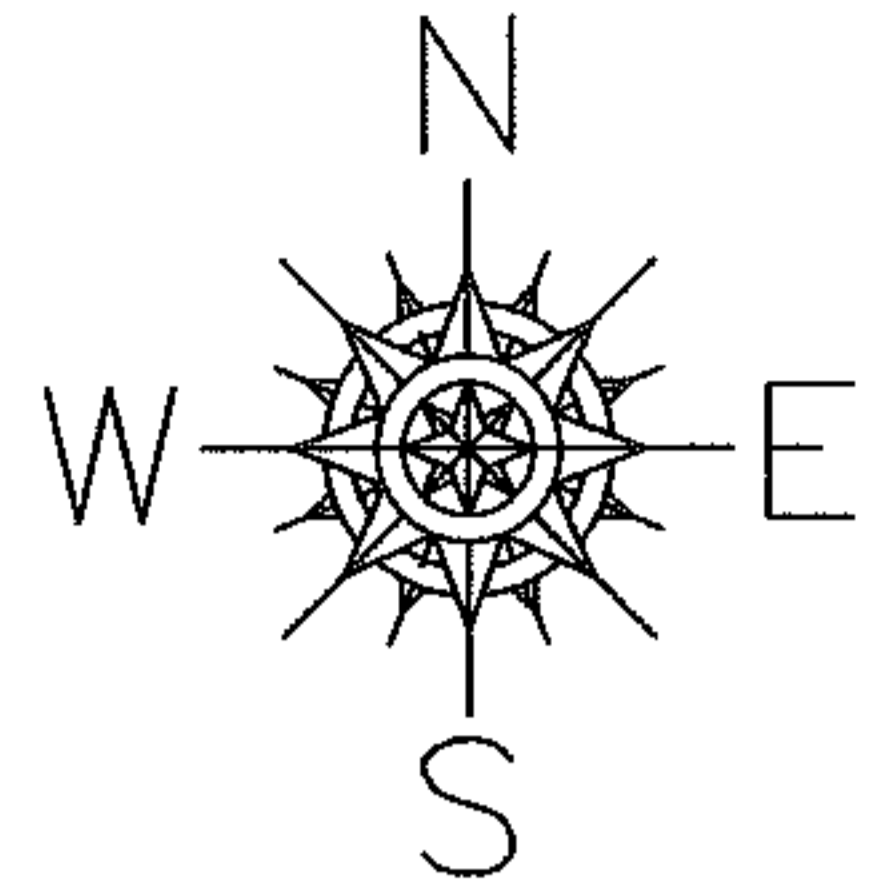

SPLITS/DEEDS PROCESSED

LORAIN COUNTY TAX MAP DEPARTMENT  
226 MIDDLE AVE. ELYRIA, OHIO

SURVEYED BY: N/A

CLOSURE: N/A

MAP PAGE(S): 07-00-018-D

APPROVED BY: DRH DATE: 6/30/2005

SCALE: 1" = 100 PRIOR INSTRUMENT: