


RASTER

PARENT PARCEL: N/A
CHILD PARCEL: N/A
STARTING POINT: N/A

NO. 01169-C

CERT OF CORRECTION

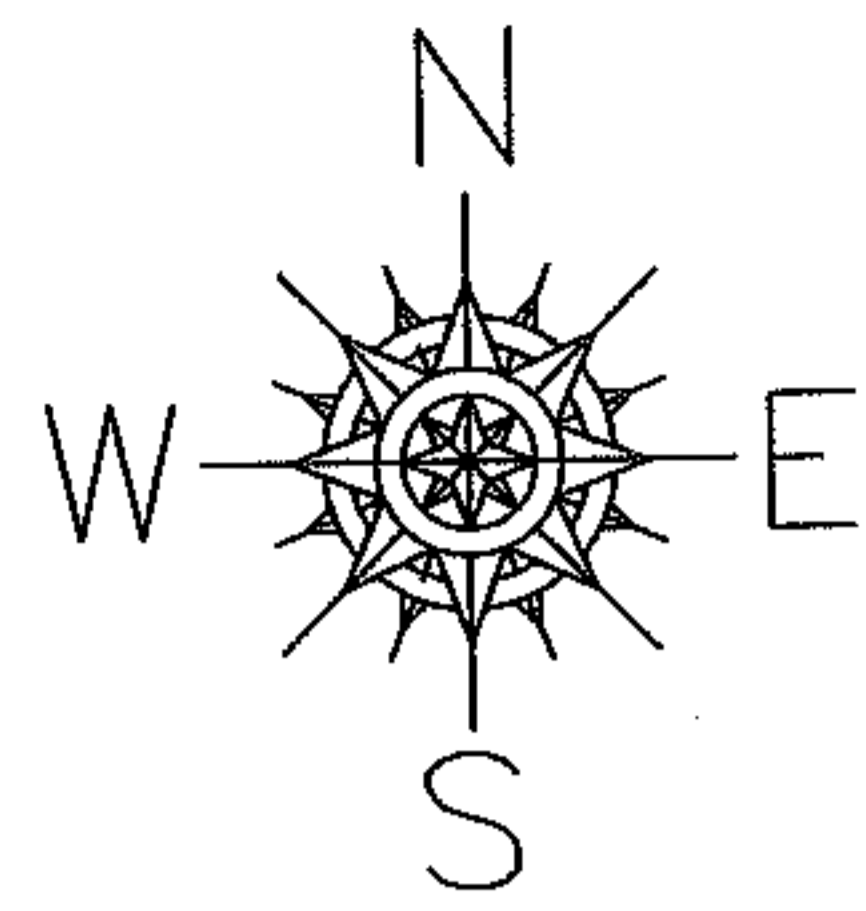


SHADOW CREEK SUB
V. 71 P.19-21

STREET NAME CHANGE
KAR-A-BRU DRIVE CHANGES
TO
SHADOW CREEK TRAIL

PER
DAVID L. ELWELL

SEE ATTACHED SHEET

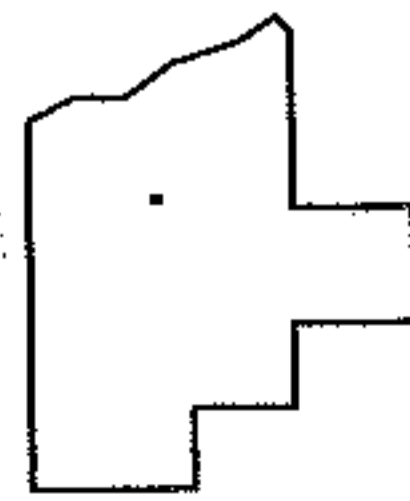

SPLITS/DEEDS PROCESSED
LORAIN COUNTY TAX MAP DEPARTMENT
226 MIDDLE AVE. ELYRIA, OHIO

SURVEYED BY: DAVID L. ELWELL
CLOSURE: N/A
MAP PAGE(S):
APPROVED BY: DRH DATE: 6/30/2005
SCALE: 1" = 100 PRIOR INSTRUMENT: