

EASTER


PARENT PARCEL: 07-00-038-900-002

CHILD PARCEL: 07-00-038-000-300


STARTING POINT: R.R.S. E OF INT WITH RACE RD

NO. 01172-V


# STREET VACATION ORD # 3932-2003

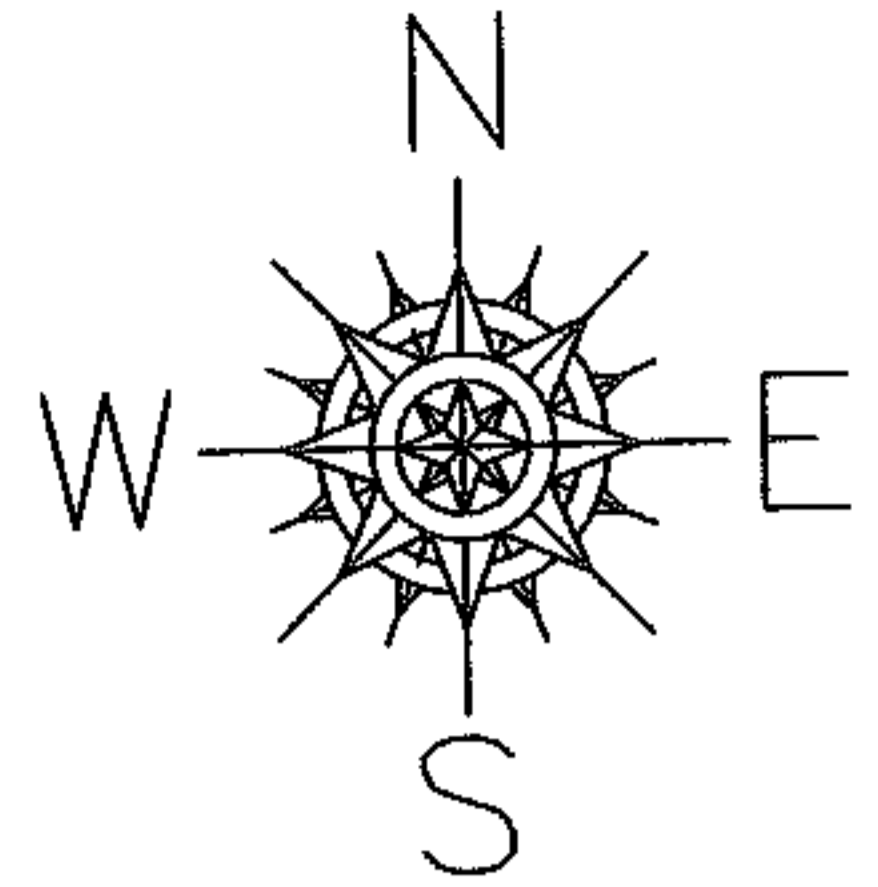

CONRAIL RAILROAD

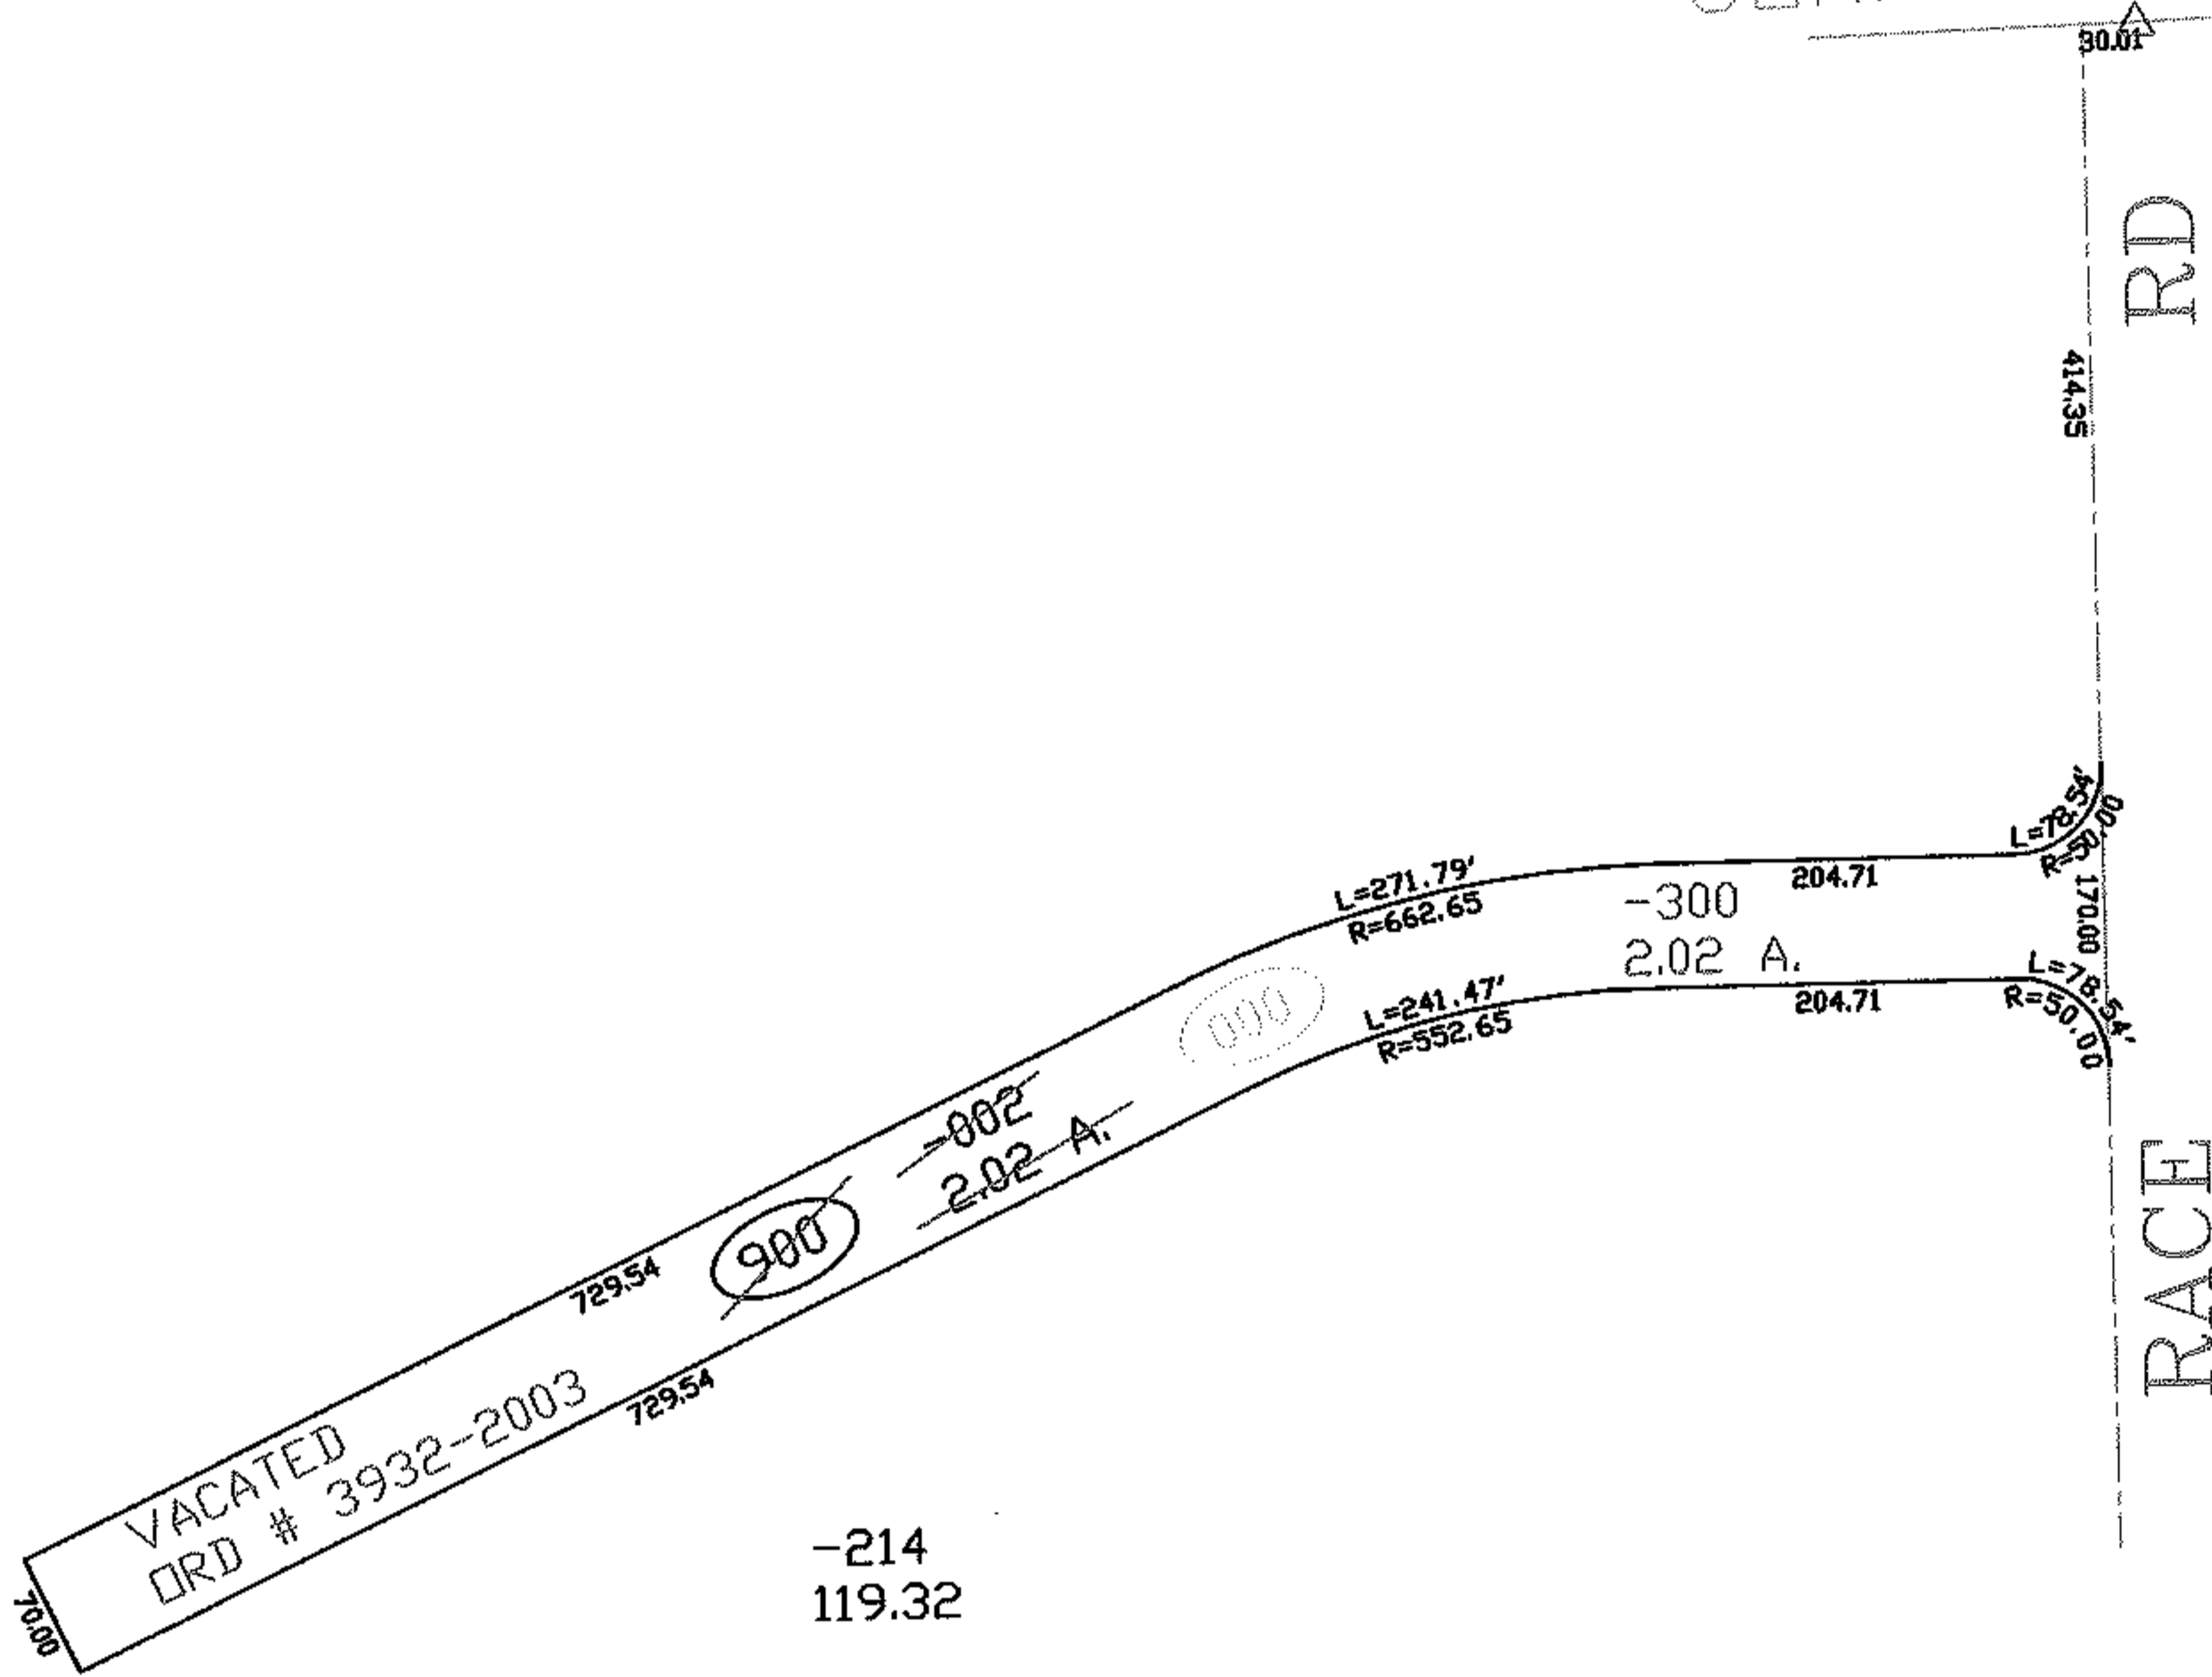

SURVEYED BY: \_\_\_\_\_  
 CLOSURE: 1:10,000  
 MAP PAGE(S): 07-00-038-B  
 APPROVED BY: DRH DATE: 7/15/2005  
 SCALE: 1" = 200' PRIOR INSTRUMENT: \_\_\_\_\_

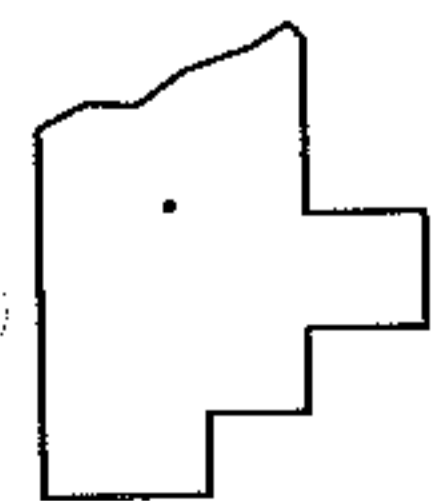

**SPLITS/DEEDS PROCESSED**  
 LORAIN COUNTY TAX MAP DEPARTMENT  
 226 MIDDLE AVE. ELYRIA, OHIO