


RASTER

PARENT PARCEL: 01-00-005-104-067
CHILD PARCEL: --SAME--
STARTING POINT: INT CL U.S. RT. 2 AND SUNNYSIDE RD

NO. 01173-C

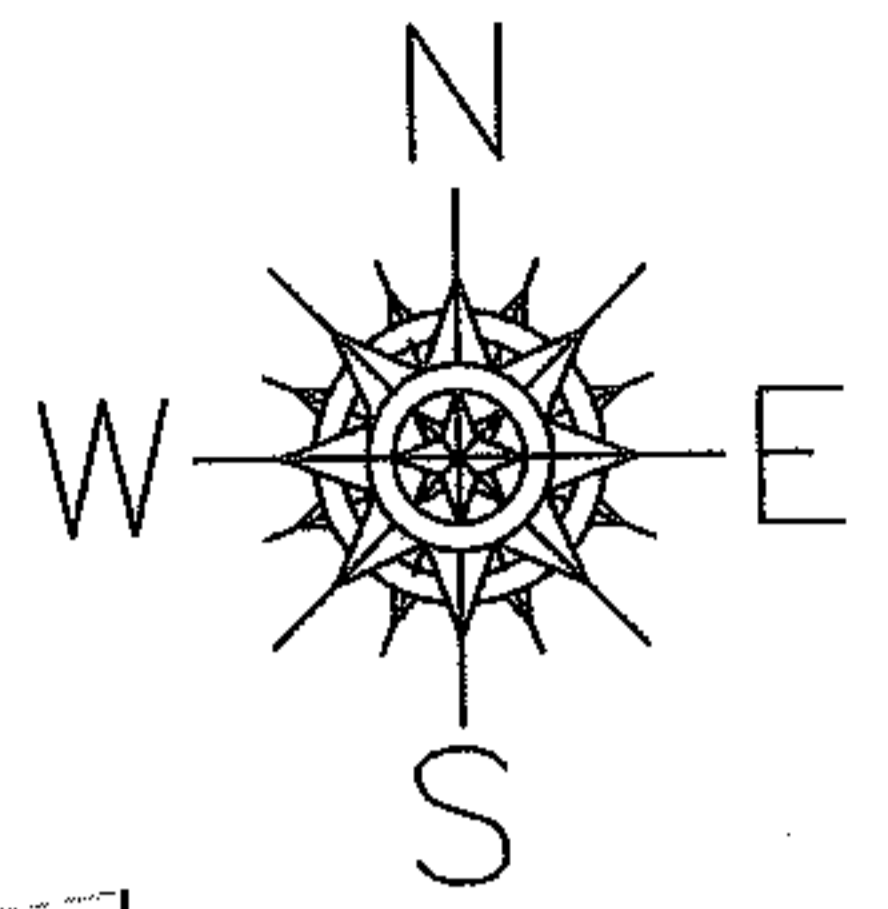

SUNNYSIDE RD

U.S. RT. 2

693.00

414.40

999.91

968.54

~~-067~~


~~9.67 A.~~

9.61 A.

207.32

235.54

AC. CORR.
PER SURVEY
HOWARD R. SELEE

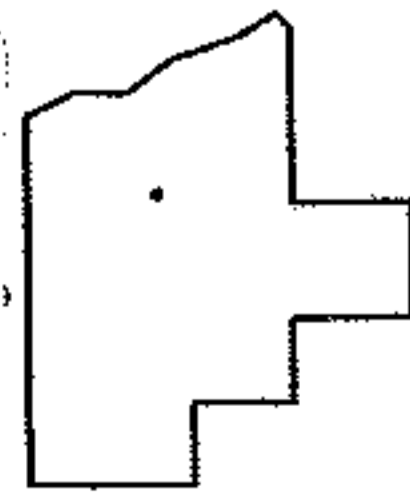

SPLITS/DEEDS PROCESSED
LORAIN COUNTY TAX MAP DEPARTMENT
226 MIDDLE AVE. ELYRIA, OHIO

SURVEYED BY: HOWARD R. SELEE
CLOSURE: 1:10,000
MAP PAGE(S): 01-00-005-C
APPROVED BY: DRH DATE: 7/18/2005
SCALE: 1" = 200 PRIOR INSTRUMENT: _____