

MASTER




PARENT PARCEL: 11-00-096-000-012

NO. 01193-A

CHILD PARCEL: --SAME--

STARTING POINT:

AC. CORR.
PER SURVEY
T.W. LAUNDON

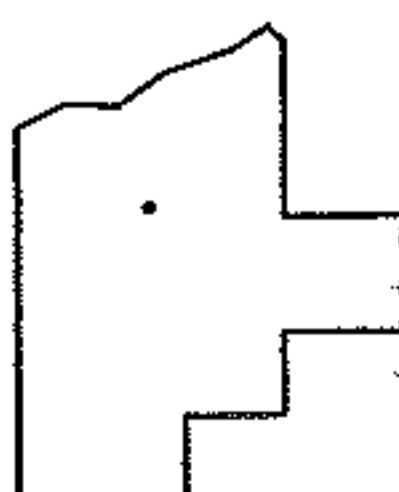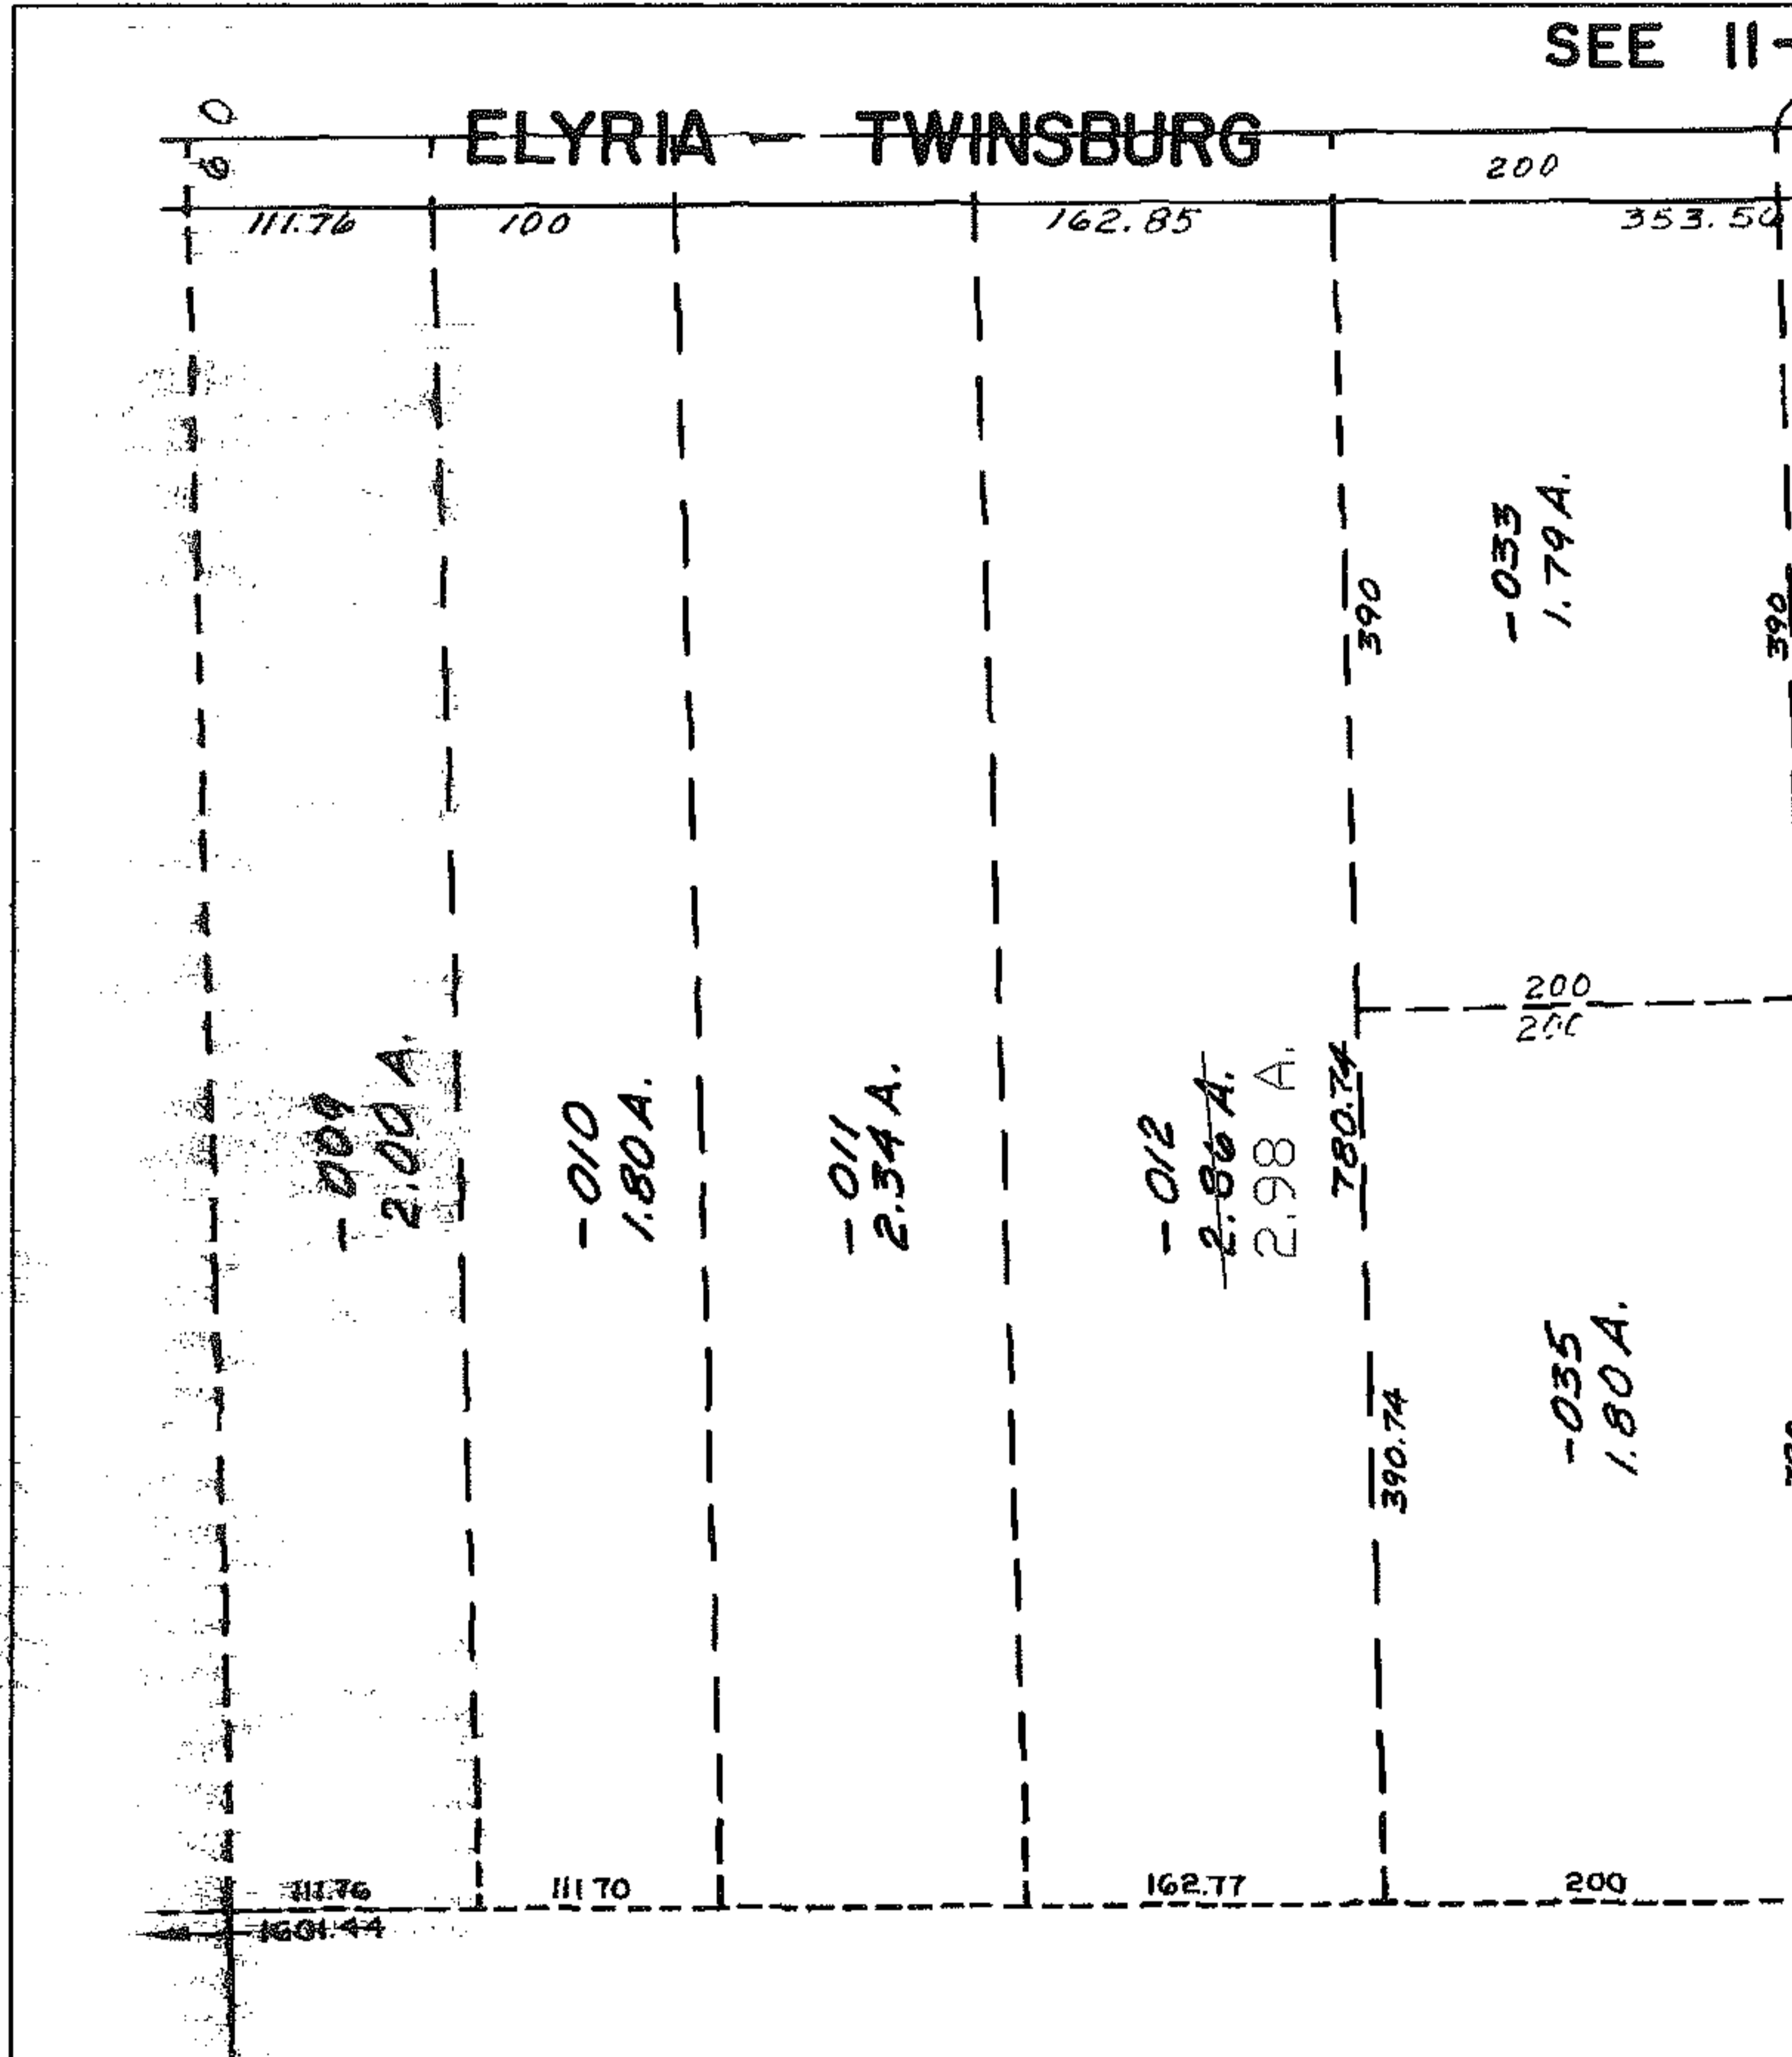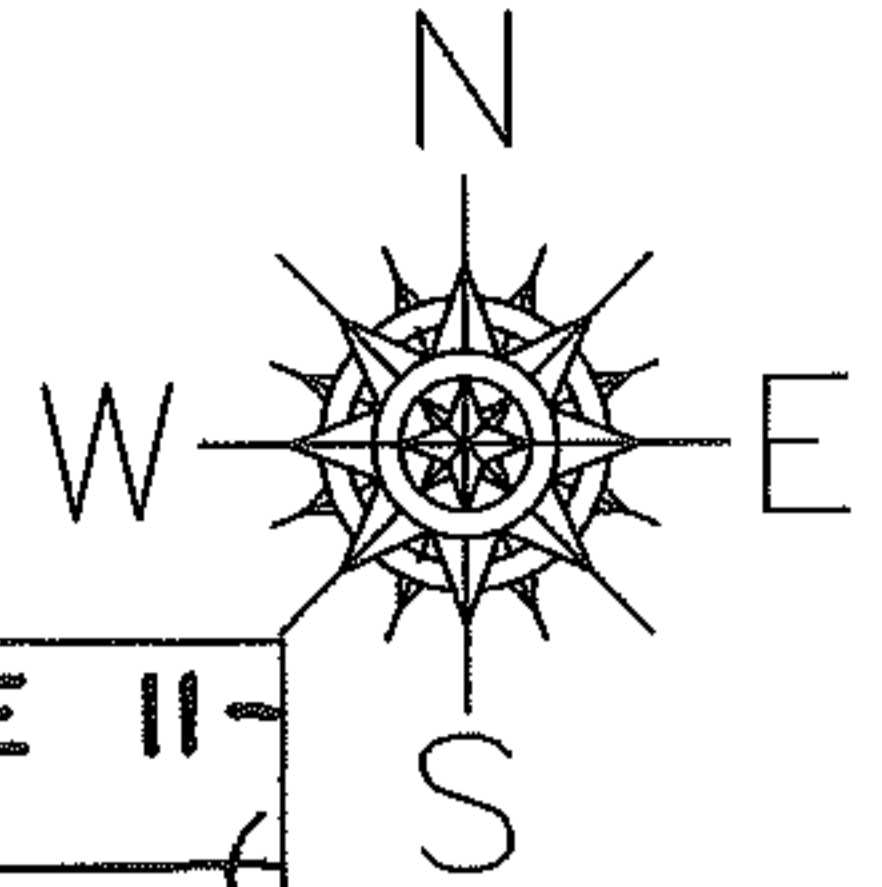

SPLITS/DEEDS PROCESSED

LORAIN COUNTY TAX MAP DEPARTMENT
226 MIDDLE AVE. ELYRIA, OHIO

SURVEYED BY: T. W. LAUNDON

CLOSURE: 1:10,000

MAP PAGE(S): 11-00-096-B

APPROVED BY: DRH DATE: 8/29/2005

SCALE: 1" = 200' PRIOR INSTRUMENT: 20040036968