


PARENT PARCEL: 06-25-003-103-030


CHILD PARCEL: --SAME--

STARTING POINT:

05-01195-C

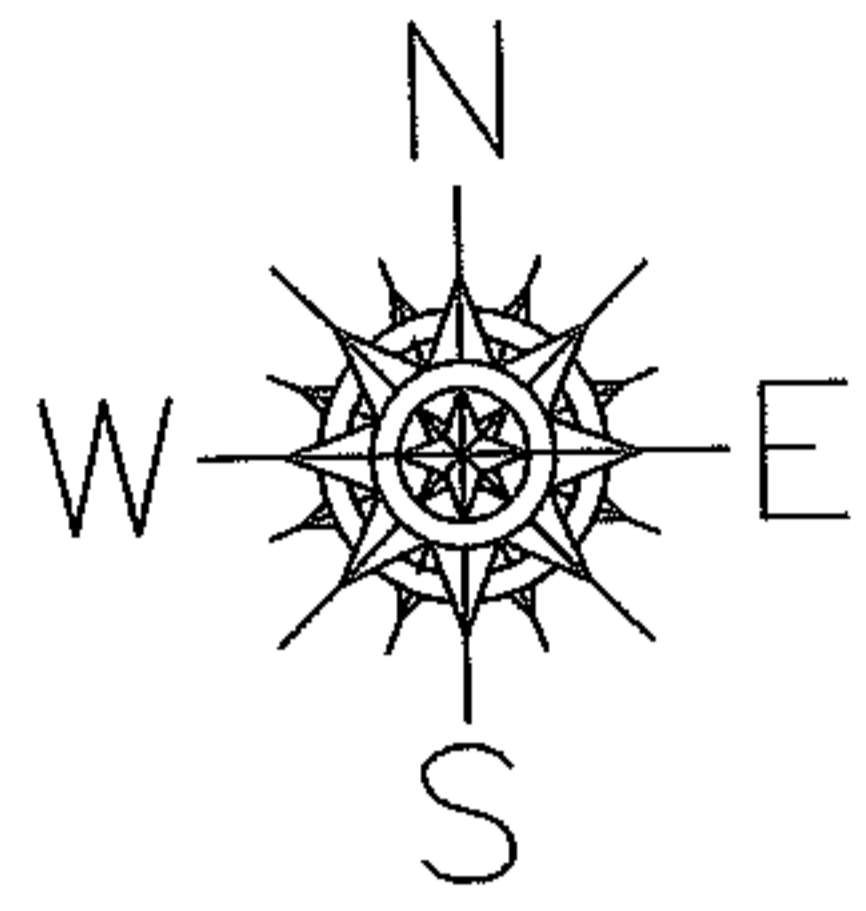

DEPTH
 CORRECTION
 06-25-003-103-030
 NO MAP CHANGES
 54.69 X ~~177~~
 170.64

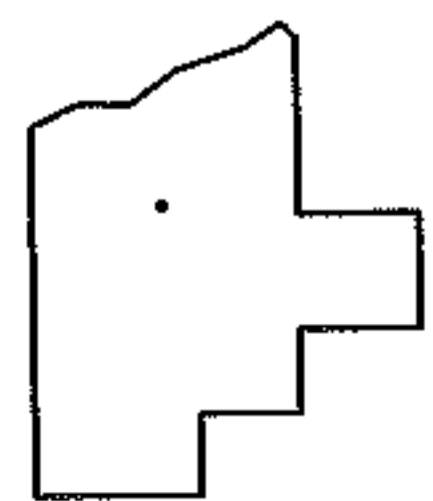

SPLITS/DEEDS PROCESSED
 LORAIN COUNTY TAX MAP DEPARTMENT
 226 MIDDLE AVE. ELYRIA, OHIO

SURVEYED BY: N/A
 CLOSURE: N/A
 MAP PAGE(S): 6-139
 APPROVED BY: DRH DATE: 9/1/2005
 SCALE: 1" = 100 PRIOR INSTRUMENT: