




PARENT PARCEL: 04-00-030-104-014

05-01198-C

CHILD PARCEL: --SAME--

STARTING POINT:

MAP CORR ONLY
PER SURVEY
DAVID ELWELL

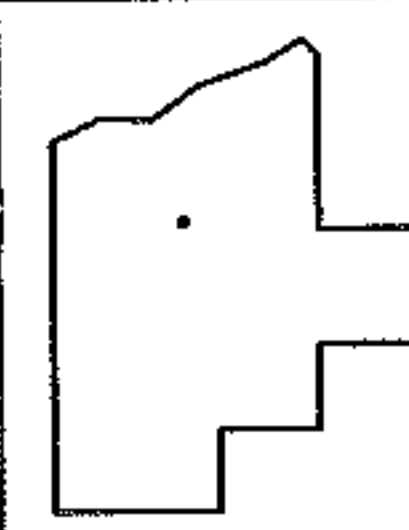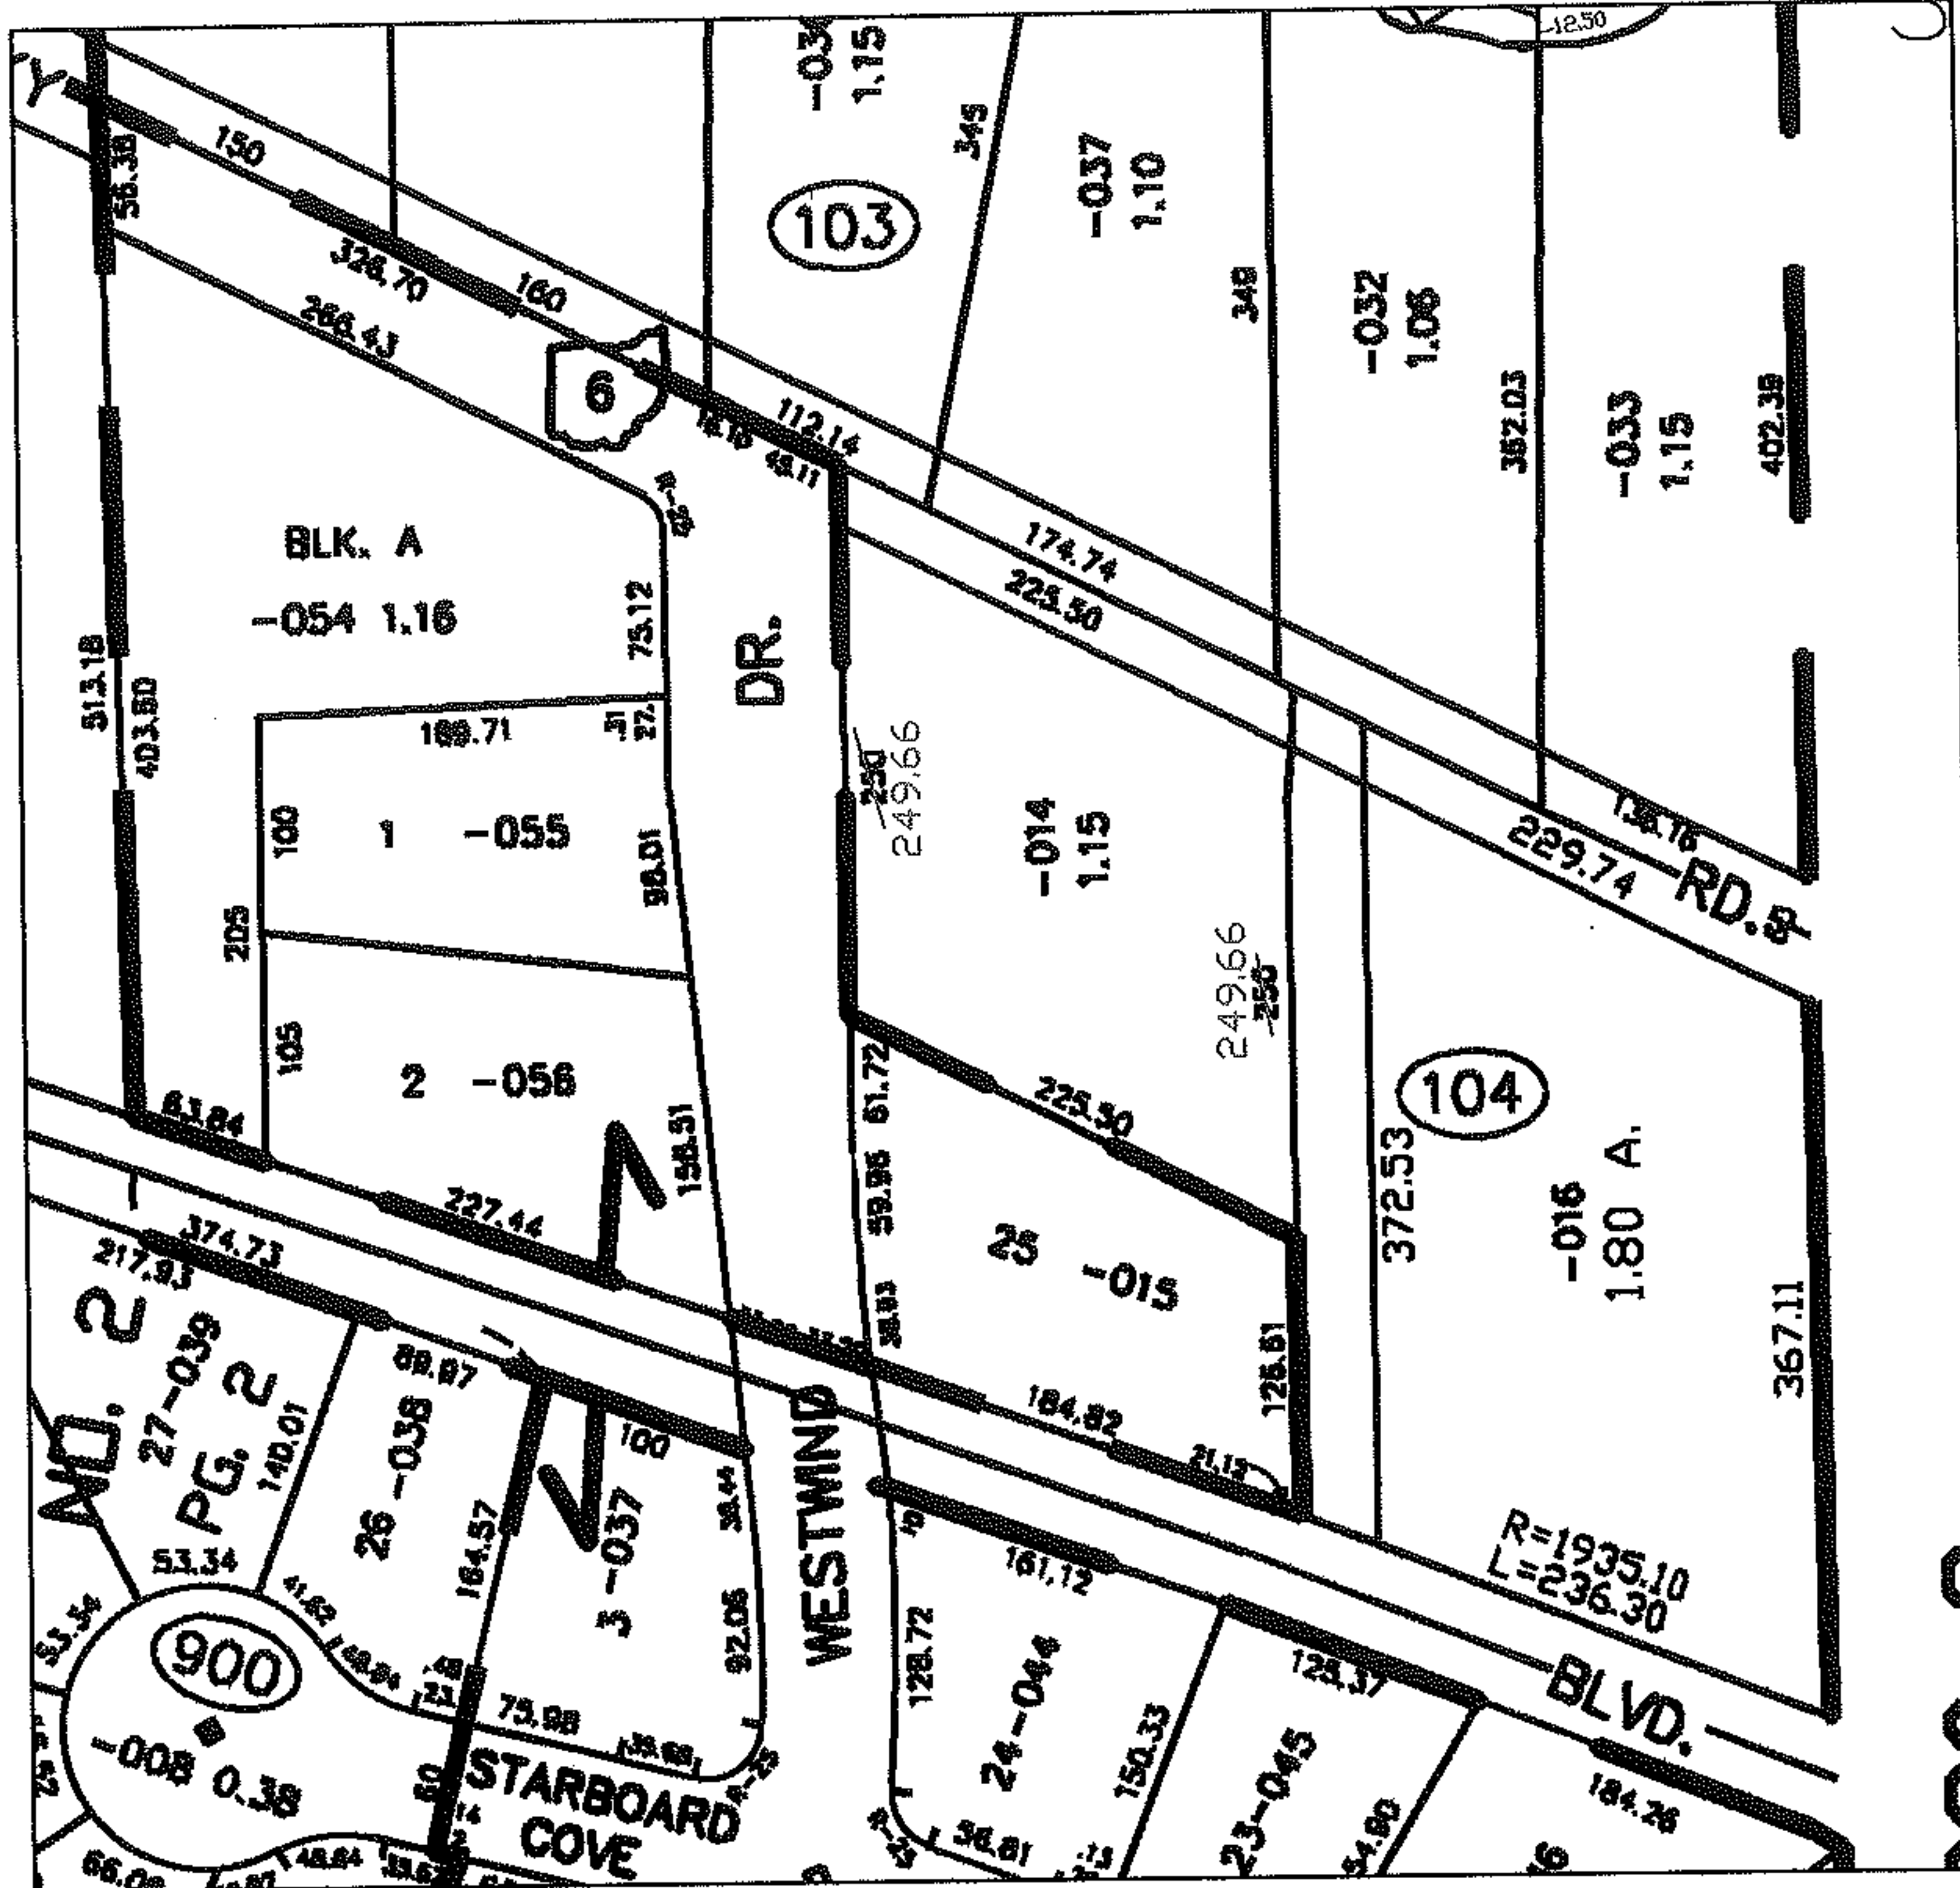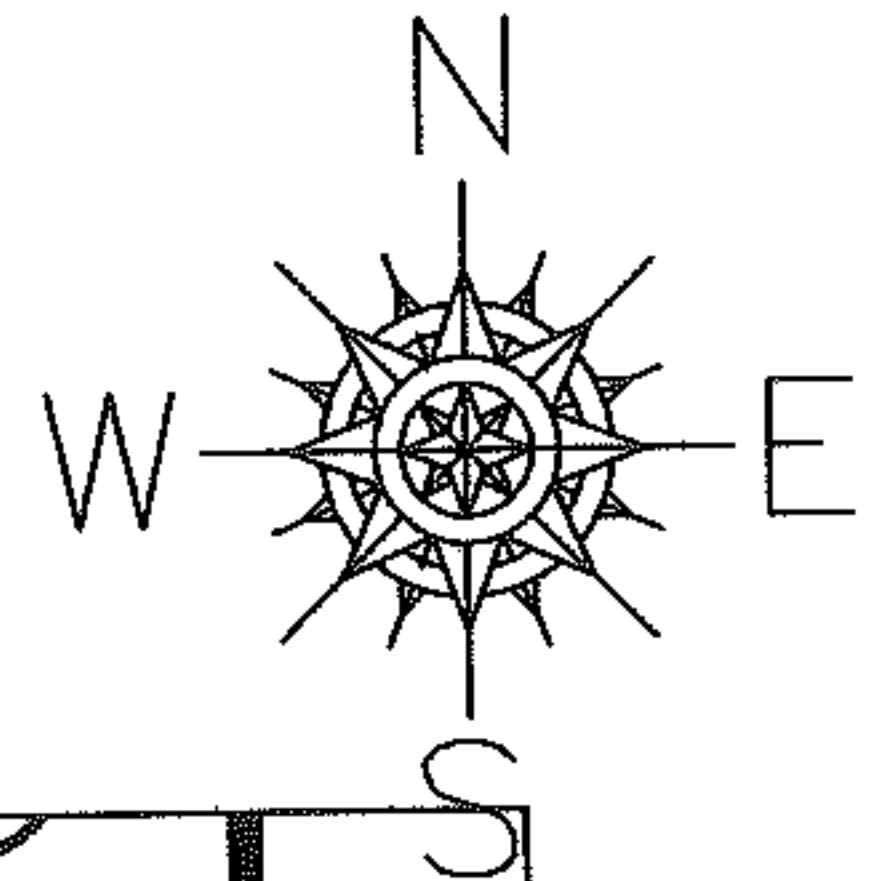

SPLITS/DEEDS PROCESSED
LORAIN COUNTY TAX MAP DEPARTMENT
226 MIDDLE AVE. ELYRIA, OHIO

SURVEYED BY: DAVID L. ELWELL
CLOSURE: 1:10,000
MAP PAGE(S): 04-00-030-B
APPROVED BY: DRH DATE: 9/14/2005
SCALE: 1" = 200 PRIOR INSTRUMENT: 20050095195