

RASTER


05-01202-A

PARENT PARCEL: 07-00-025-106-037

CHILD PARCEL: --SAME--

STARTING POINT: MON BOX INT ARCHER RD AND CHESTNUT RIDGE RD

AC. CORR.  
PER SURVEY  
DAVID ELWELL

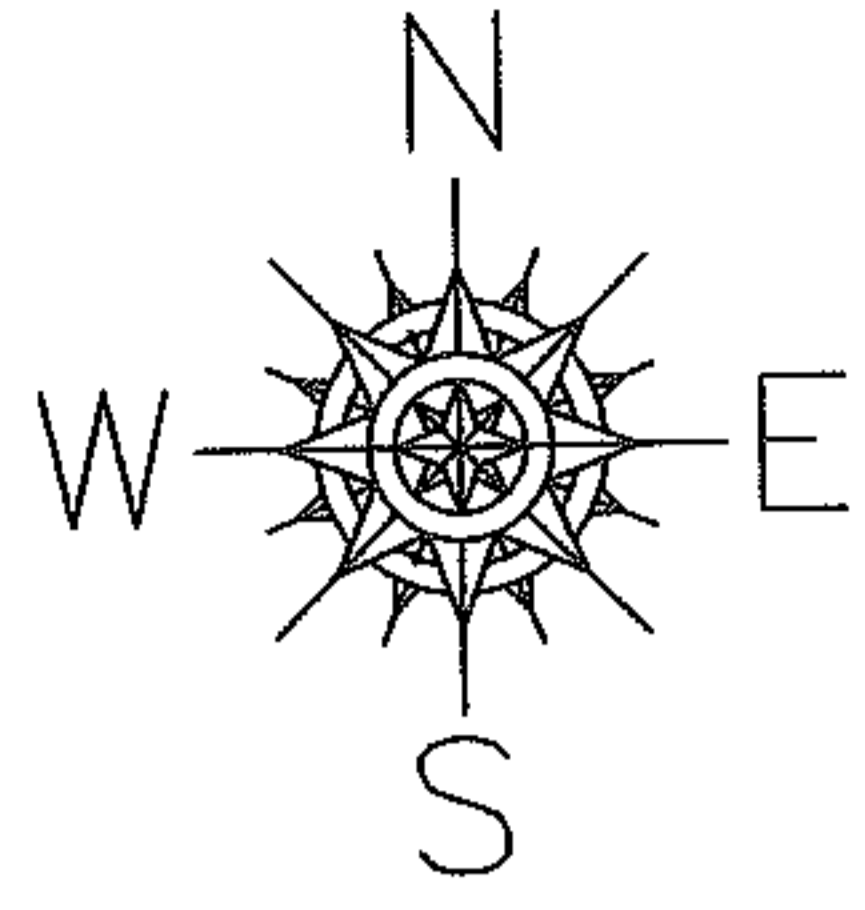

CHESTNUT RIDGE RD  
1975.19

615.75

35.17

211.45

156.26


125.22

-037  
~~2.01~~ A.  
1.97 A.

462.67

313.19

ARCHER RD

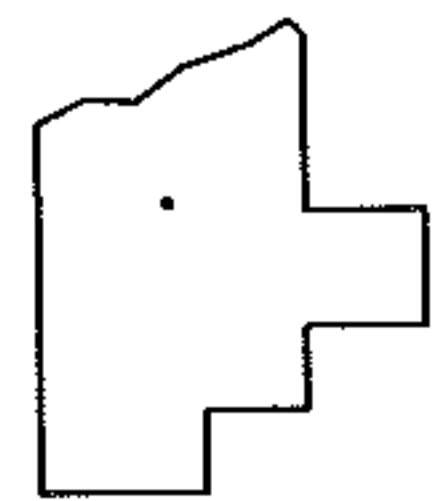

**SPLITS/DEEDS PROCESSED**

LORAIN COUNTY TAX MAP DEPARTMENT  
226 MIDDLE AVE. ELYRIA, OHIO

SURVEYED BY: DAVID L. ELWELL

CLOSURE: 1:10,000

MAP PAGE(S): 07-00-025-C

APPROVED BY: DRH DATE: 9/9/2005

SCALE: 1" = 200 PRIOR INSTRUMENT: 20050080952