


PARENT PARCEL: 06-24-107-000-011

CHILD PARCEL: --SAME--


STARTING POINT: INT E LINE OF WEST RIVER RD S AND S LINE OF W BRIDGE ST

05-01203-C

AC. CORR.  
PER SURVEY  
DALE HAYWOOD

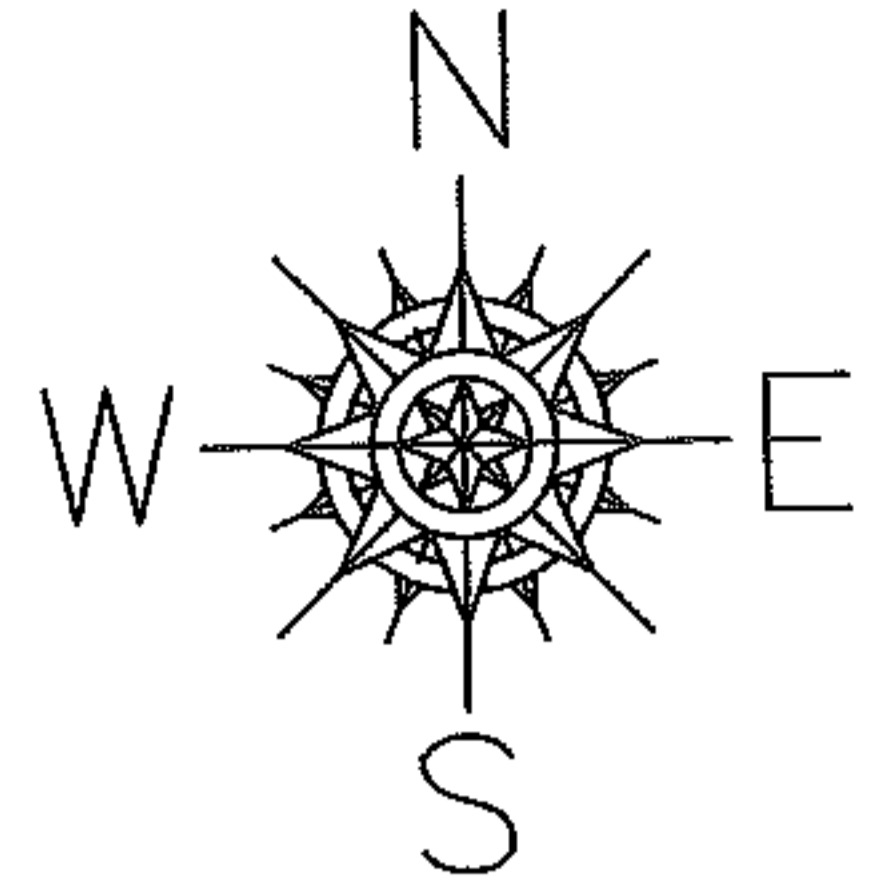

WEST RIVER RD

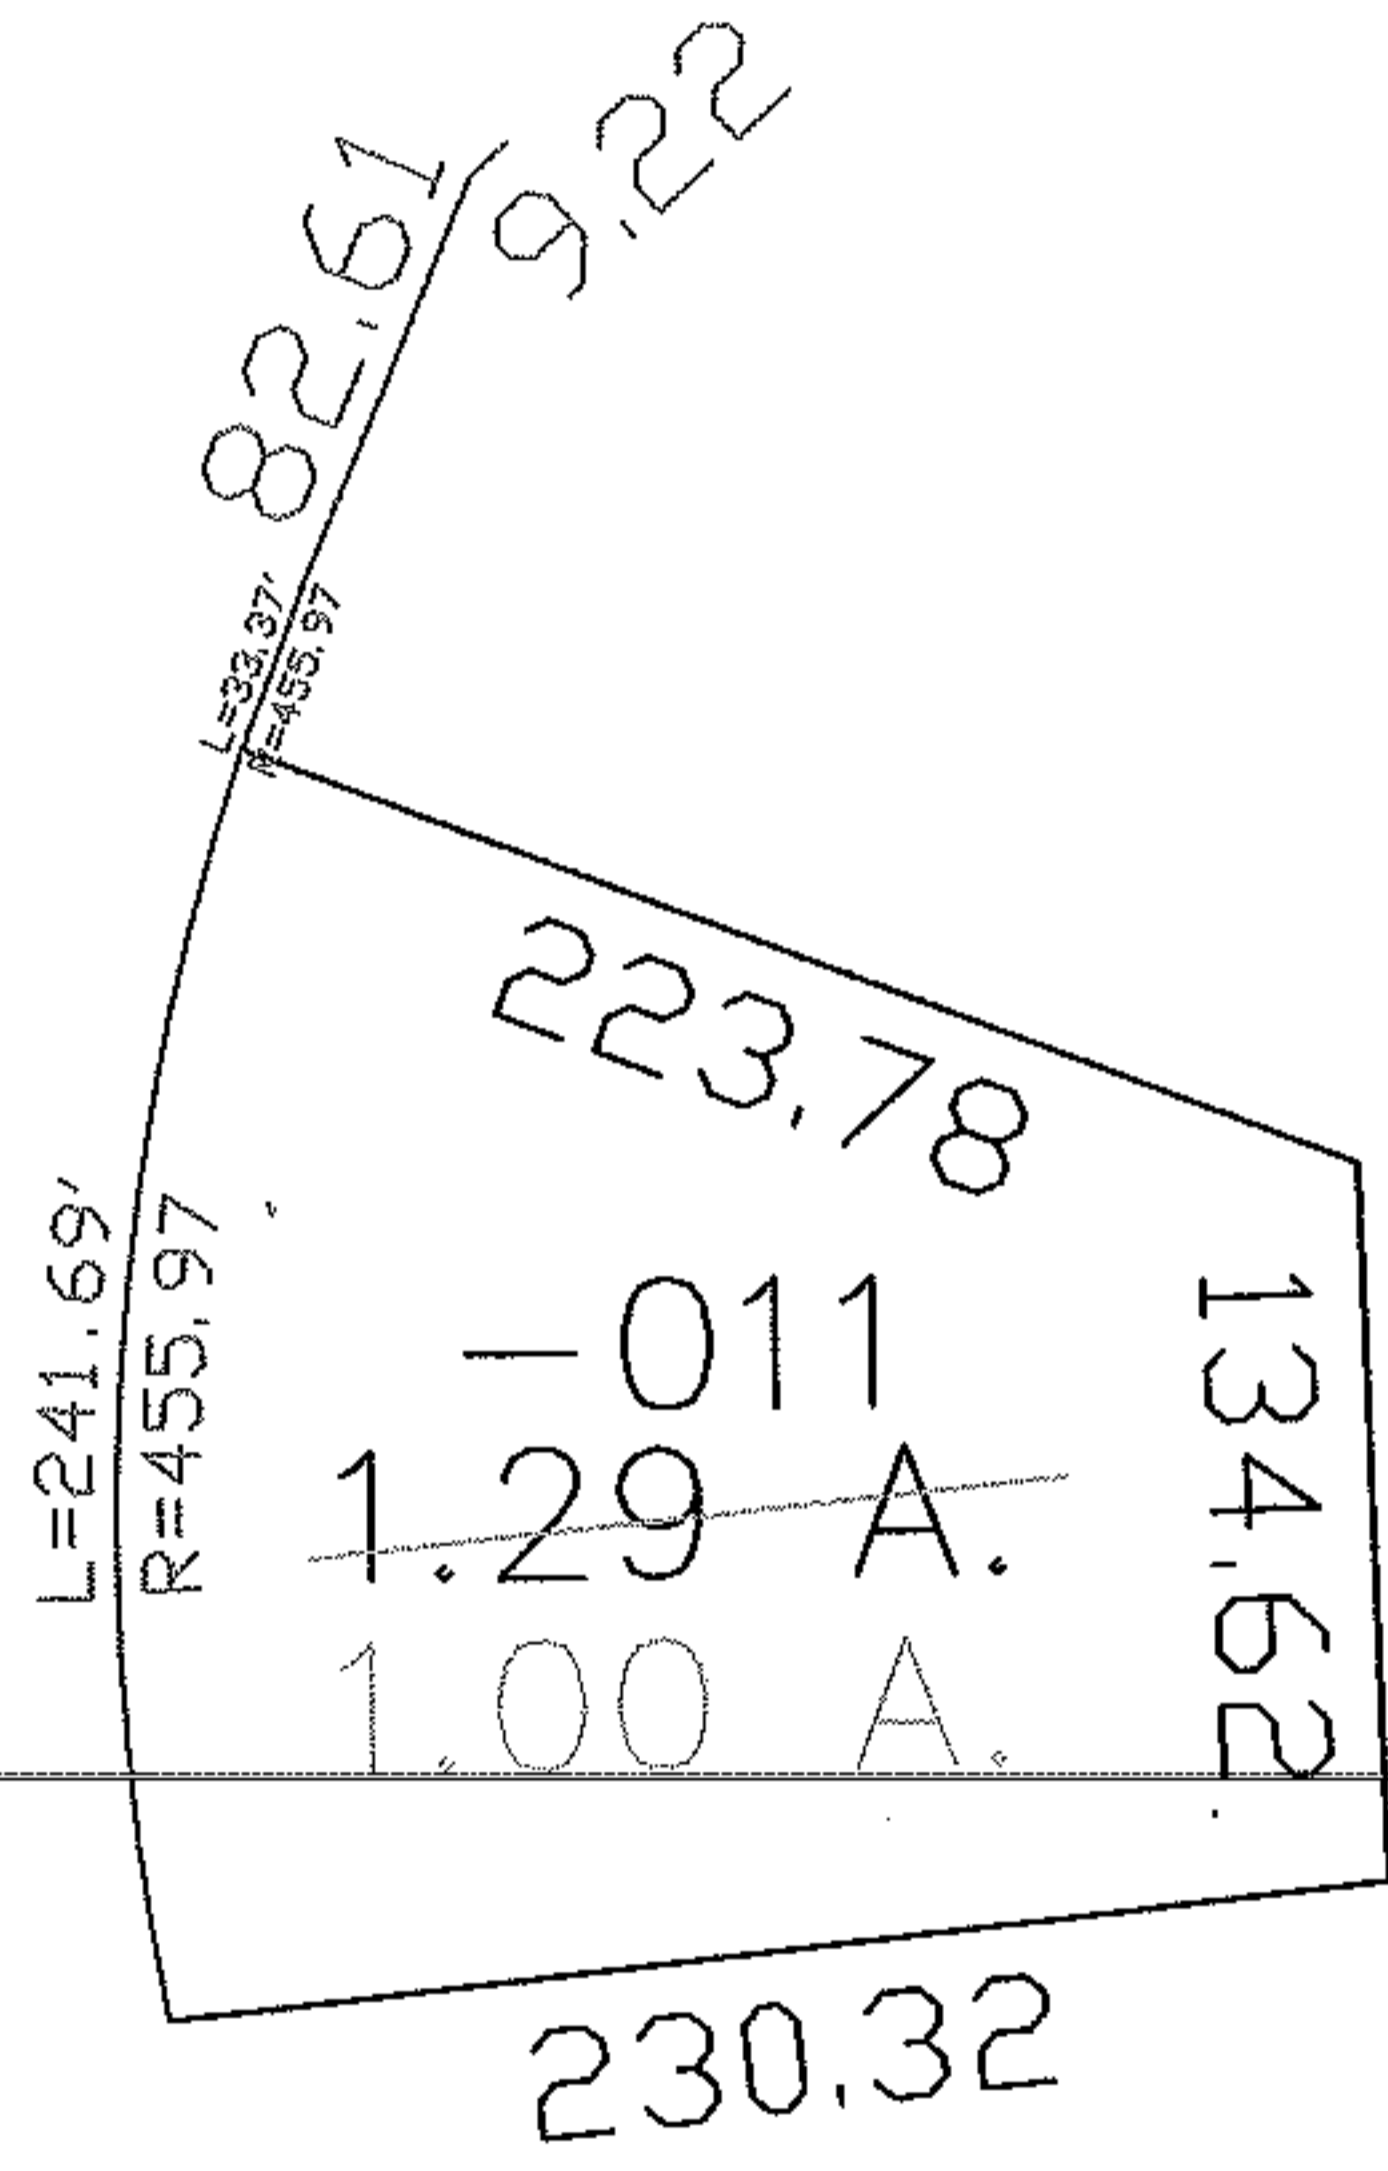

SPLITS/DEEDS PROCESSED

LORAIN COUNTY TAX MAP DEPARTMENT  
226 MIDDLE AVE. ELYRIA, OHIO

SURVEYED BY: DALE HAYWOOD  
 CLOSURE: 1:10,000  
 MAP PAGE(S): 06-99  
 APPROVED BY: DRH DATE: 9/8/2005  
 SCALE: 1"=100 PRIOR INSTRUMENT: 19970484053