


MASTER

PARENT PARCEL: 18-00-029-000-020



CHILD PARCEL: 18-00-029-000-057, -058

STARTING POINT: INT CL SR 58 AND N ROW OF MAPLE ST

05-01211-C

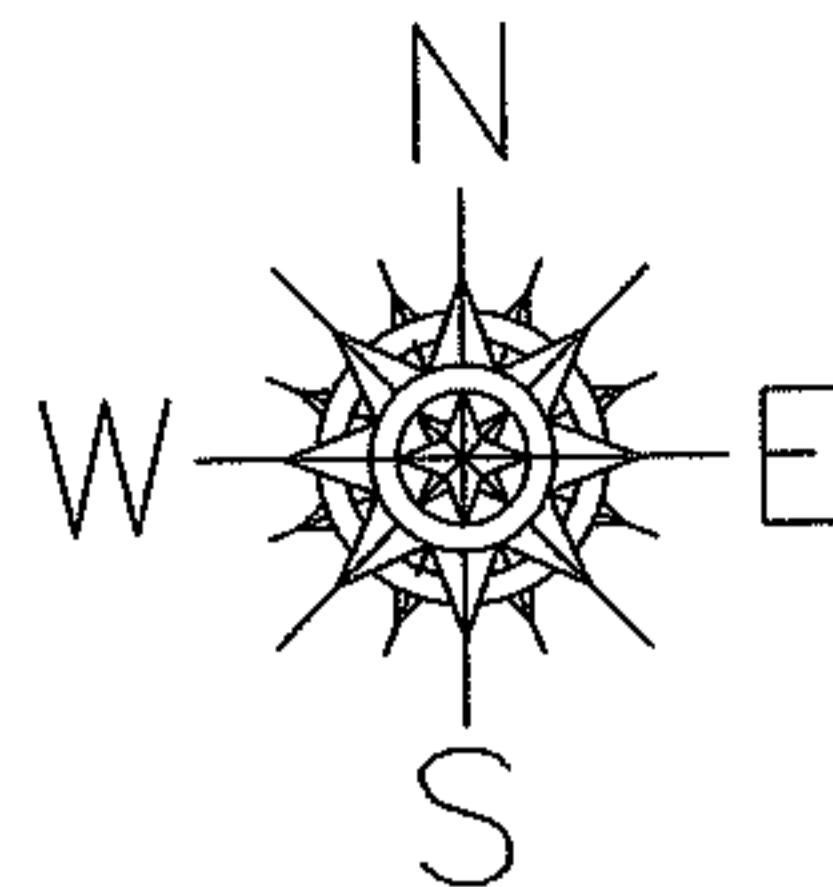

SPLIT TO
CORRECT MAPS

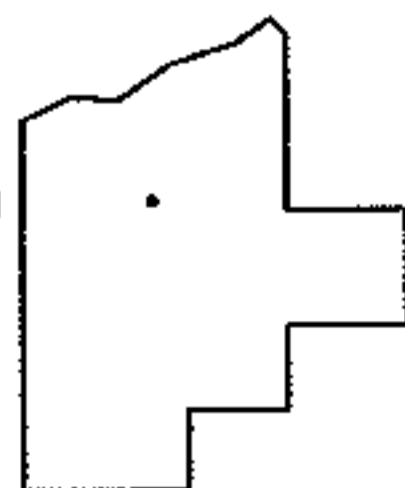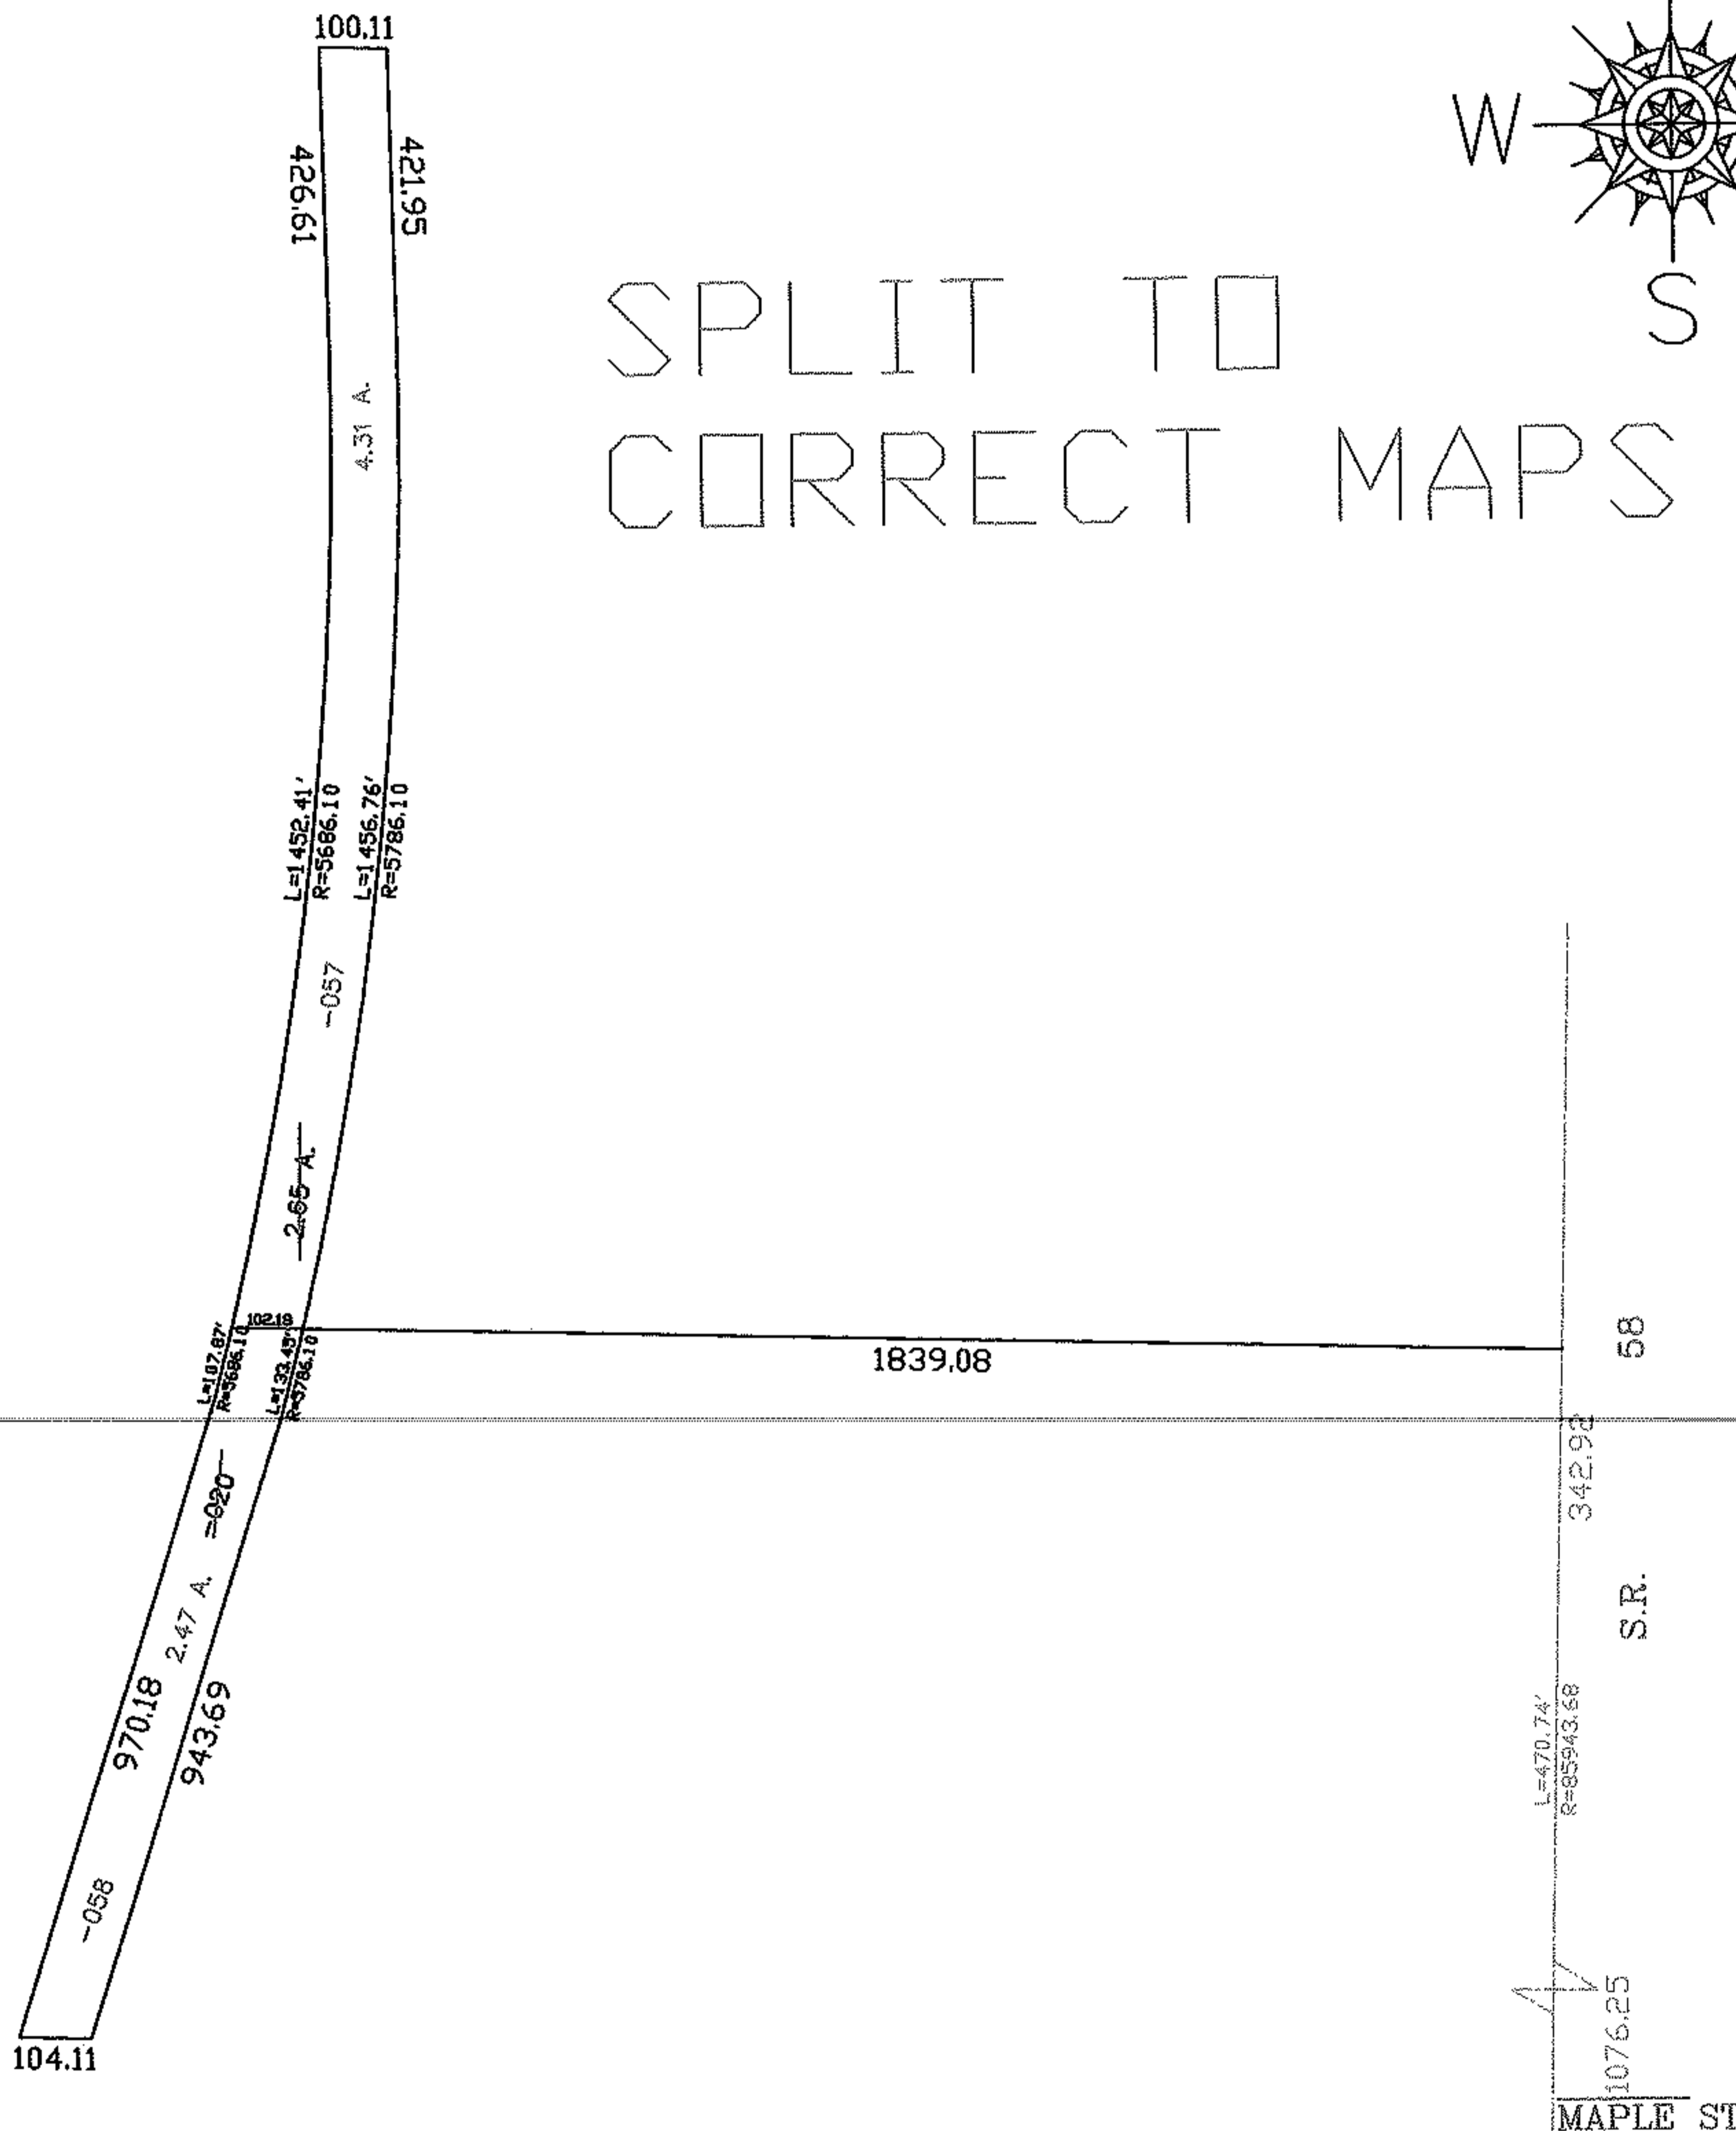

SPLITS/DEEDS PROCESSED

LORAIN COUNTY TAX MAP DEPARTMENT
226 MIDDLE AVE. ELYRIA, OHIO

SURVEYED BY: CHRISTOPHER M. HIRZEL
 CLOSURE: 1:10,000
 MAP PAGE(S): 18-00-029-B
 APPROVED BY: DRH DATE: 9/29/2005
 SCALE: 1" = 400 PRIOR INSTRUMENT: 20050057892