


EASTER

PARENT PARCEL: 05-00-024-124-037 & -038

CHILD PARCEL: 05-00-024-124-039

STARTING POINT: BEGINNING IN THE S.E. CORNER OF S\L 234

05-01217-C

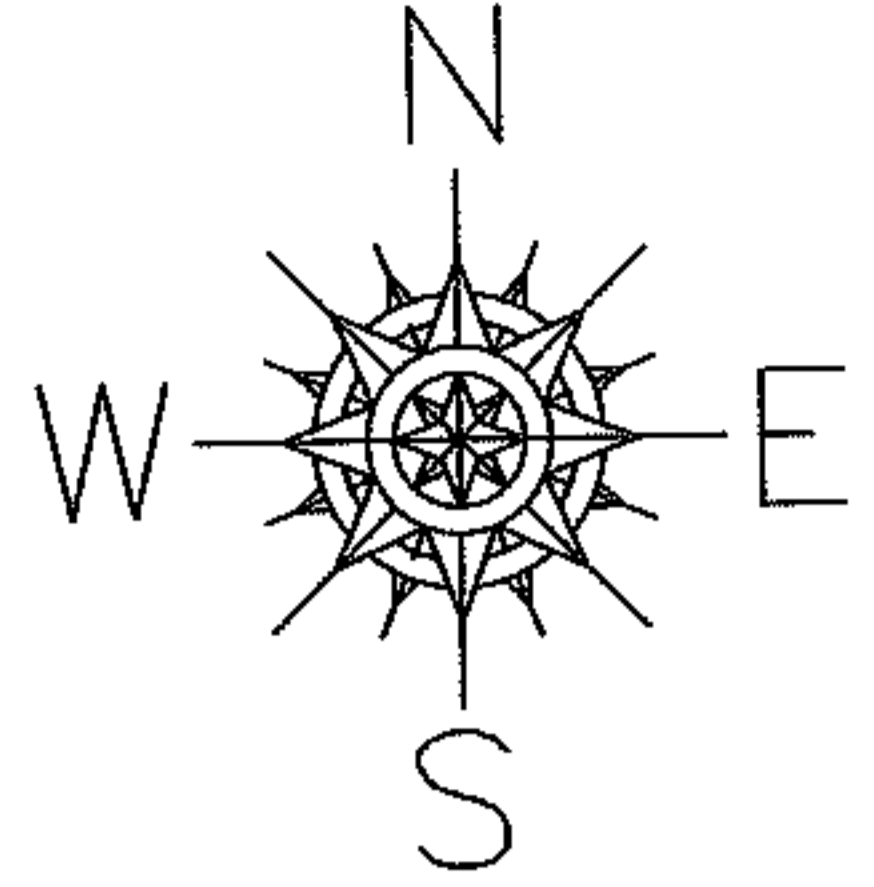



# RE-COMBINATION

~~05-00-024-124-037~~

~~05-00-024-124-038~~

05-00-024-124-039

97.50 X 96.36

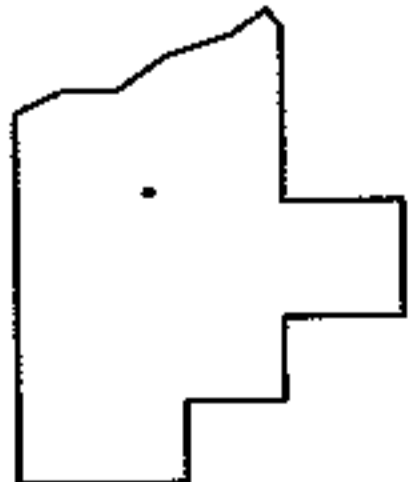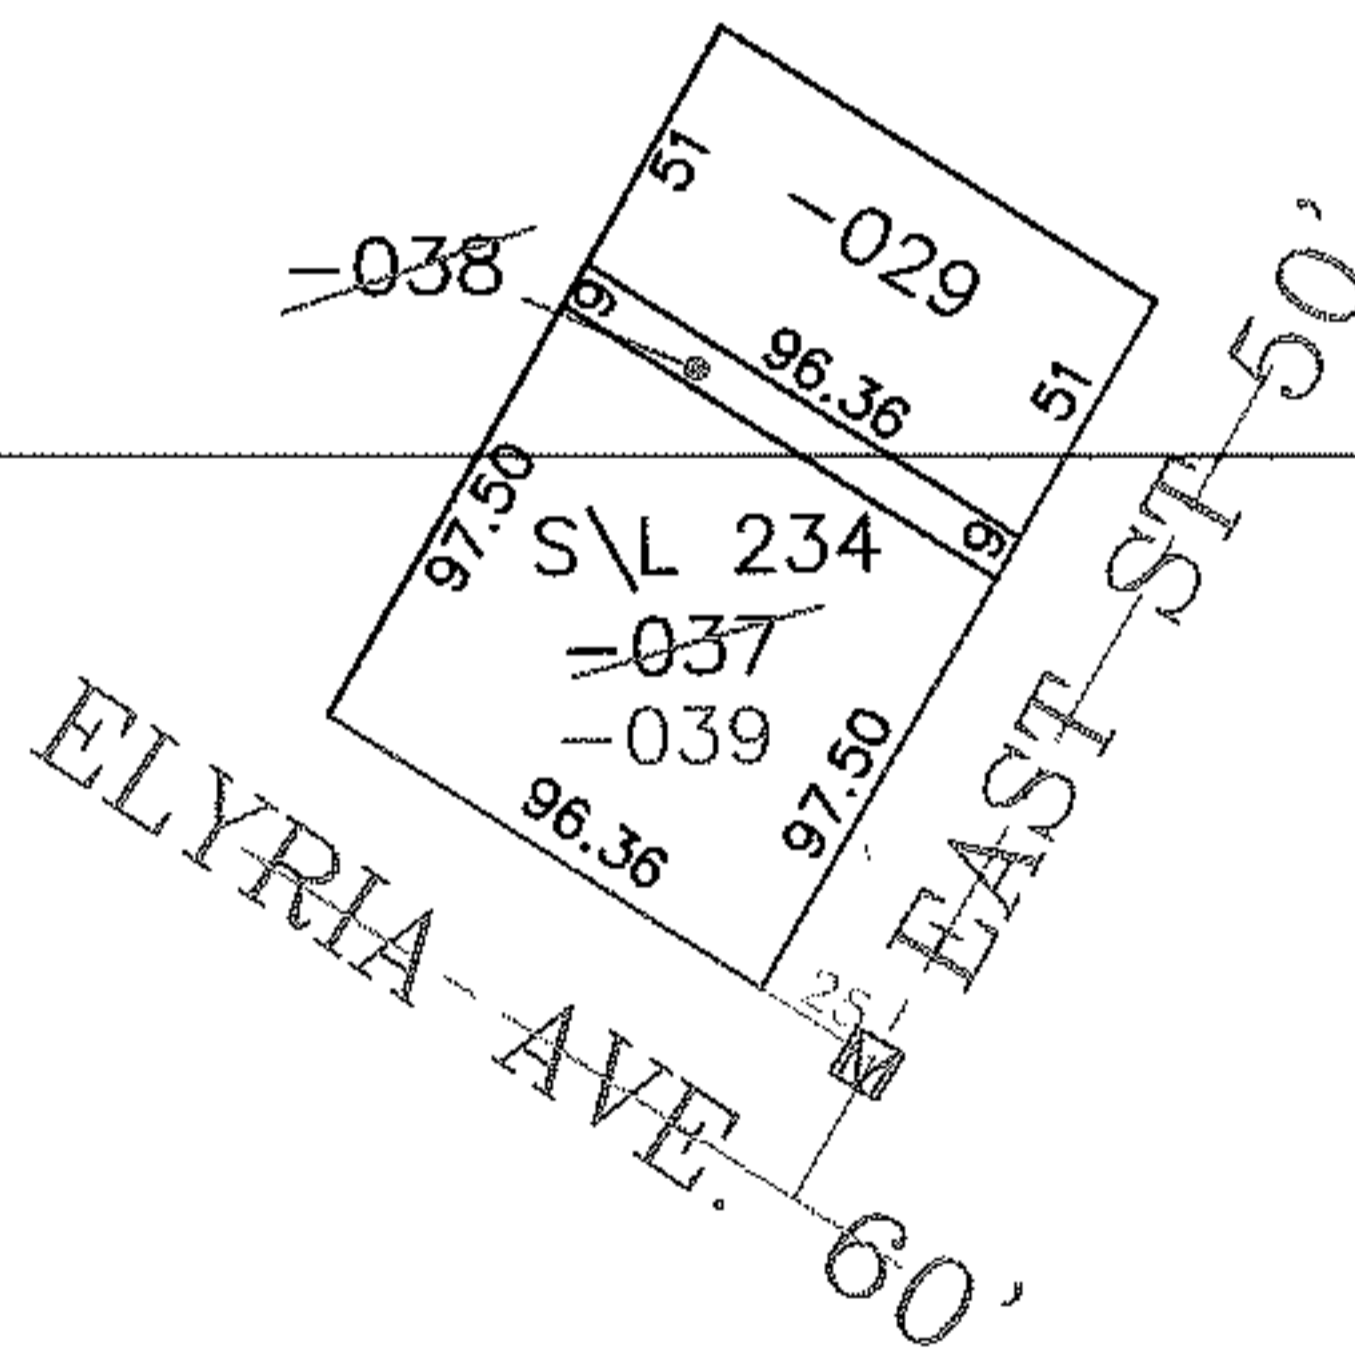

## SPLITS/DEEDS PROCESSED

LORAIN COUNTY TAX MAP DEPARTMENT  
226 MIDDLE AVE. ELYRIA, OHIO

SURVEYED BY: TIMOTHY J. FELLER

CLOSURE: 1:10,000

MAP PAGE(S): 05-00-024-B

APPROVED BY: DRH DATE: 10/13/2005

SCALE: 1"=100 PRIOR INSTRUMENT: 20000703751