




PARENT PARCEL: 13-11-011-000-013, -014

05-01220-C

CHILD PARCEL: --SAME--

STARTING POINT:

MAP ERROR CORRECTION

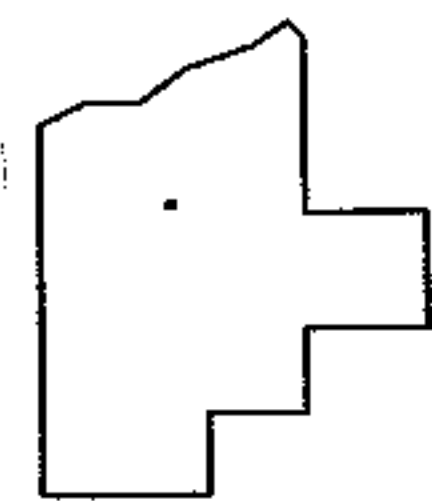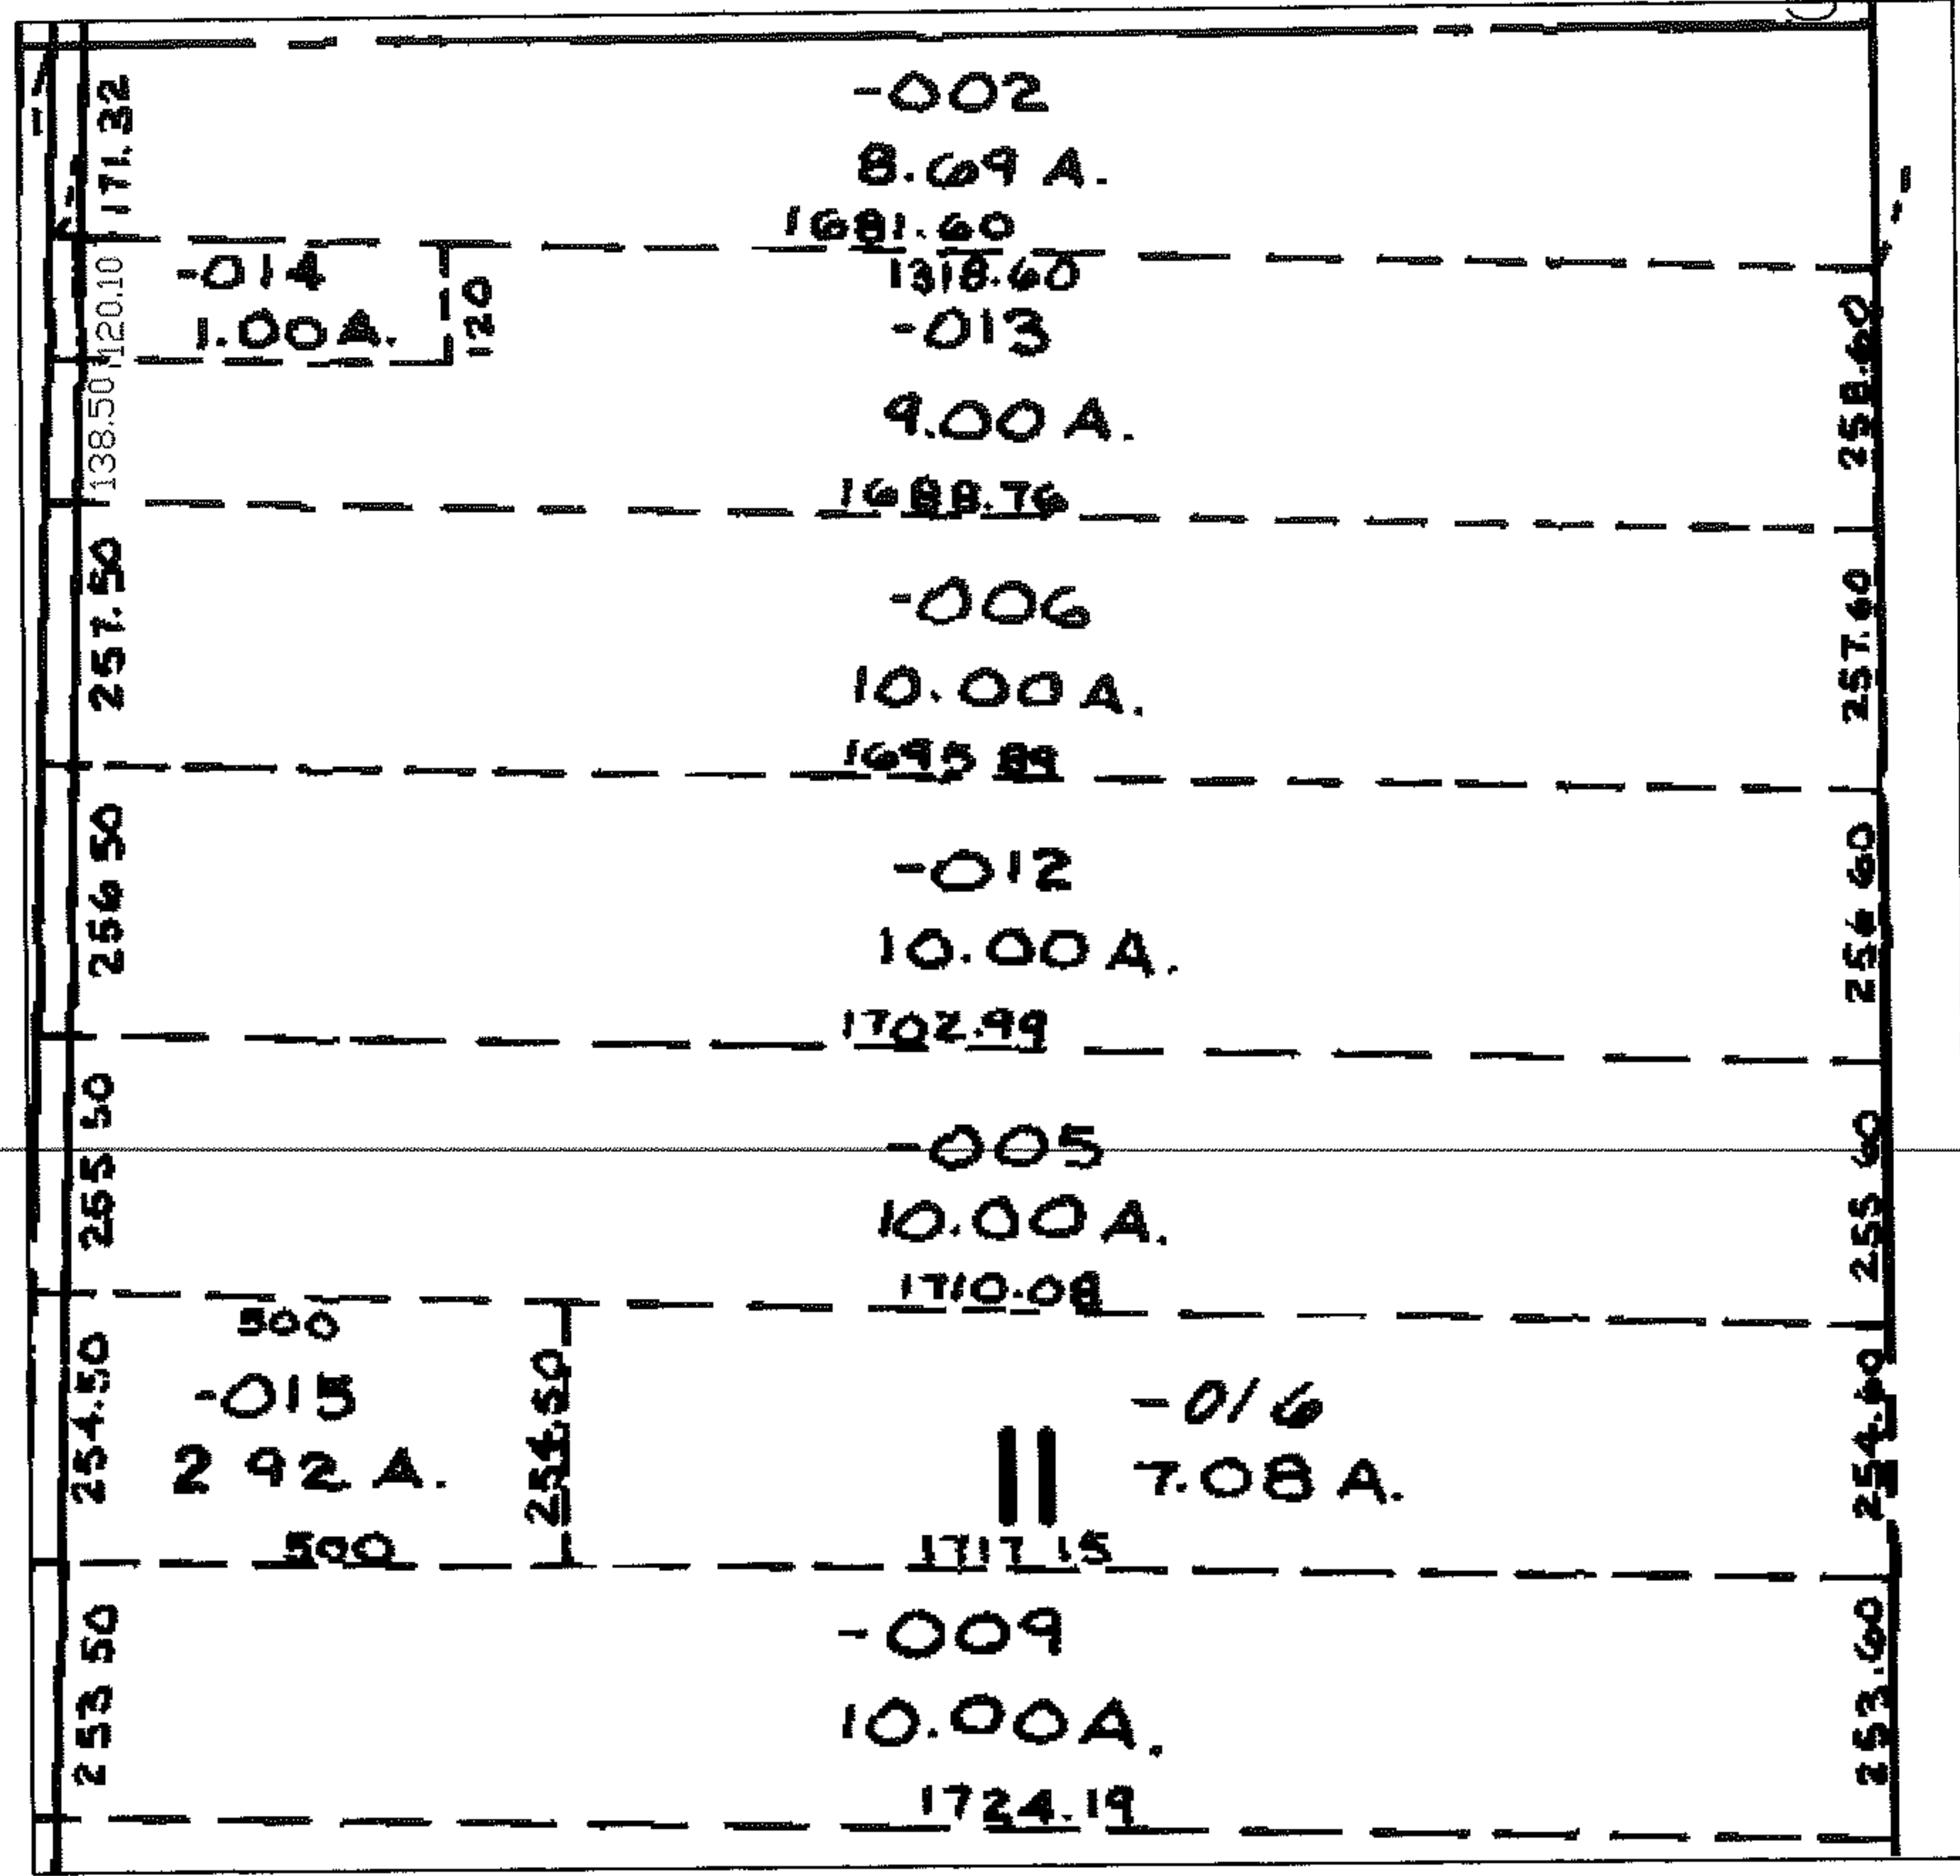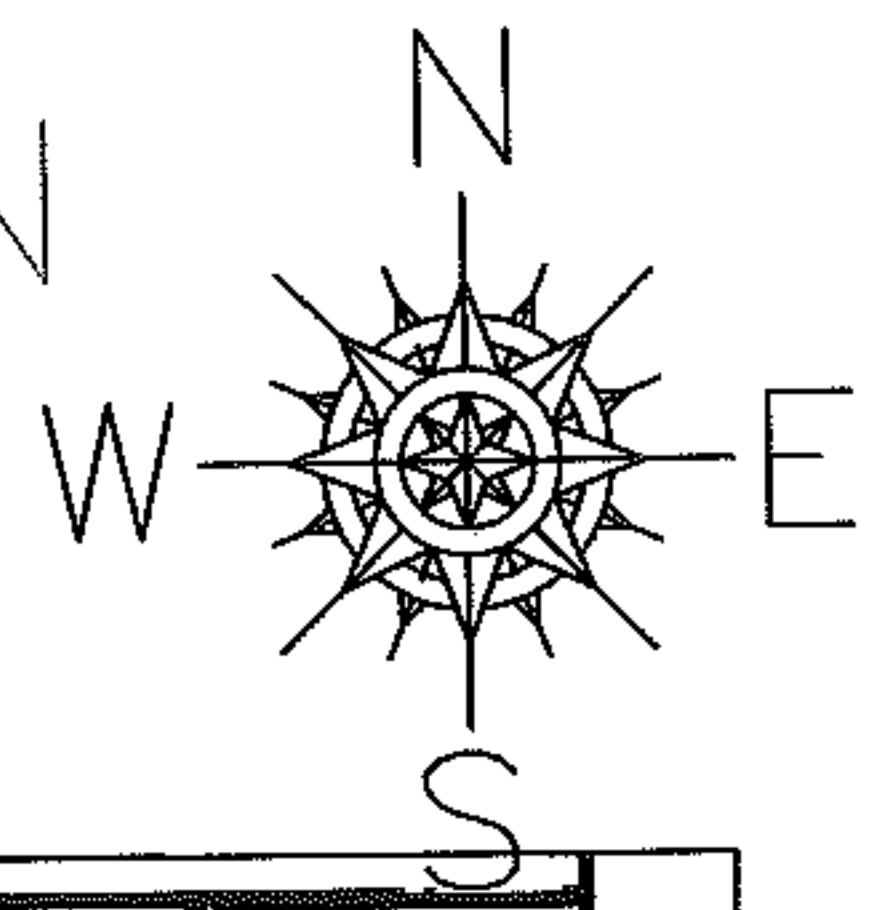

SPLITS/DEEDS PROCESSED

LORAIN COUNTY TAX MAP DEPARTMENT
226 MIDDLE AVE. ELYRIA, OHIO

SURVEYED BY: N/A
 CLOSURE: 1:10,000
 MAP PAGE(S): 13-D
 APPROVED BY: DRH DATE: 10/27/2005
 SCALE: 1" = 100 PRIOR INSTRUMENT: OR 1328/406