

RASTER




PARENT PARCEL: 05-00-020-000-121

05-01221-A

CHILD PARCEL: --SAME--

STARTING POINT: CENTERLINE OF COOPER FOSTER PARK RD. & O.L. 20

AC. CORR. PER SURVEY  
DAVID ELWELL

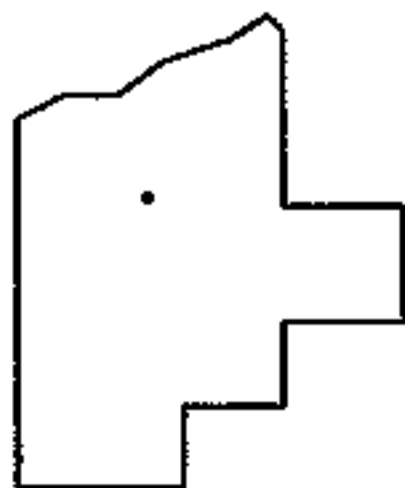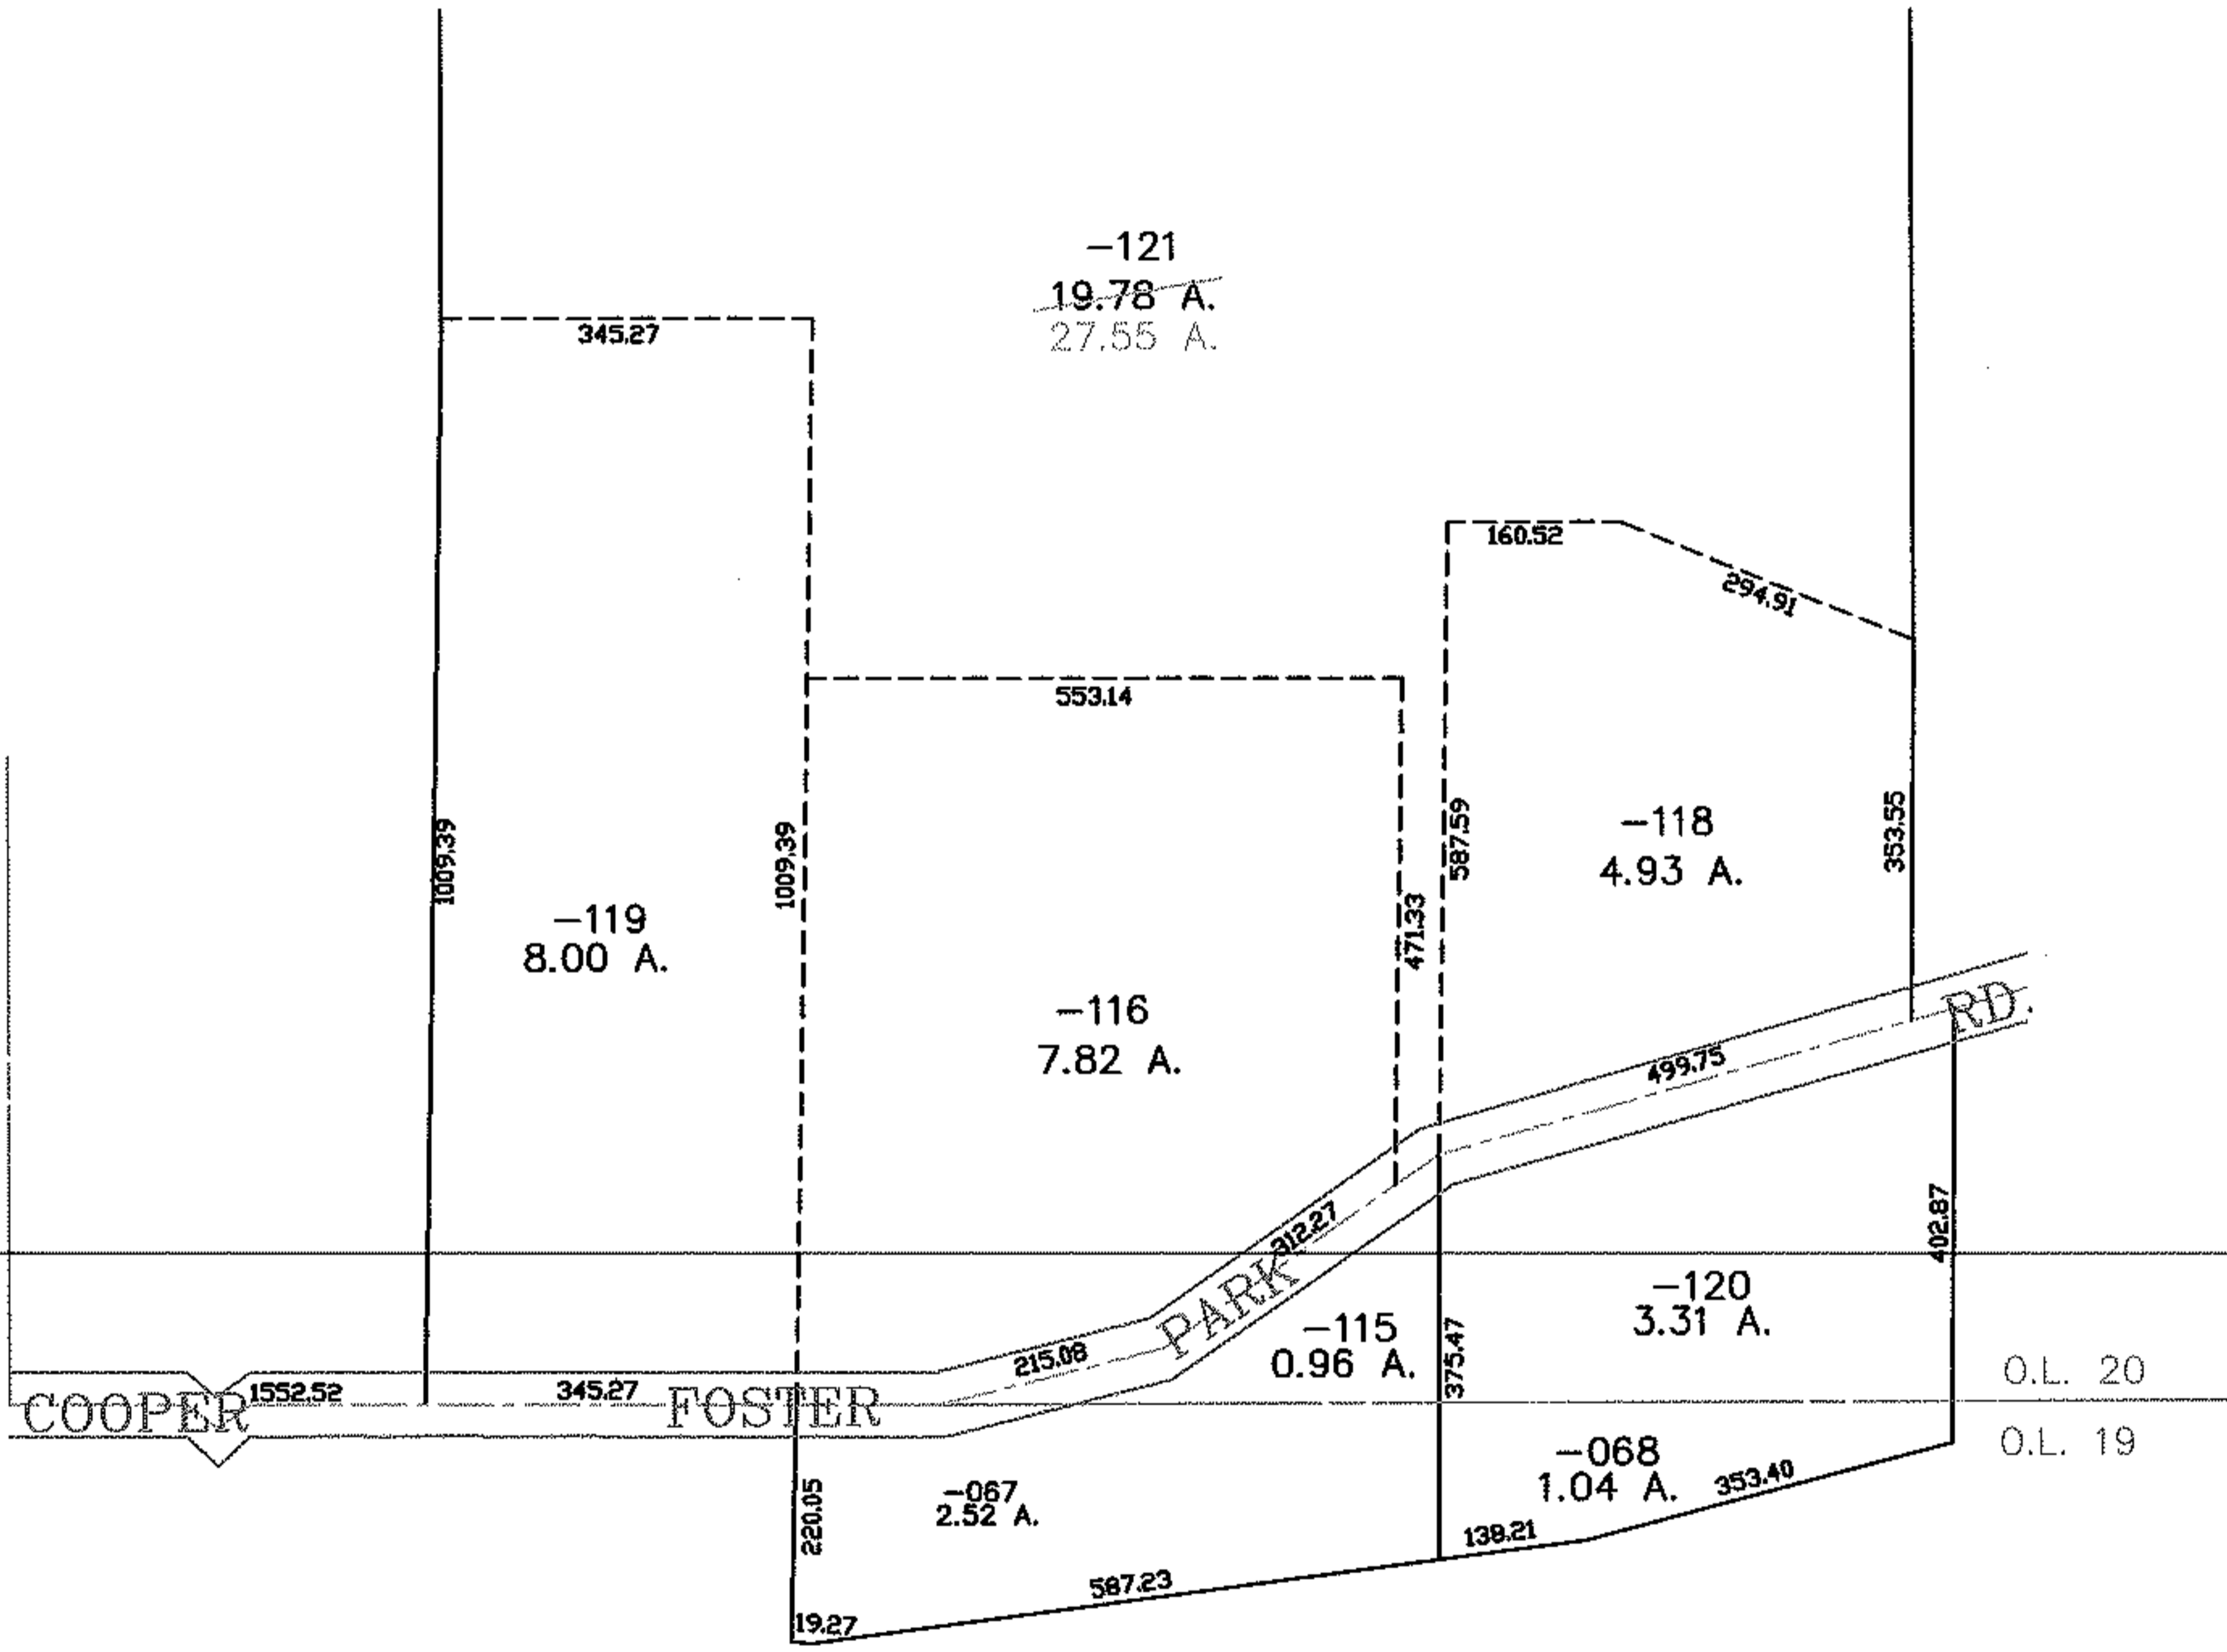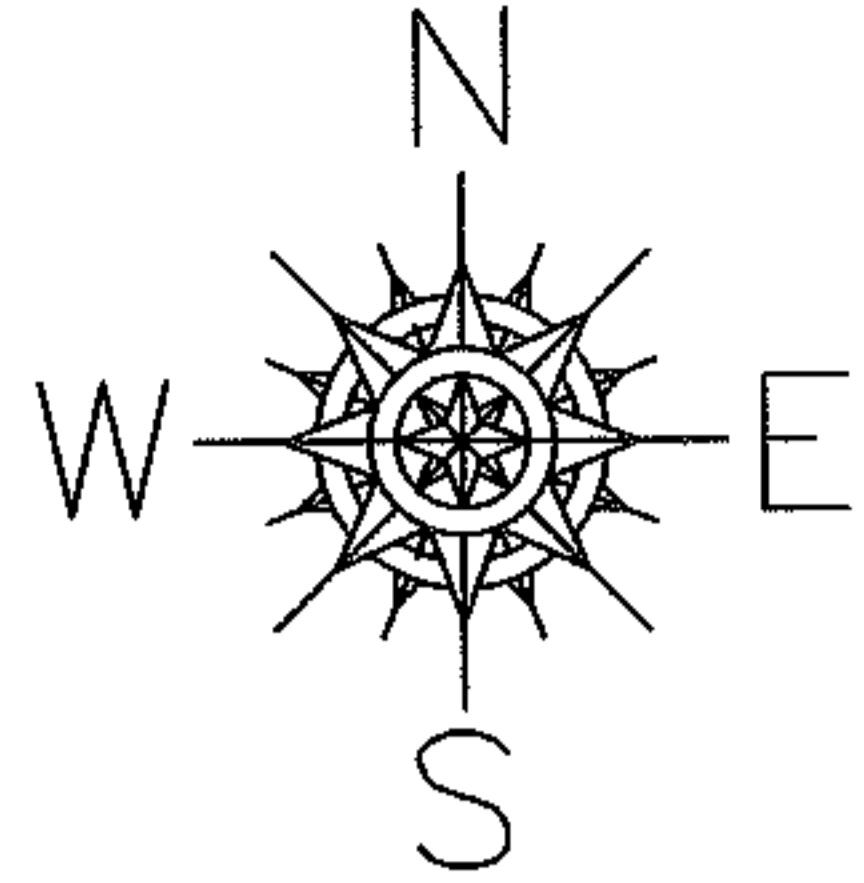

**SPLITS/DEEDS PROCESSED**

LORAIN COUNTY TAX MAP DEPARTMENT  
226 MIDDLE AVE. ELYRIA, OHIO

SURVEYED BY: DAVE ELWELL  
CLOSURE: 0.00 : 10.000  
MAP PAGE(S): 05-00-020-B  
APPROVED BY: DRH DATE: 11/2/2005  
SCALE: 1" = 300 PRIOR INSTRUMENT: 20050056726