
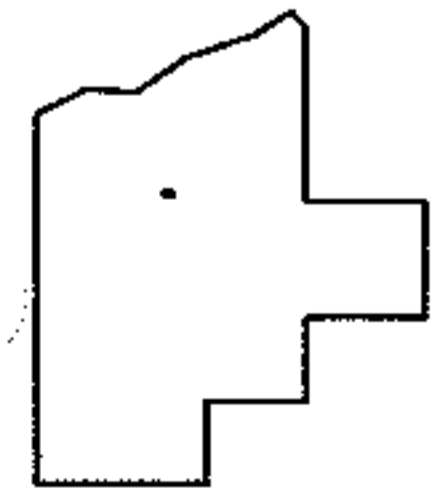
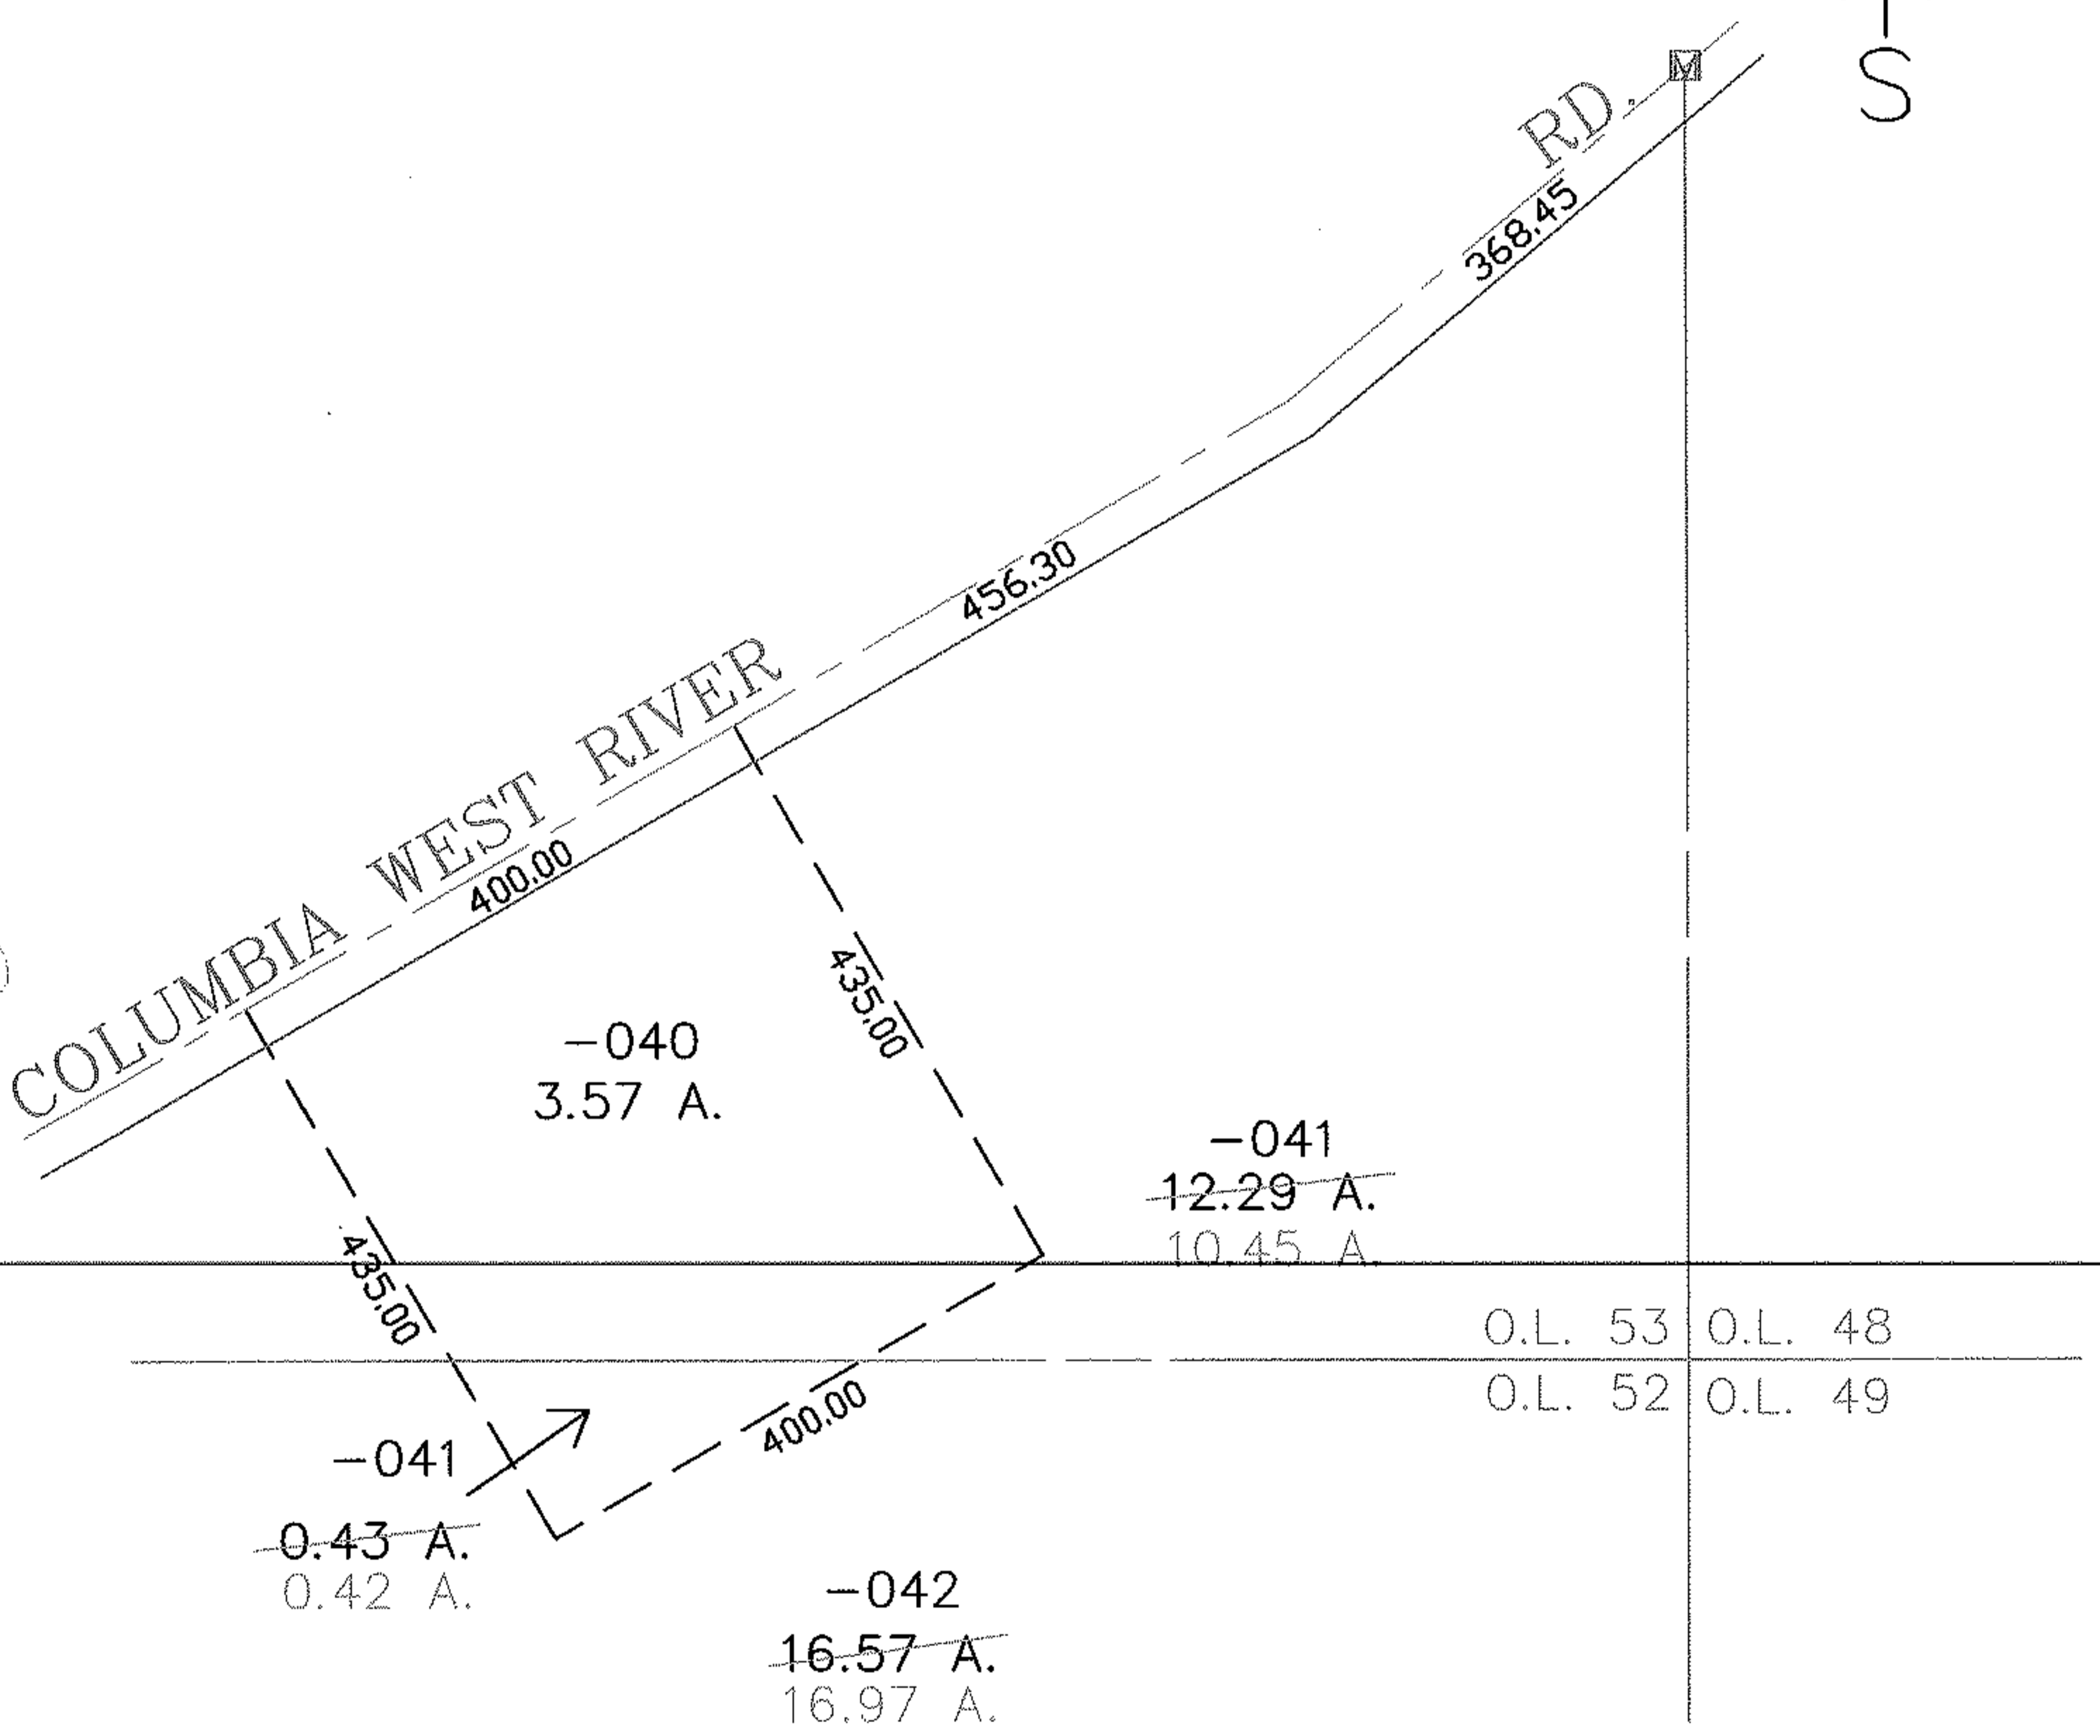


PARENT PARCEL: 12-00-053-000-041, 12-00-0562-000-041, -042

CHILD PARCEL: --SAME--

STARTING POINT: CENTERLINE OF COLUMBIA WEST RIVER RD. & O.L. 53

05-01232-C

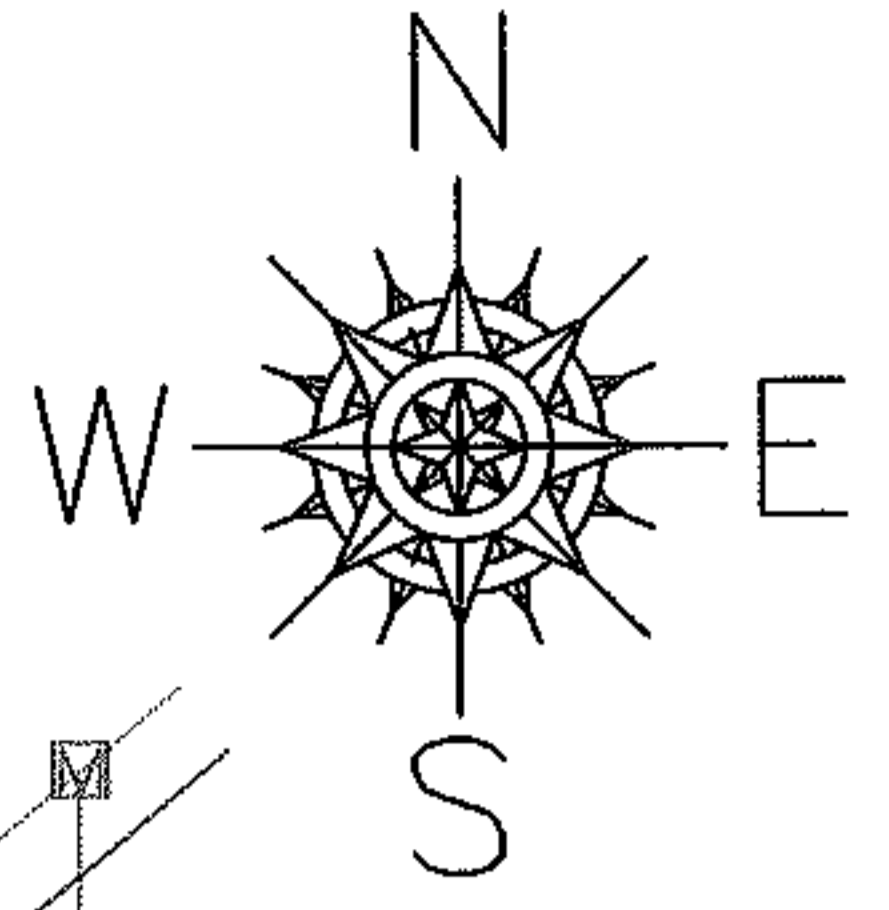

SPLITS/DEEDS PROCESSED

LORAIN COUNTY TAX MAP DEPARTMENT
226 MIDDLE AVE. ELYRIA, OHIO

SURVEYED BY: RICHARD E. HANTEL
 CLOSURE: 0.00 : 10,000
 MAP PAGE(S): 12-F
 APPROVED BY: DRH DATE: 11/21/2005
 SCALE: 1" = 200 PRIOR INSTRUMENT: 990658042